
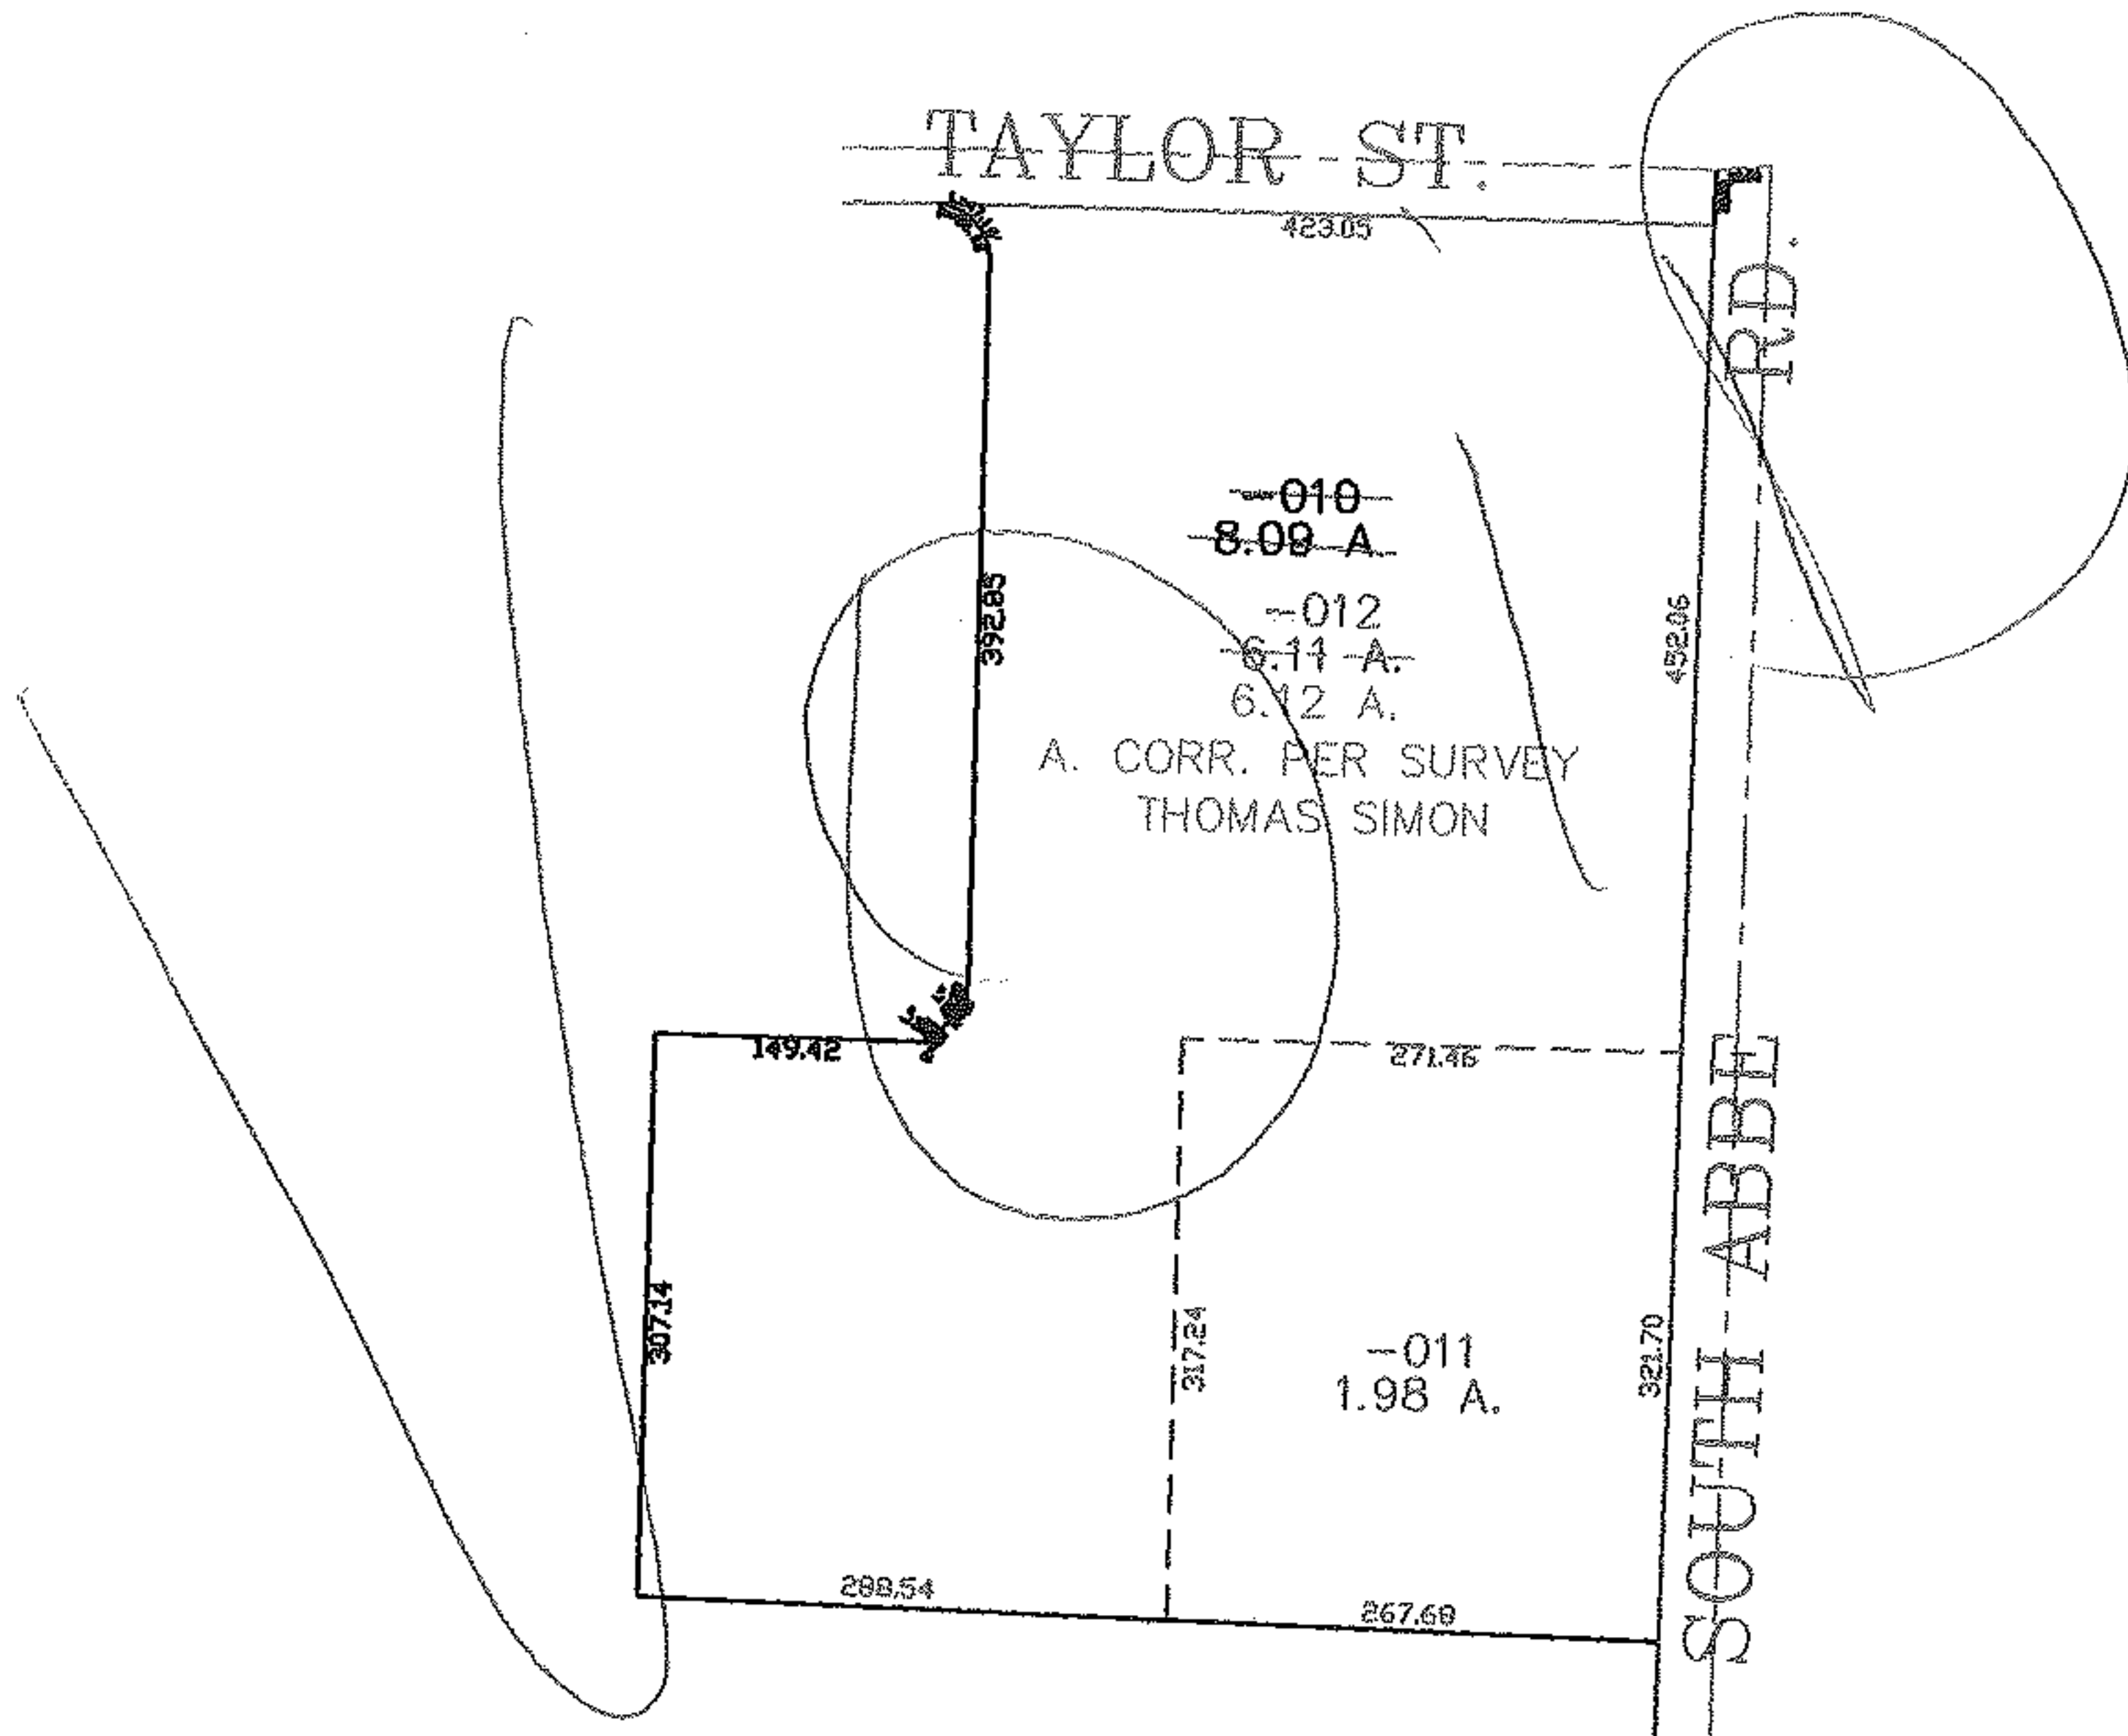


PARENT PARCEL: 06-25-012-105-010

CHILD PARCEL: 06-25-012-105-011, -012


STARTING POINT: CENTERLINE OF TAYLOR ST. & SOUTH ABBE RD.

NO. 01820

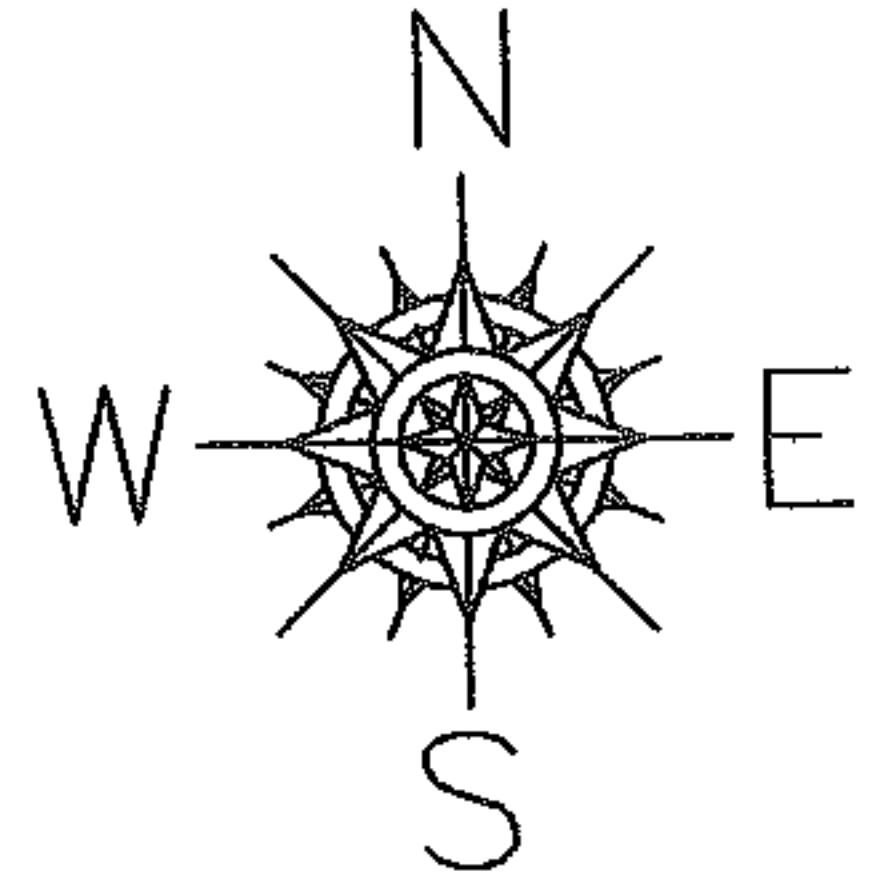

Not Recorded

*ms* 4/08

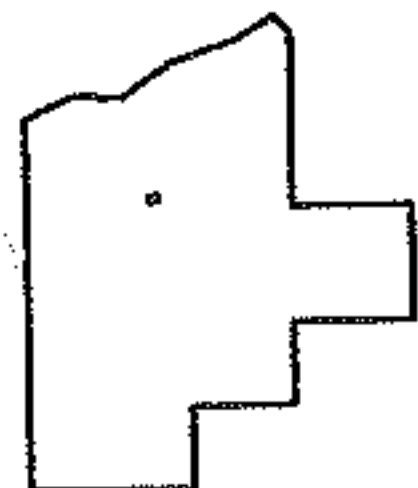

**SPLITS/DEEDS PROCESSED**  
LORAIN COUNTY TAX MAP DEPARTMENT  
226 MIDDLE AVE. ELYRIA, OHIO

SURVEYED BY:	THOMAS SIMON
CLOSURE:	0.00 : 10.000
MAP PAGE(S):	6-106
APPROVED BY:	JAH DATE: 12-20-04
SCALE:	1" = 200 PRIOR INSTRUMENT: 20040031016