




RASTER

PARENT PARCEL: 03-00-108-104-038

CHILD PARCEL: 03-00-108-104-046, -047

STARTING POINT: CENTERLINE OF BROADWAY AVE. & EAST 43RD ST.

NO. 01823

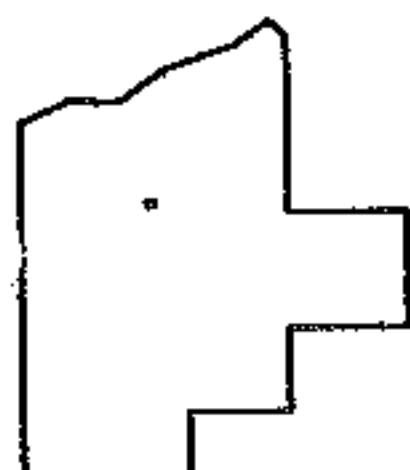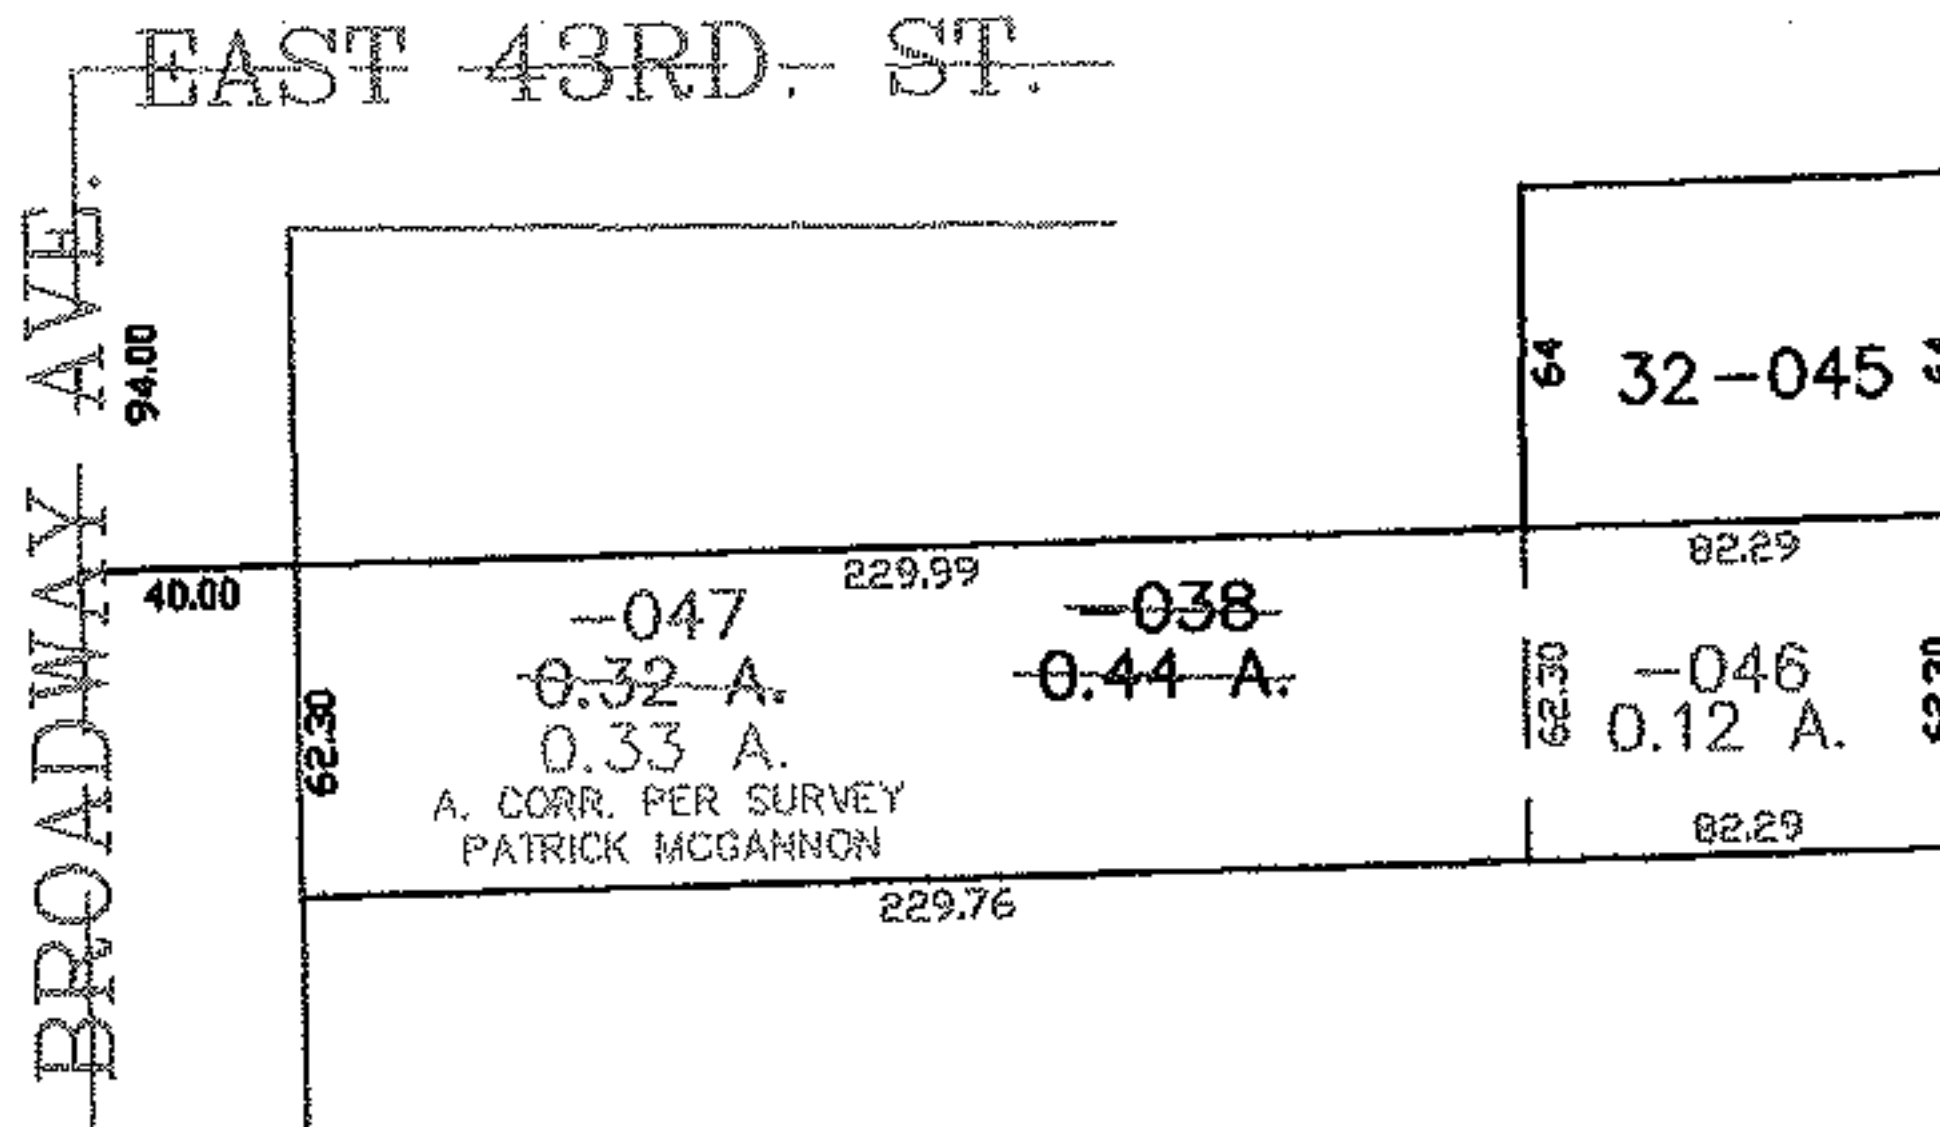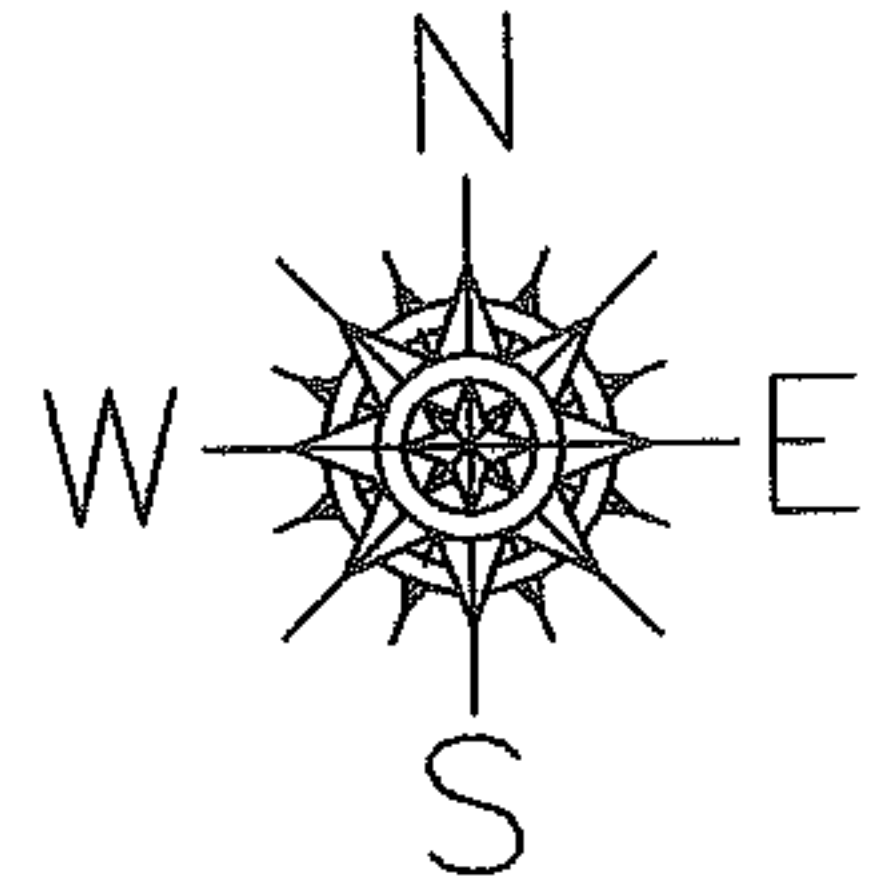

SPLITS/DEEDS PROCESSED

LORAIN COUNTY TAX MAP DEPARTMENT
226 MIDDLE AVE. ELYRIA, OHIO

SURVEYED BY: PATRICK MCGANNON

CLOSURE: 0.00 : 10.000

MAP PAGE(S): 3-00-108-A

APPROVED BY: JAH DATE: 12-21-04

SCALE: 1" = 100 PRIOR INSTRUMENT: 20040026123