


PARENT PARCEL: 10-00-013-000-204

CHILD PARCEL: --SAME--

STARTING POINT: INT CL MIDDLE AVE AND BUTTERNUT RIDGE RD



09-01825-C

AC. CORR. PER SURVEY T. SIMON

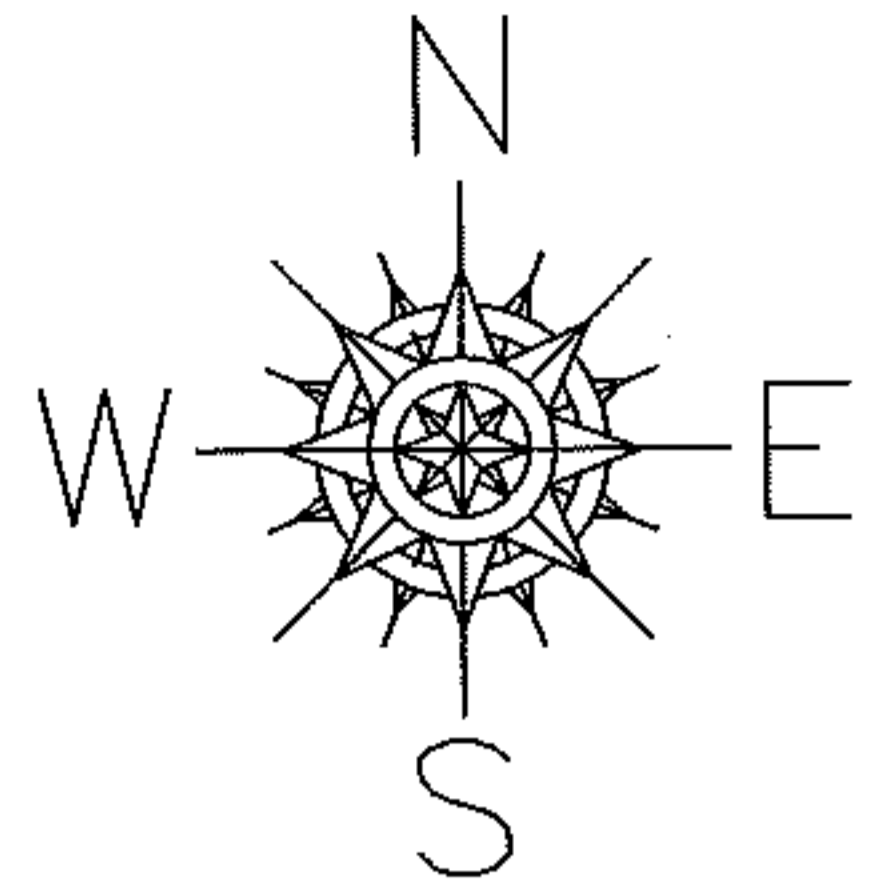

MIDDLE AVE

BUTTERNUT RIDGE RD

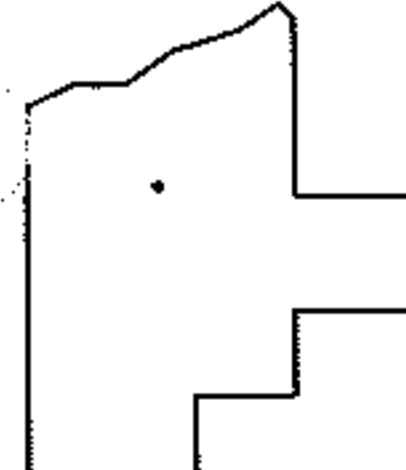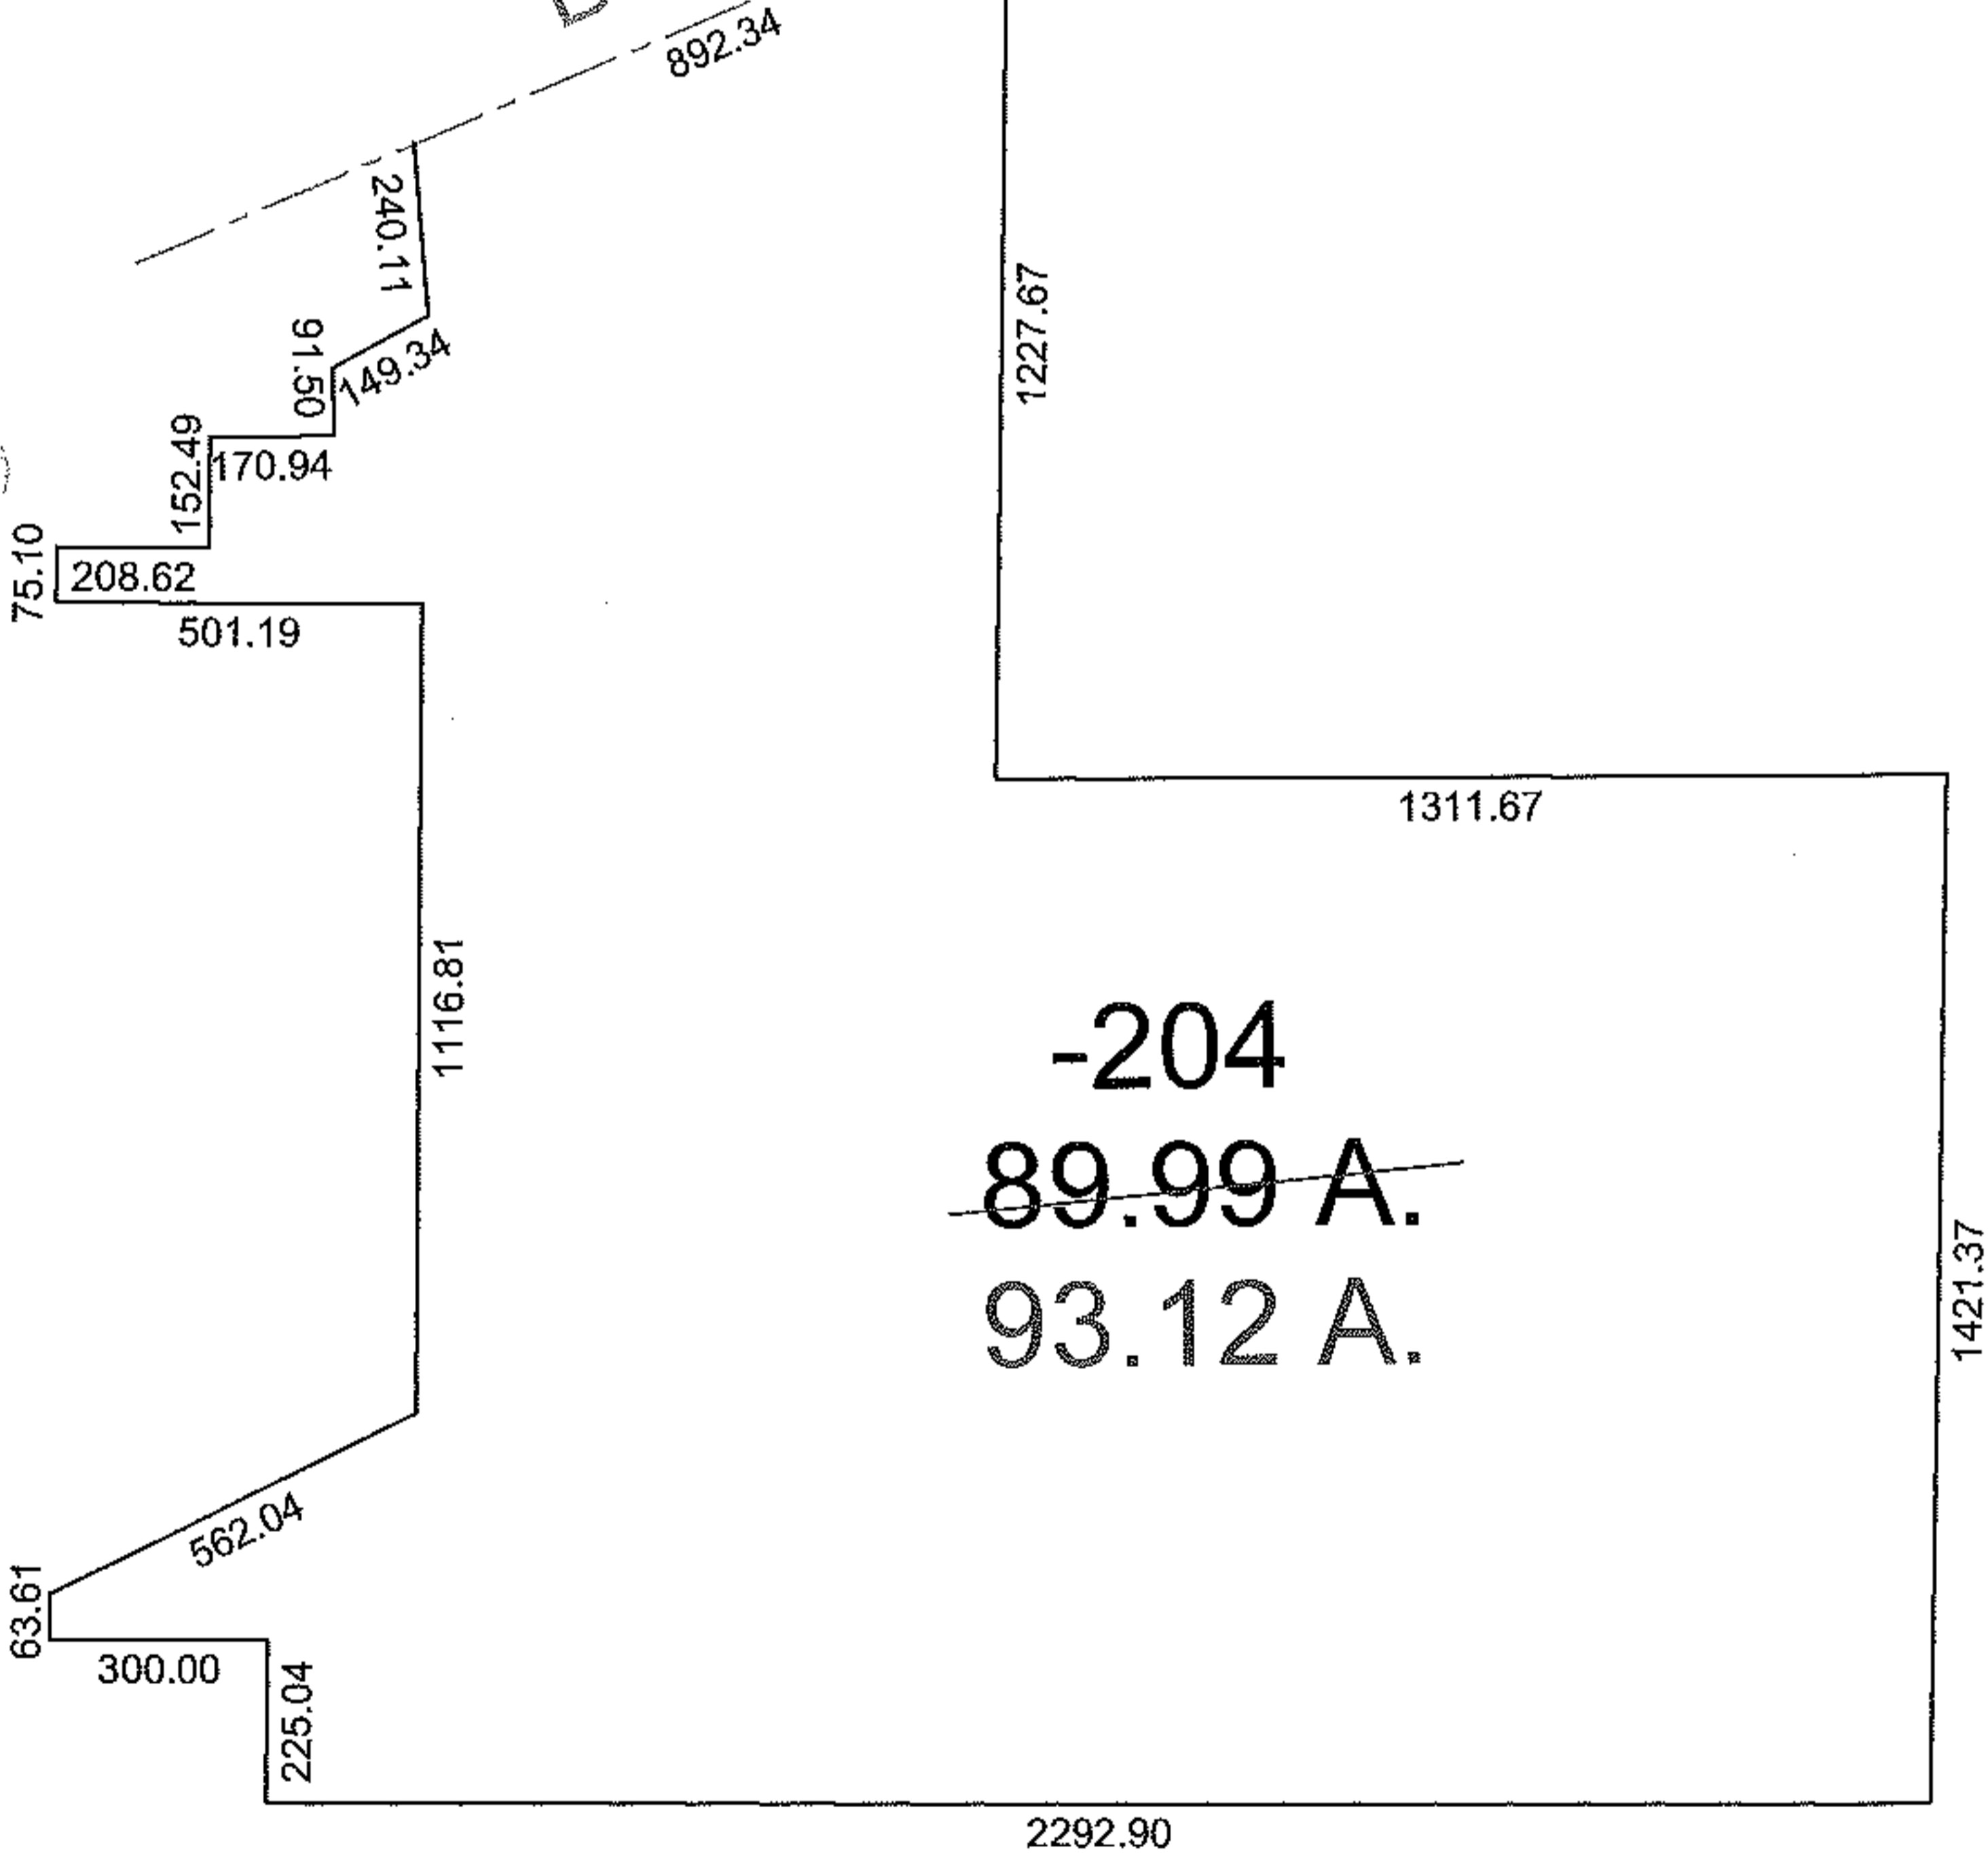

SPLITS/DEEDS PROCESSED

LORAIN COUNTY TAX MAP DEPARTMENT
226 MIDDLE AVE. ELYRIA, OHIO

SURVEYED BY: THOMAS A. SIMON

CLOSURE: 1:10,000

MAP PAGE(S): 10-00-013-H, G, C

APPROVED BY: DRH DATE: 6/5/2009

SCALE: 1" = 500 PRIOR INSTRUMENT: 1294/344