


RASTER

PARENT PARCEL: 02-01-003-260-020

CHILD PARCEL: N/A

STARTING POINT: Southerly side of W. 38th St. NW corner of Lot 74

09-01829-C

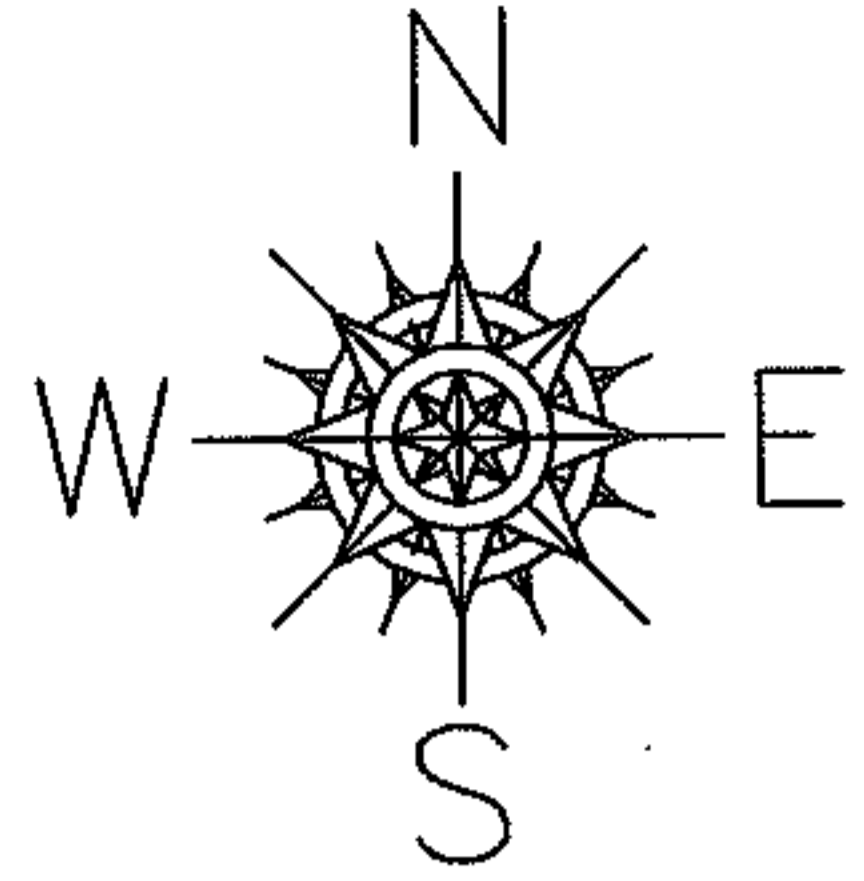

Frontage and Depth Correction

02-01-003-260-020

~~35.00x121.00~~


35.00x120.75

Dpth Corr per Deed

West 38th Street

	35.00	"	"	"
	74	73	72	71
	-020	-021	-022	-023

~~121.00~~
 120.75

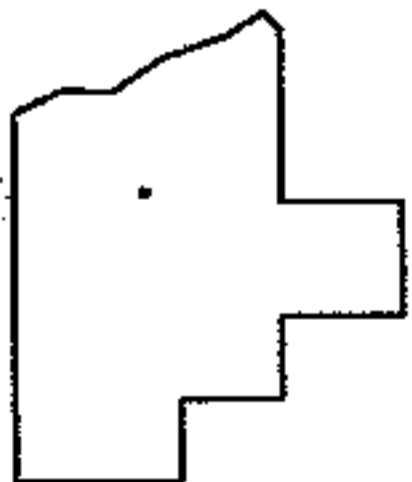

SPLITS/DEEDS PROCESSED

LORAIN COUNTY TAX MAP DEPARTMENT
226 MIDDLE AVE. ELYRIA, OHIO

SURVEYED BY: N/A

CLOSURE: 1: 311500000.00

MAP PAGE(S): 02-01-003-L

APPROVED BY: CJB DATE: 5/18/09

SCALE: 1"=50' PRIOR INST.: 20090287405