


RASTER

PARENT PARCEL: 18-00-009-000-028, -061

CHILD PARCEL: 18-00-009-000-063 THRU -067

STARTING POINT: CENTERLINE OF HAWLEY RD. & MEDINA-NORWALK RD.

NO. 01830

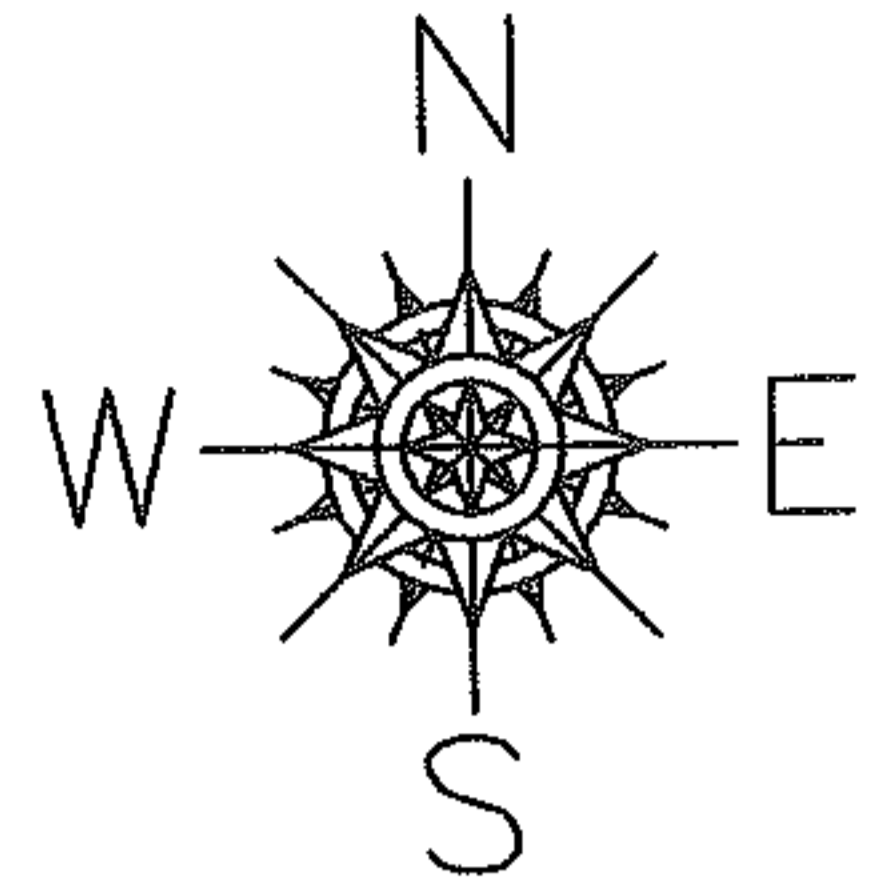

~~-061~~
~~73.45 A.~~

-066
73.40 A.

~~-065~~
~~0.05 A.~~

266.57
266.57

-067
2.00 A.

~~-028~~
~~3.95 A.~~

-064
2.00 A.

~~-063~~
~~1.95 A.~~

HAWLEY RD.

318.21

318.11

318.01

691.16

312.73

273.83

266.54

MEDINA-NORWALK

RD.



SPLITS/DEEDS PROCESSED

LORAIN COUNTY TAX MAP DEPARTMENT
226 MIDDLE AVE. ELYRIA, OHIO

SURVEYED BY: ALEX KELSER

CLOSURE: 0.00 : 10.000

MAP PAGE(S): 18-00-009-C

APPROVED BY: JAH DATE: 1-6-05

SCALE: 1" = 100 PRIOR INSTRUMENT: DV 1350/861