
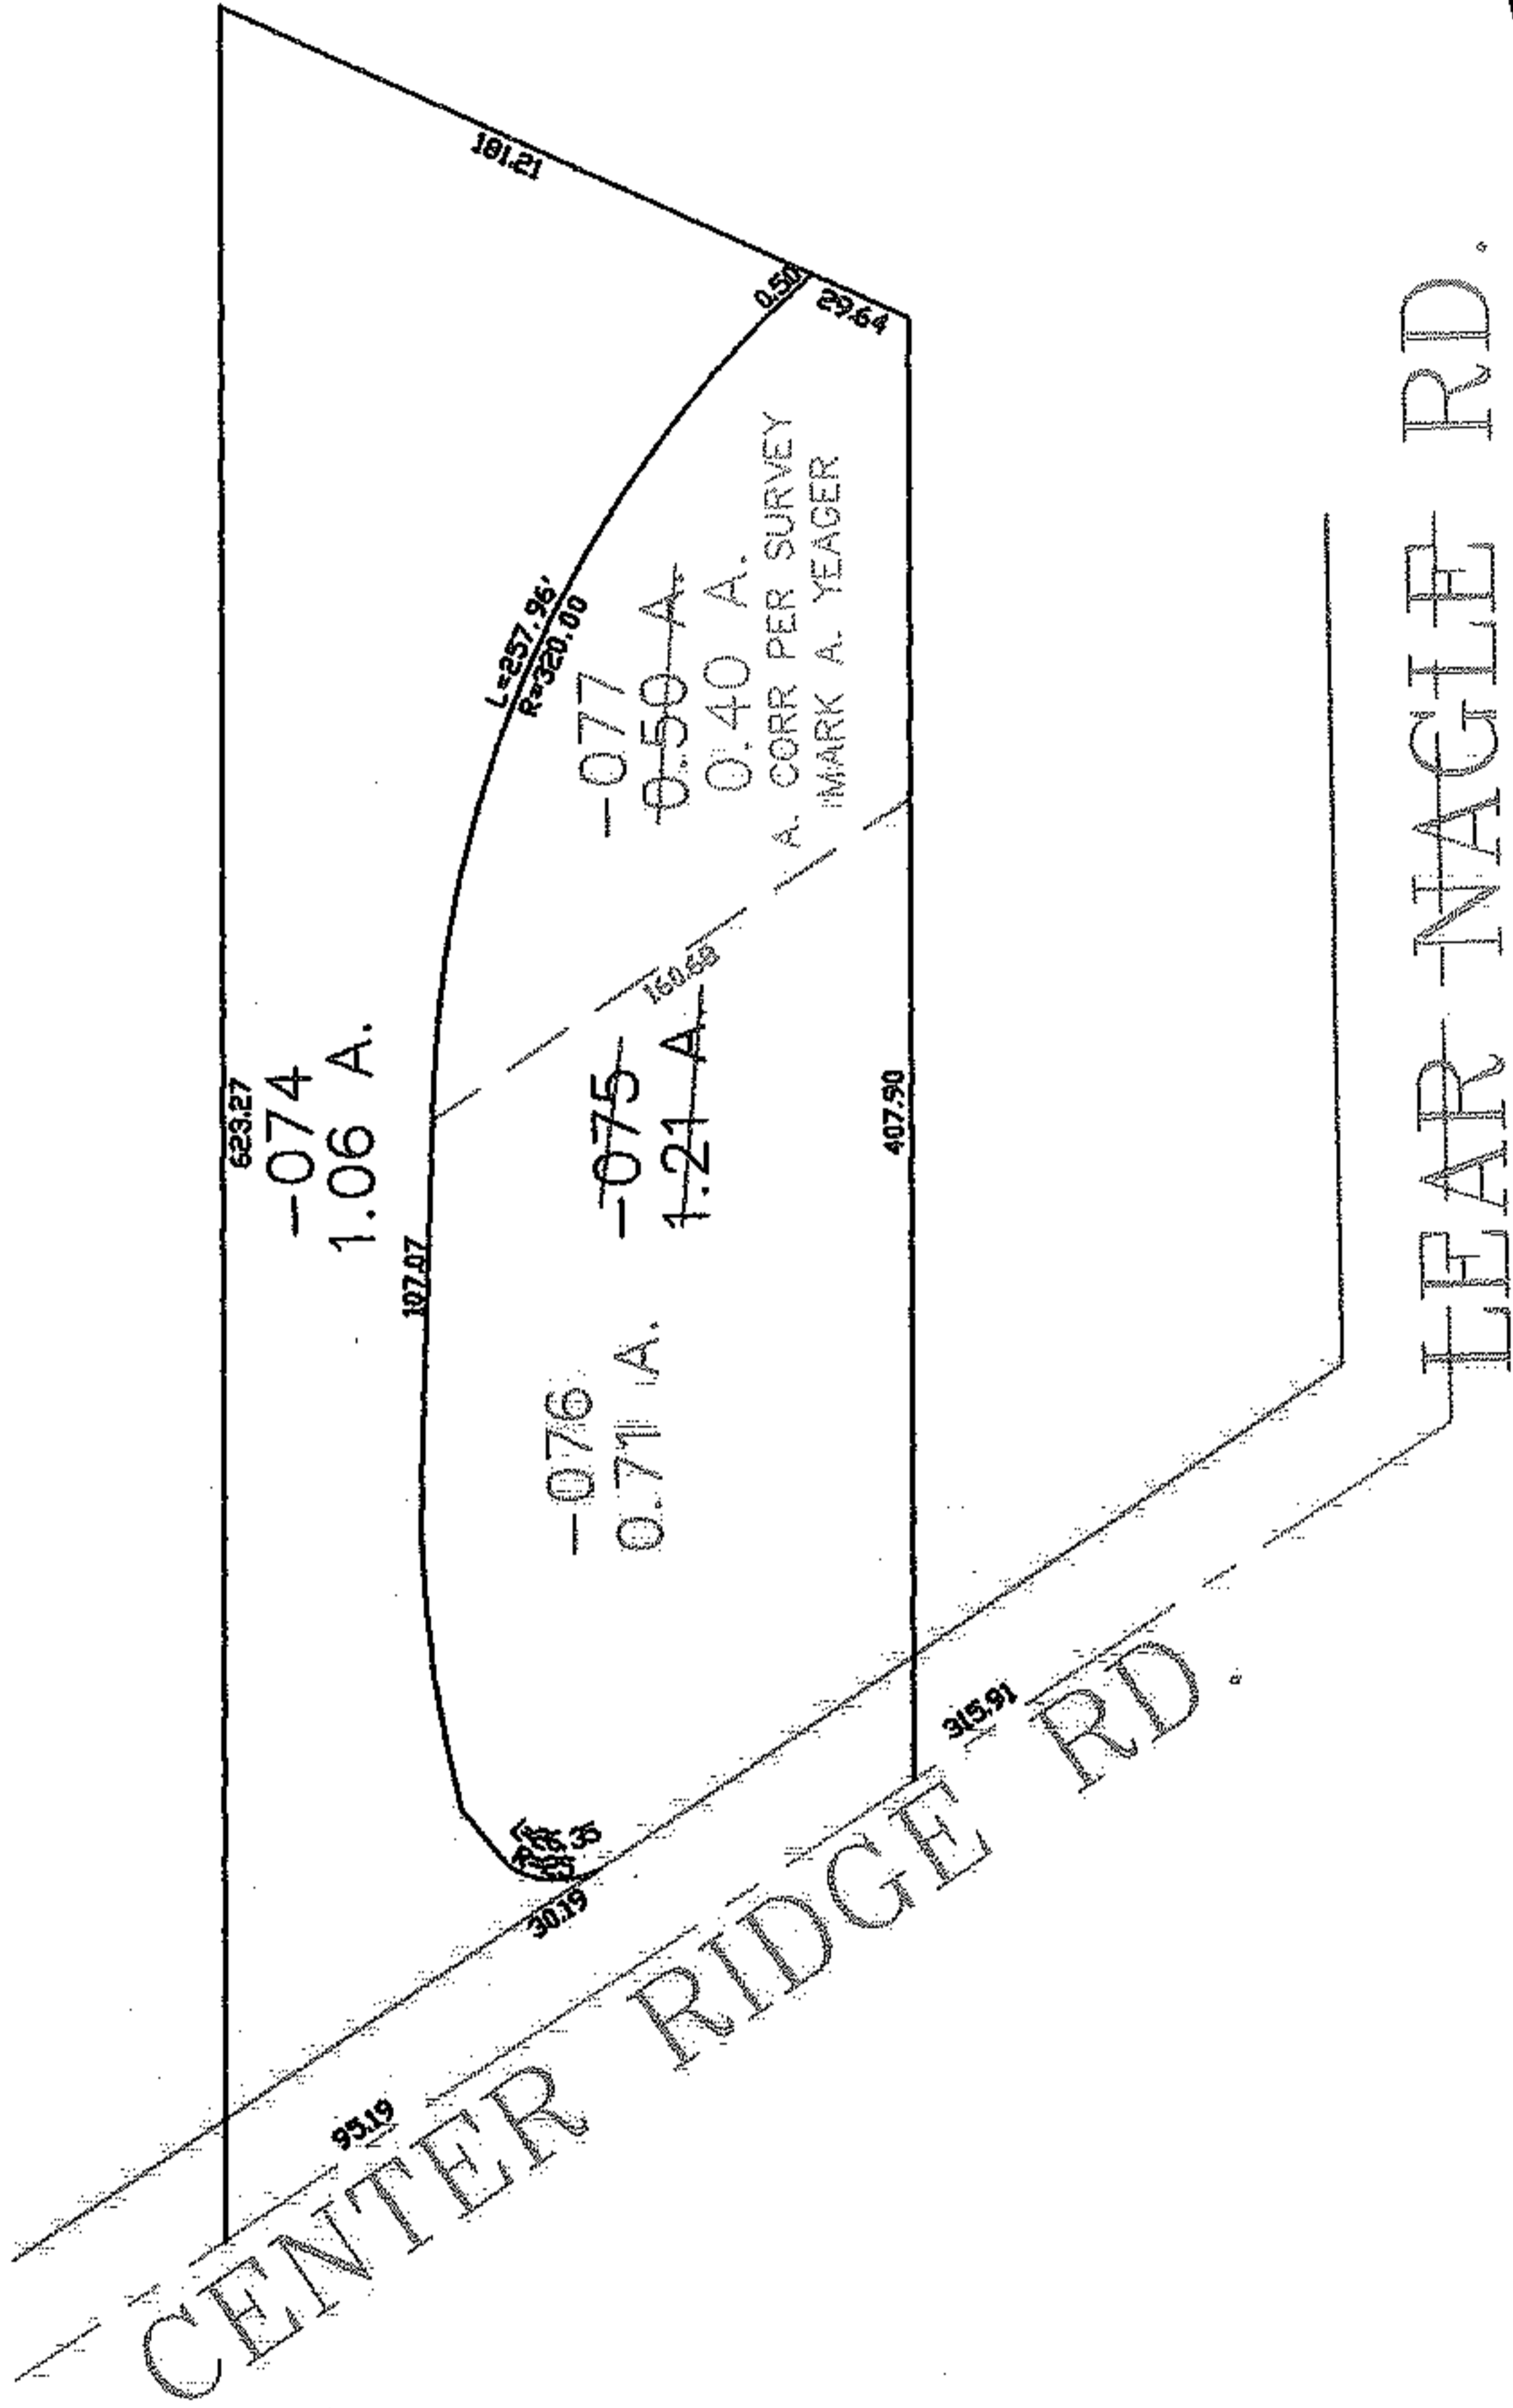


PARENT PARCEL: 07-00-008-117-075

CHILD PARCEL: 07-00-008-117-076, -077

STARTING POINT: CENTERLINE OF CENTERRIDGE RD. & LEAR NAGLE RD.

NO. 01833

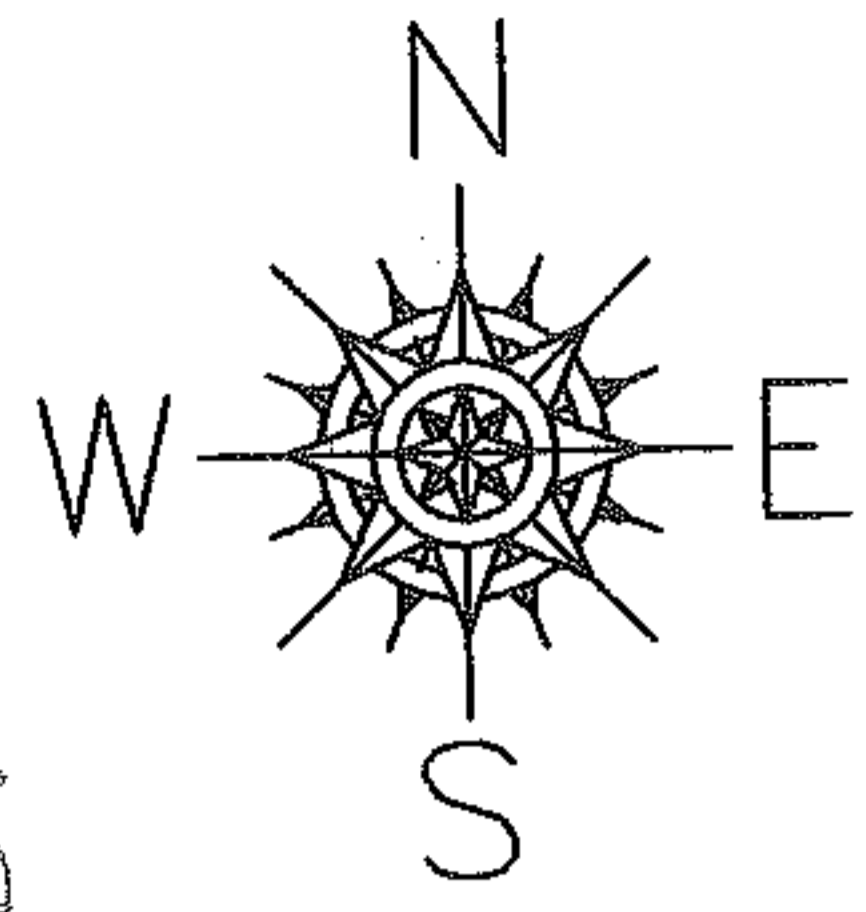

SPLITS/DEEDS PROCESSED

LORAIN COUNTY TAX MAP DEPARTMENT
226 MIDDLE AVE. ELYRIA, OHIO

SURVEYED BY: MARK A YEAGER
 CLOSURE: 0.00 : 10.000
 MAP PAGE(S): 07-00-008-C
 APPROVED BY: JAH DATE: 1-10-05
 SCALE: 1" = 100 PRIOR INSTRUMENT: 990600272