
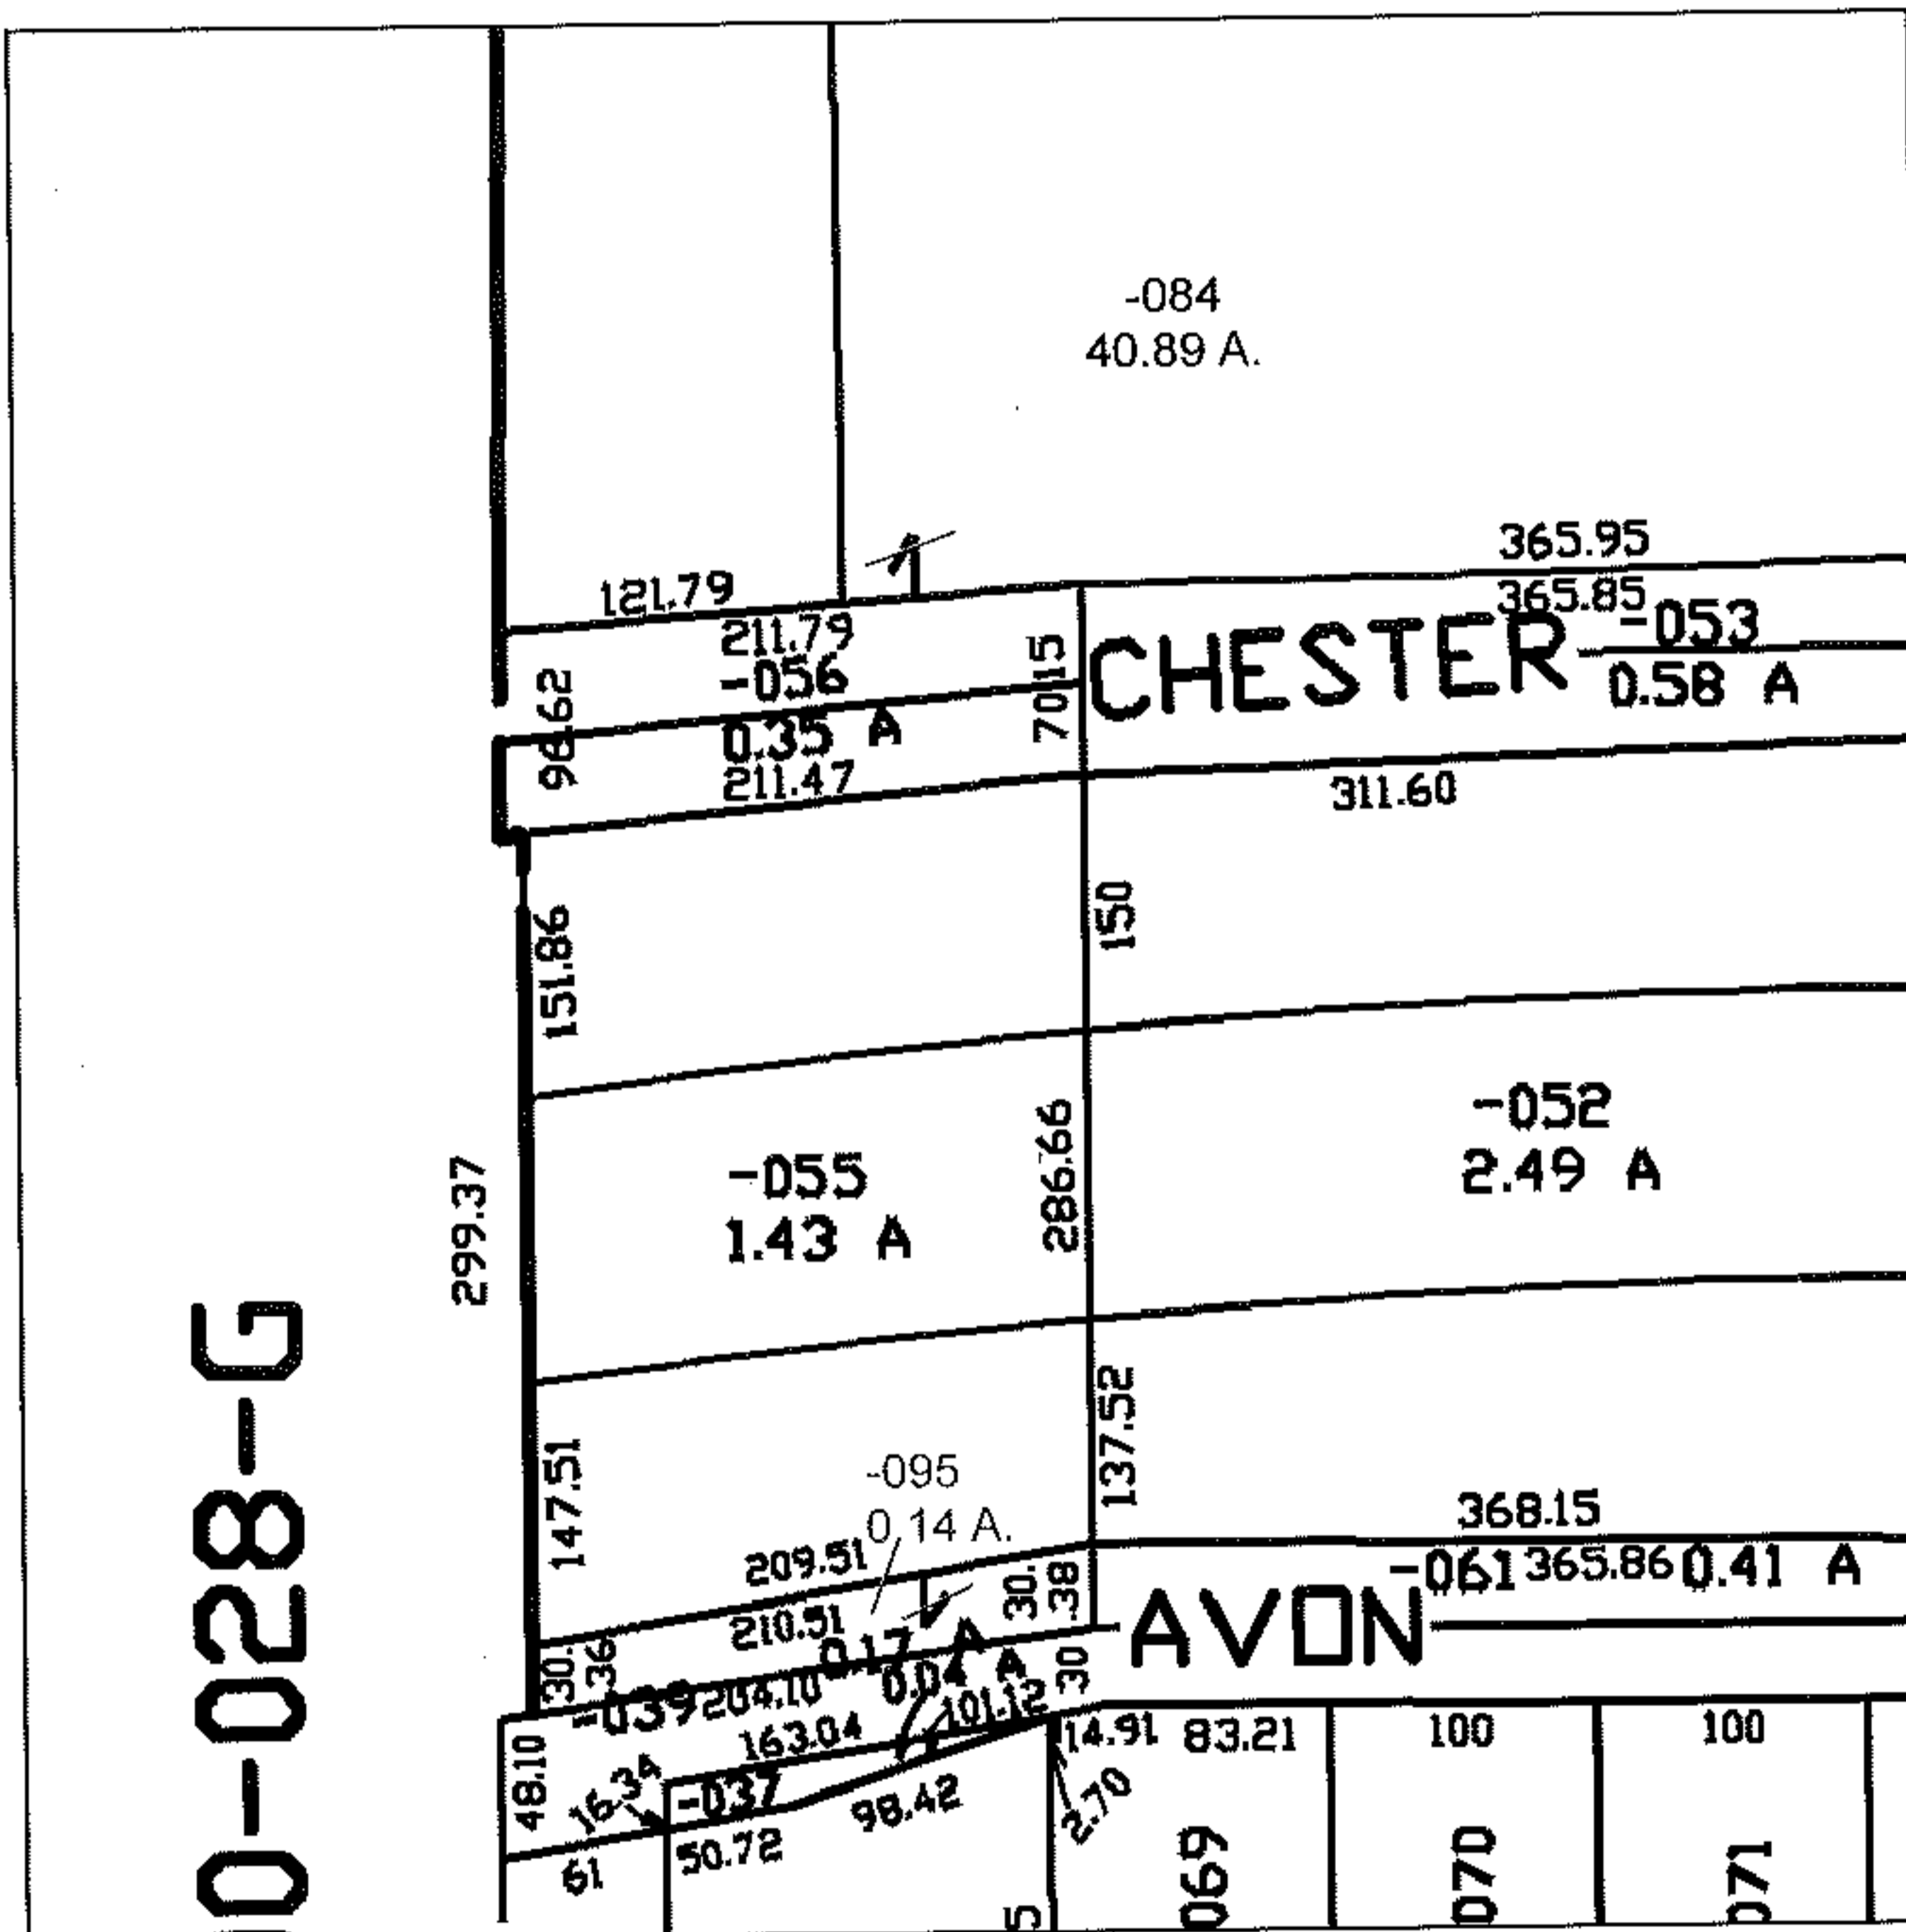


MASTER

PARENT PARCEL: --ADD TO DUP--
CHILD PARCEL: 04-00-028-101-095
STARTING POINT:

09-01839-X

ADD TO DUP.
WAS NEVER SPLIT FROM
ORIGINAL SPLIT

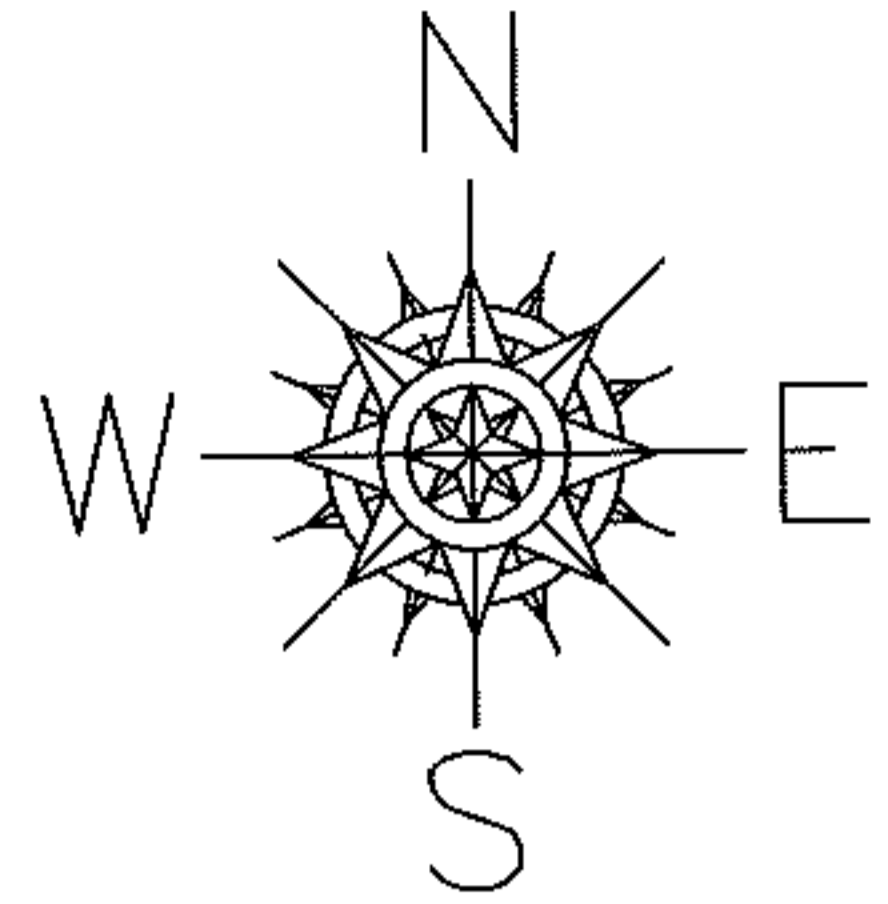

0-028-G

SPLITS/DEEDS PROCESSED
LORAIN COUNTY TAX MAP DEPARTMENT
226 MIDDLE AVE. ELYRIA, OHIO

SURVEYED BY: N/A
CLOSURE: N/A
MAP PAGE(S): 04-00-028-H
APPROVED BY: JAH DATE: 6/5/2009
SCALE: NOT TO SCALE PRIOR INSTRUMENT: