
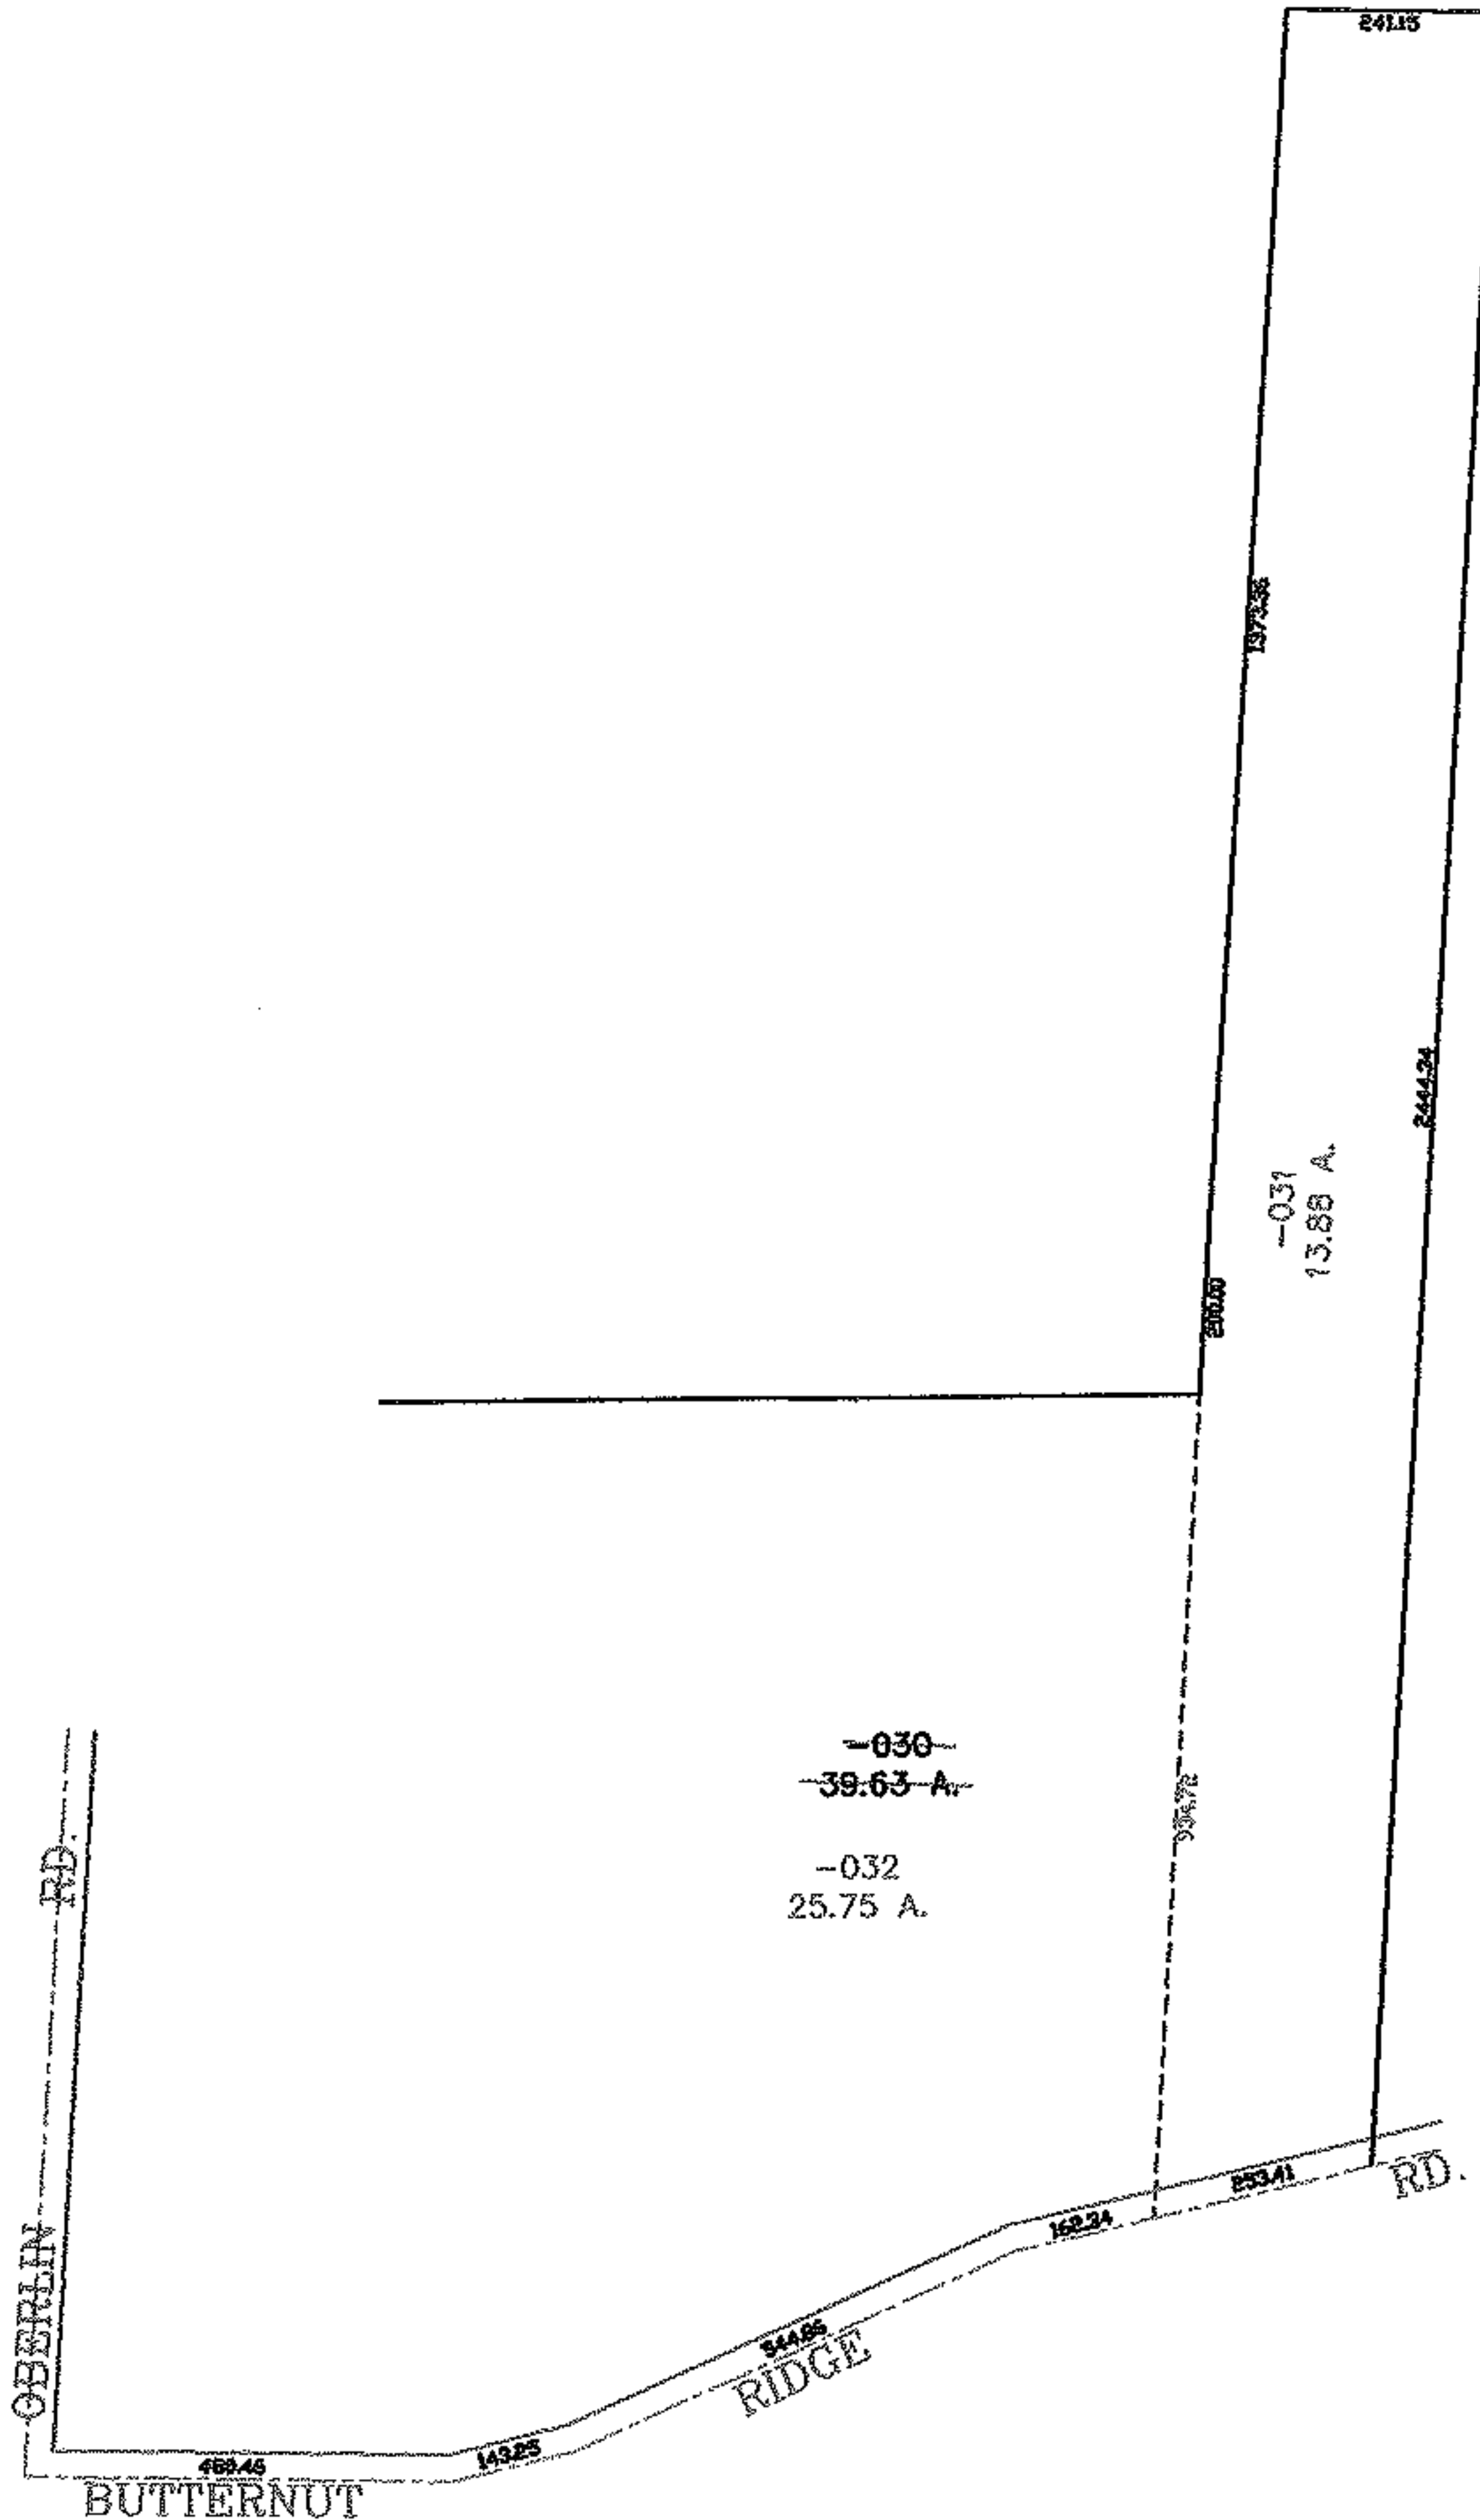


PARENT PARCEL: 09-00-058-000-030

CHILD PARCEL: 09-00-058-000-031, -032

STARTING POINT: CENTERLINE OF OBERLIN RD. & BUTTERNUT RIDGE RD.

NO. 01839

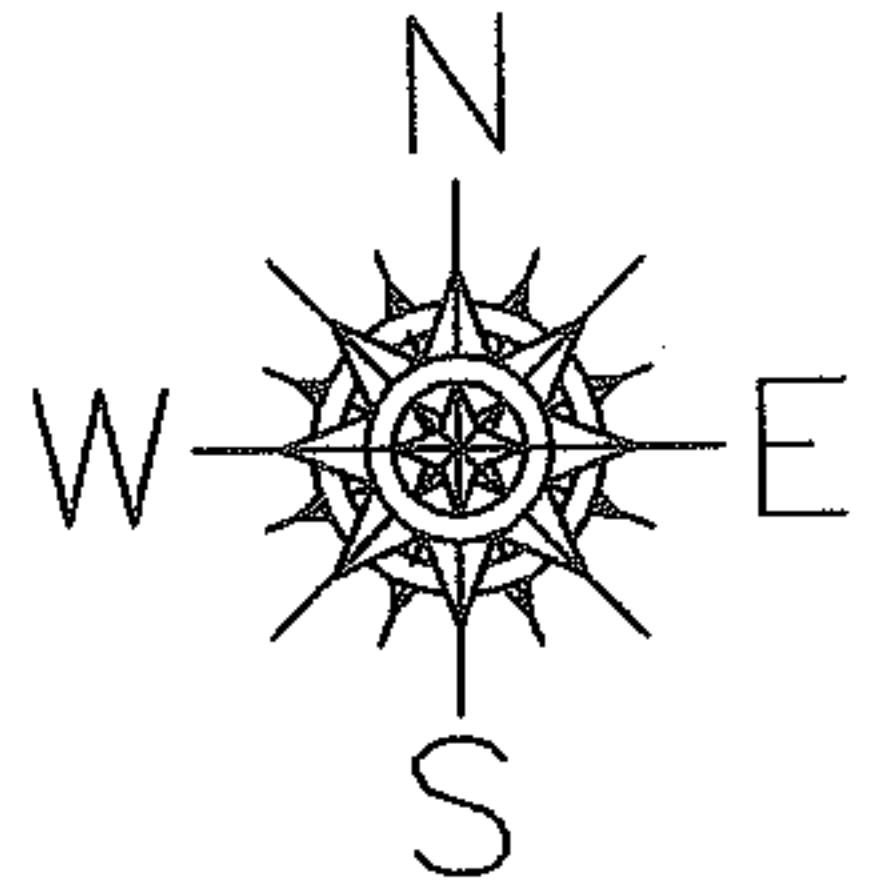

**SPLITS/DEEDS PROCESSED**  
**LORAIN COUNTY TAX MAP DEPARTMENT**  
**226 MIDDLE AVE. ELYRIA, OHIO**

SURVEYED BY: RICHARD D. CARLSON  
 CLOSURE: 0.00 : 10.000  
 MAP PAGE(S): 09-00-058-A  
 APPROVED BY: JAH DATE: 1-21-05  
 SCALE: 1" = 400 PRIOR INSTRUMENT: 20040817190