



PARENT PARCEL: 04-00-010-113-007, -110
 CHILD PARCEL: 04-00-010-113-190 THRU -192
 STARTING POINT: CENTERLINE OF COLORADO AVE & BRIDGE POINT TRAIL

NO. 01840

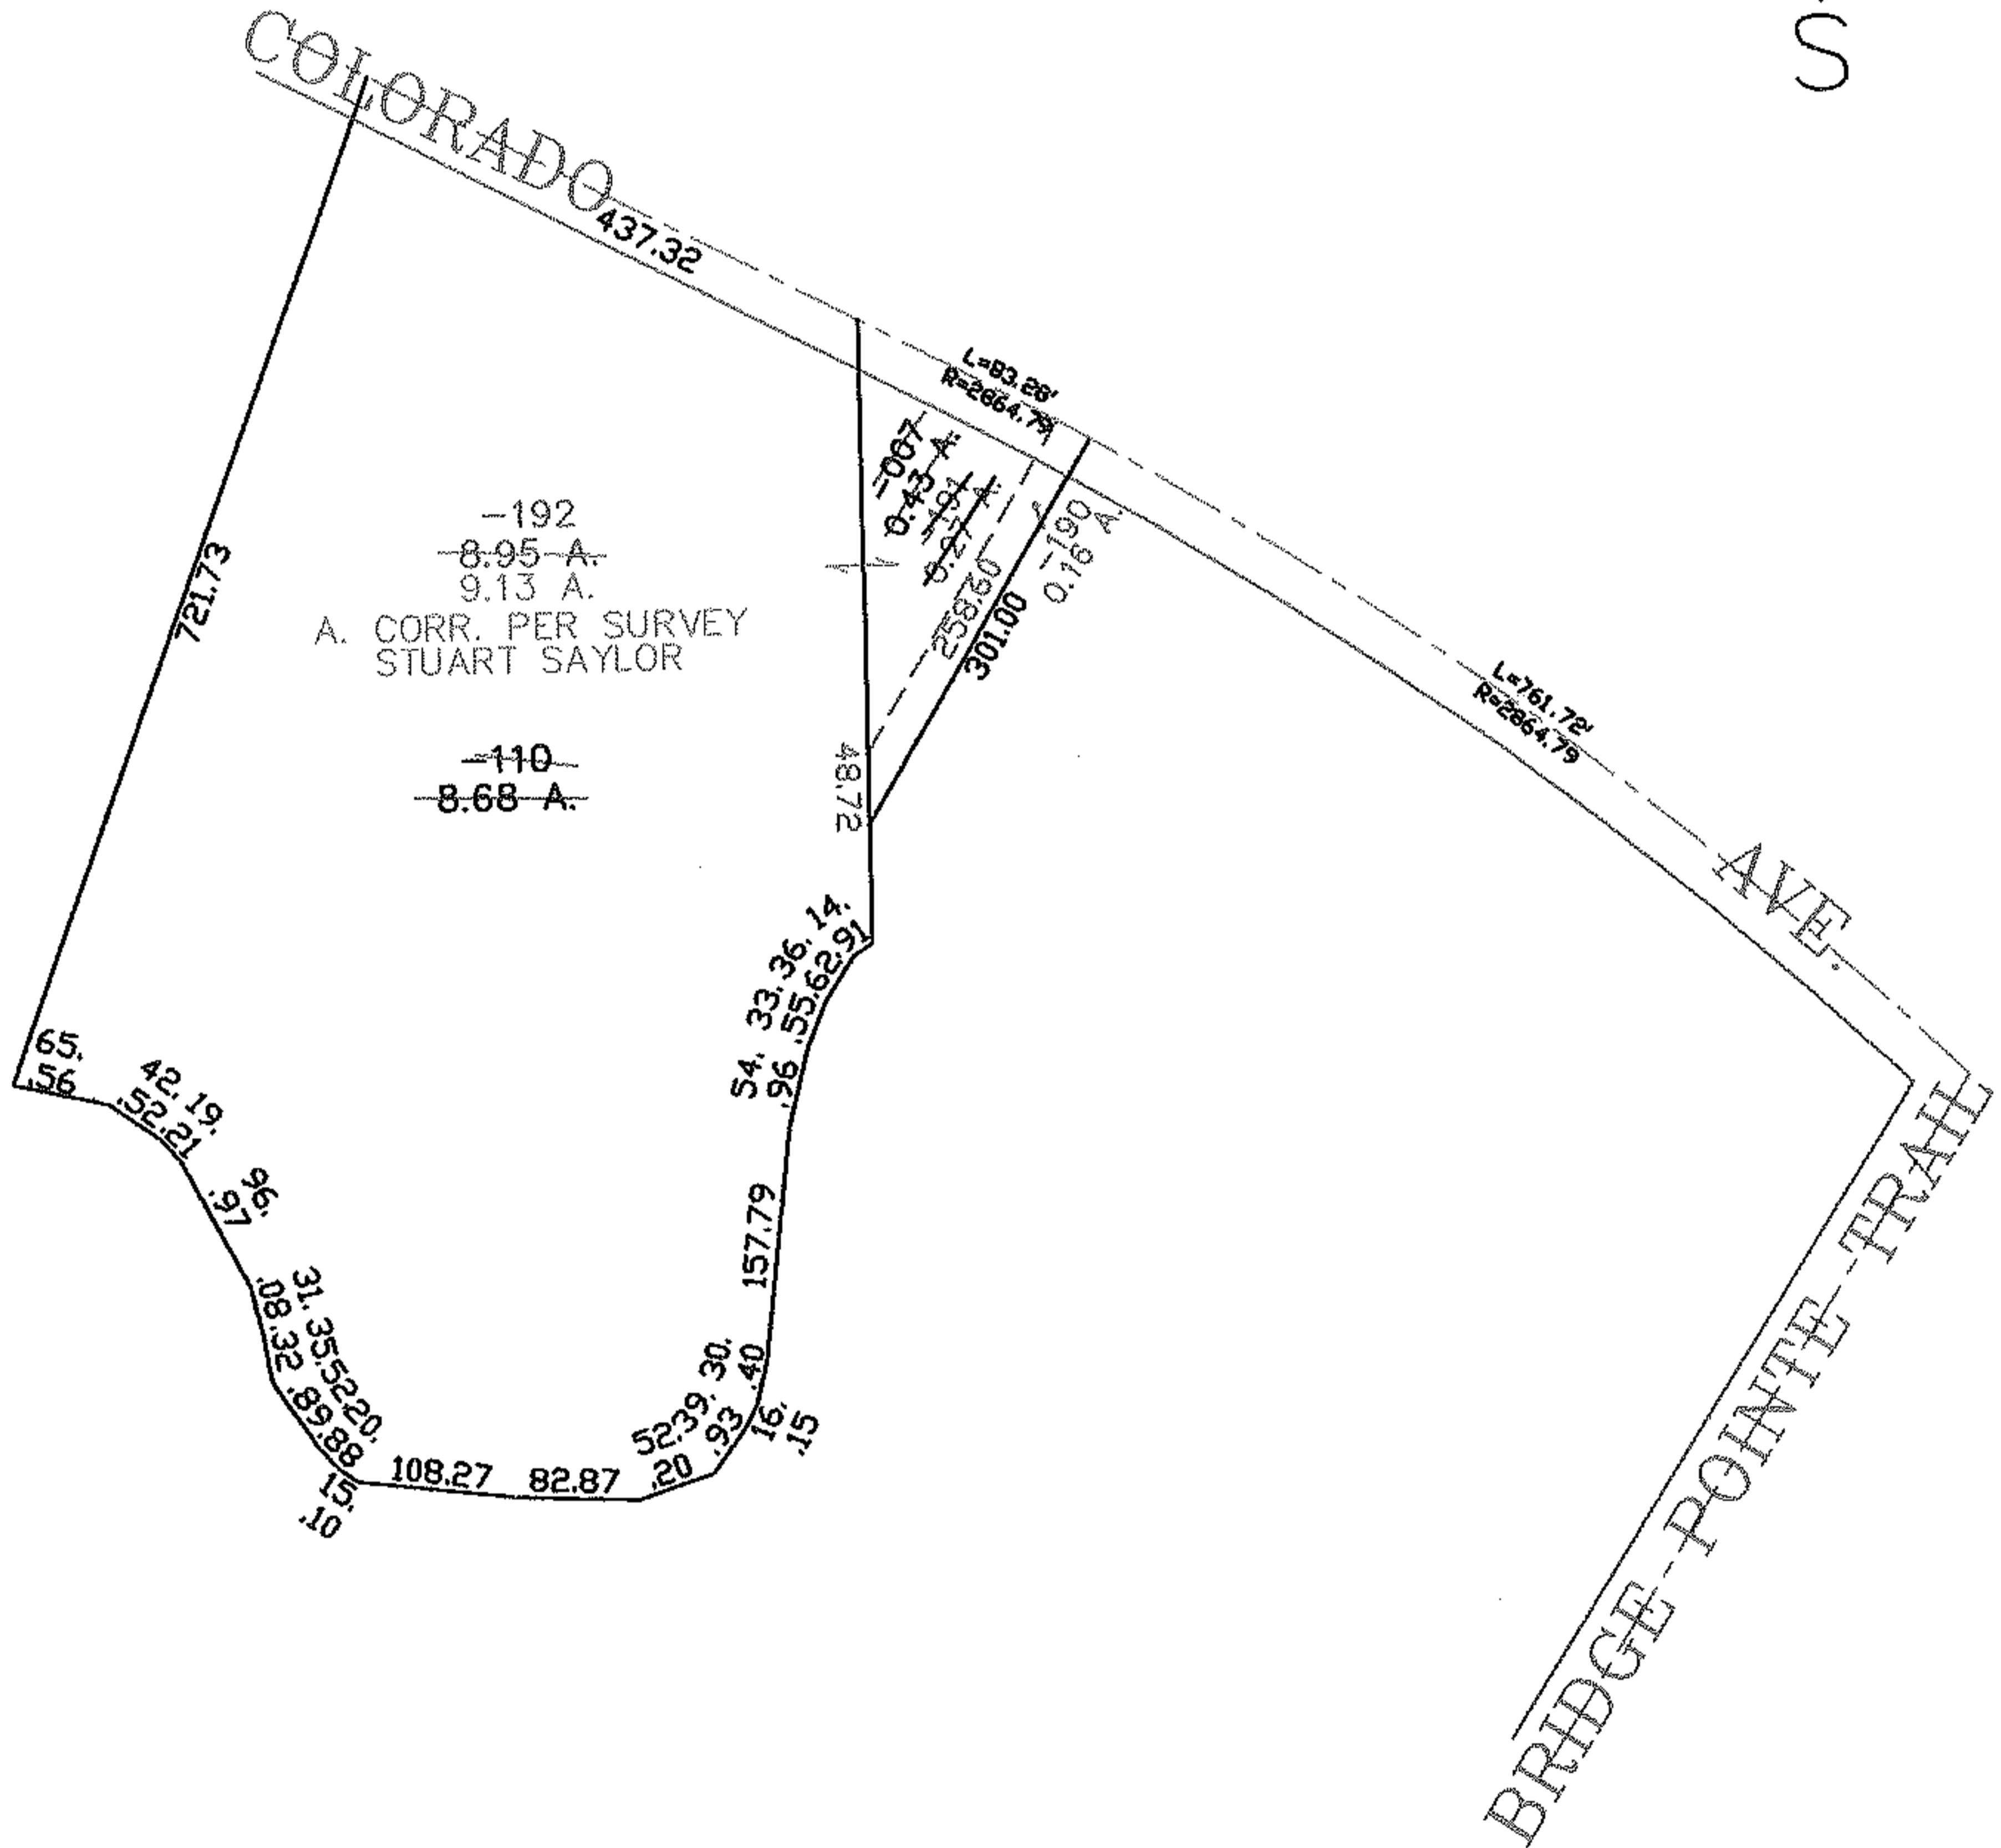

-192
~~8.95 A.~~
 9.13 A.
 A. CORR. PER SURVEY
 STUART SAYLOR
~~-110~~
~~8.68 A.~~

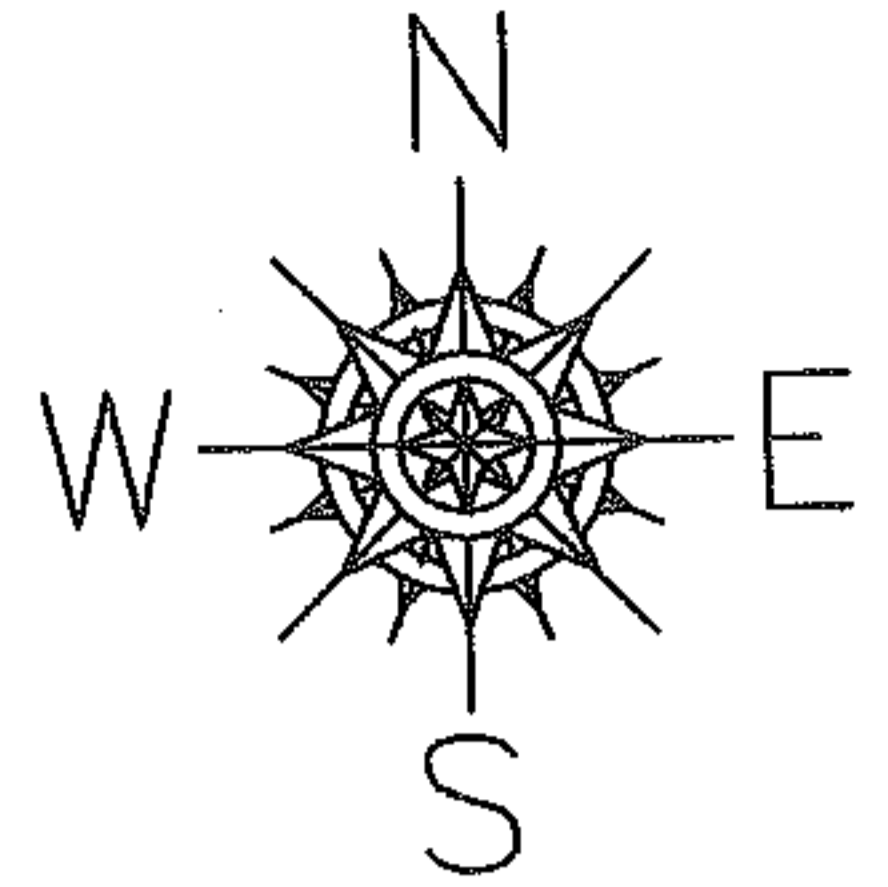

SPLITS/DEEDS PROCESSED
 LORAIN COUNTY TAX MAP DEPARTMENT
 226 MIDDLE AVE. ELYRIA, OHIO

SURVEYED BY: STUART SAYLOR
 CLOSURE: 0.00 : 10.000
 MAP PAGE(S): 04-00-010-A
 APPROVED BY: JAH DATE: 2-10-05
 SCALE: 1" = 200 PRIOR INSTRUMENT: 20030958653