



RASTER

PARENT PARCEL: 16-00-015-000-036, -028

CHILD PARCEL: 16-00-015-000-040 THRU -042

STARTING POINT: CENTERLINE OF GRAFTON EASTERN RD & WOOSTER AVON LAKE RD.

NO. 01843

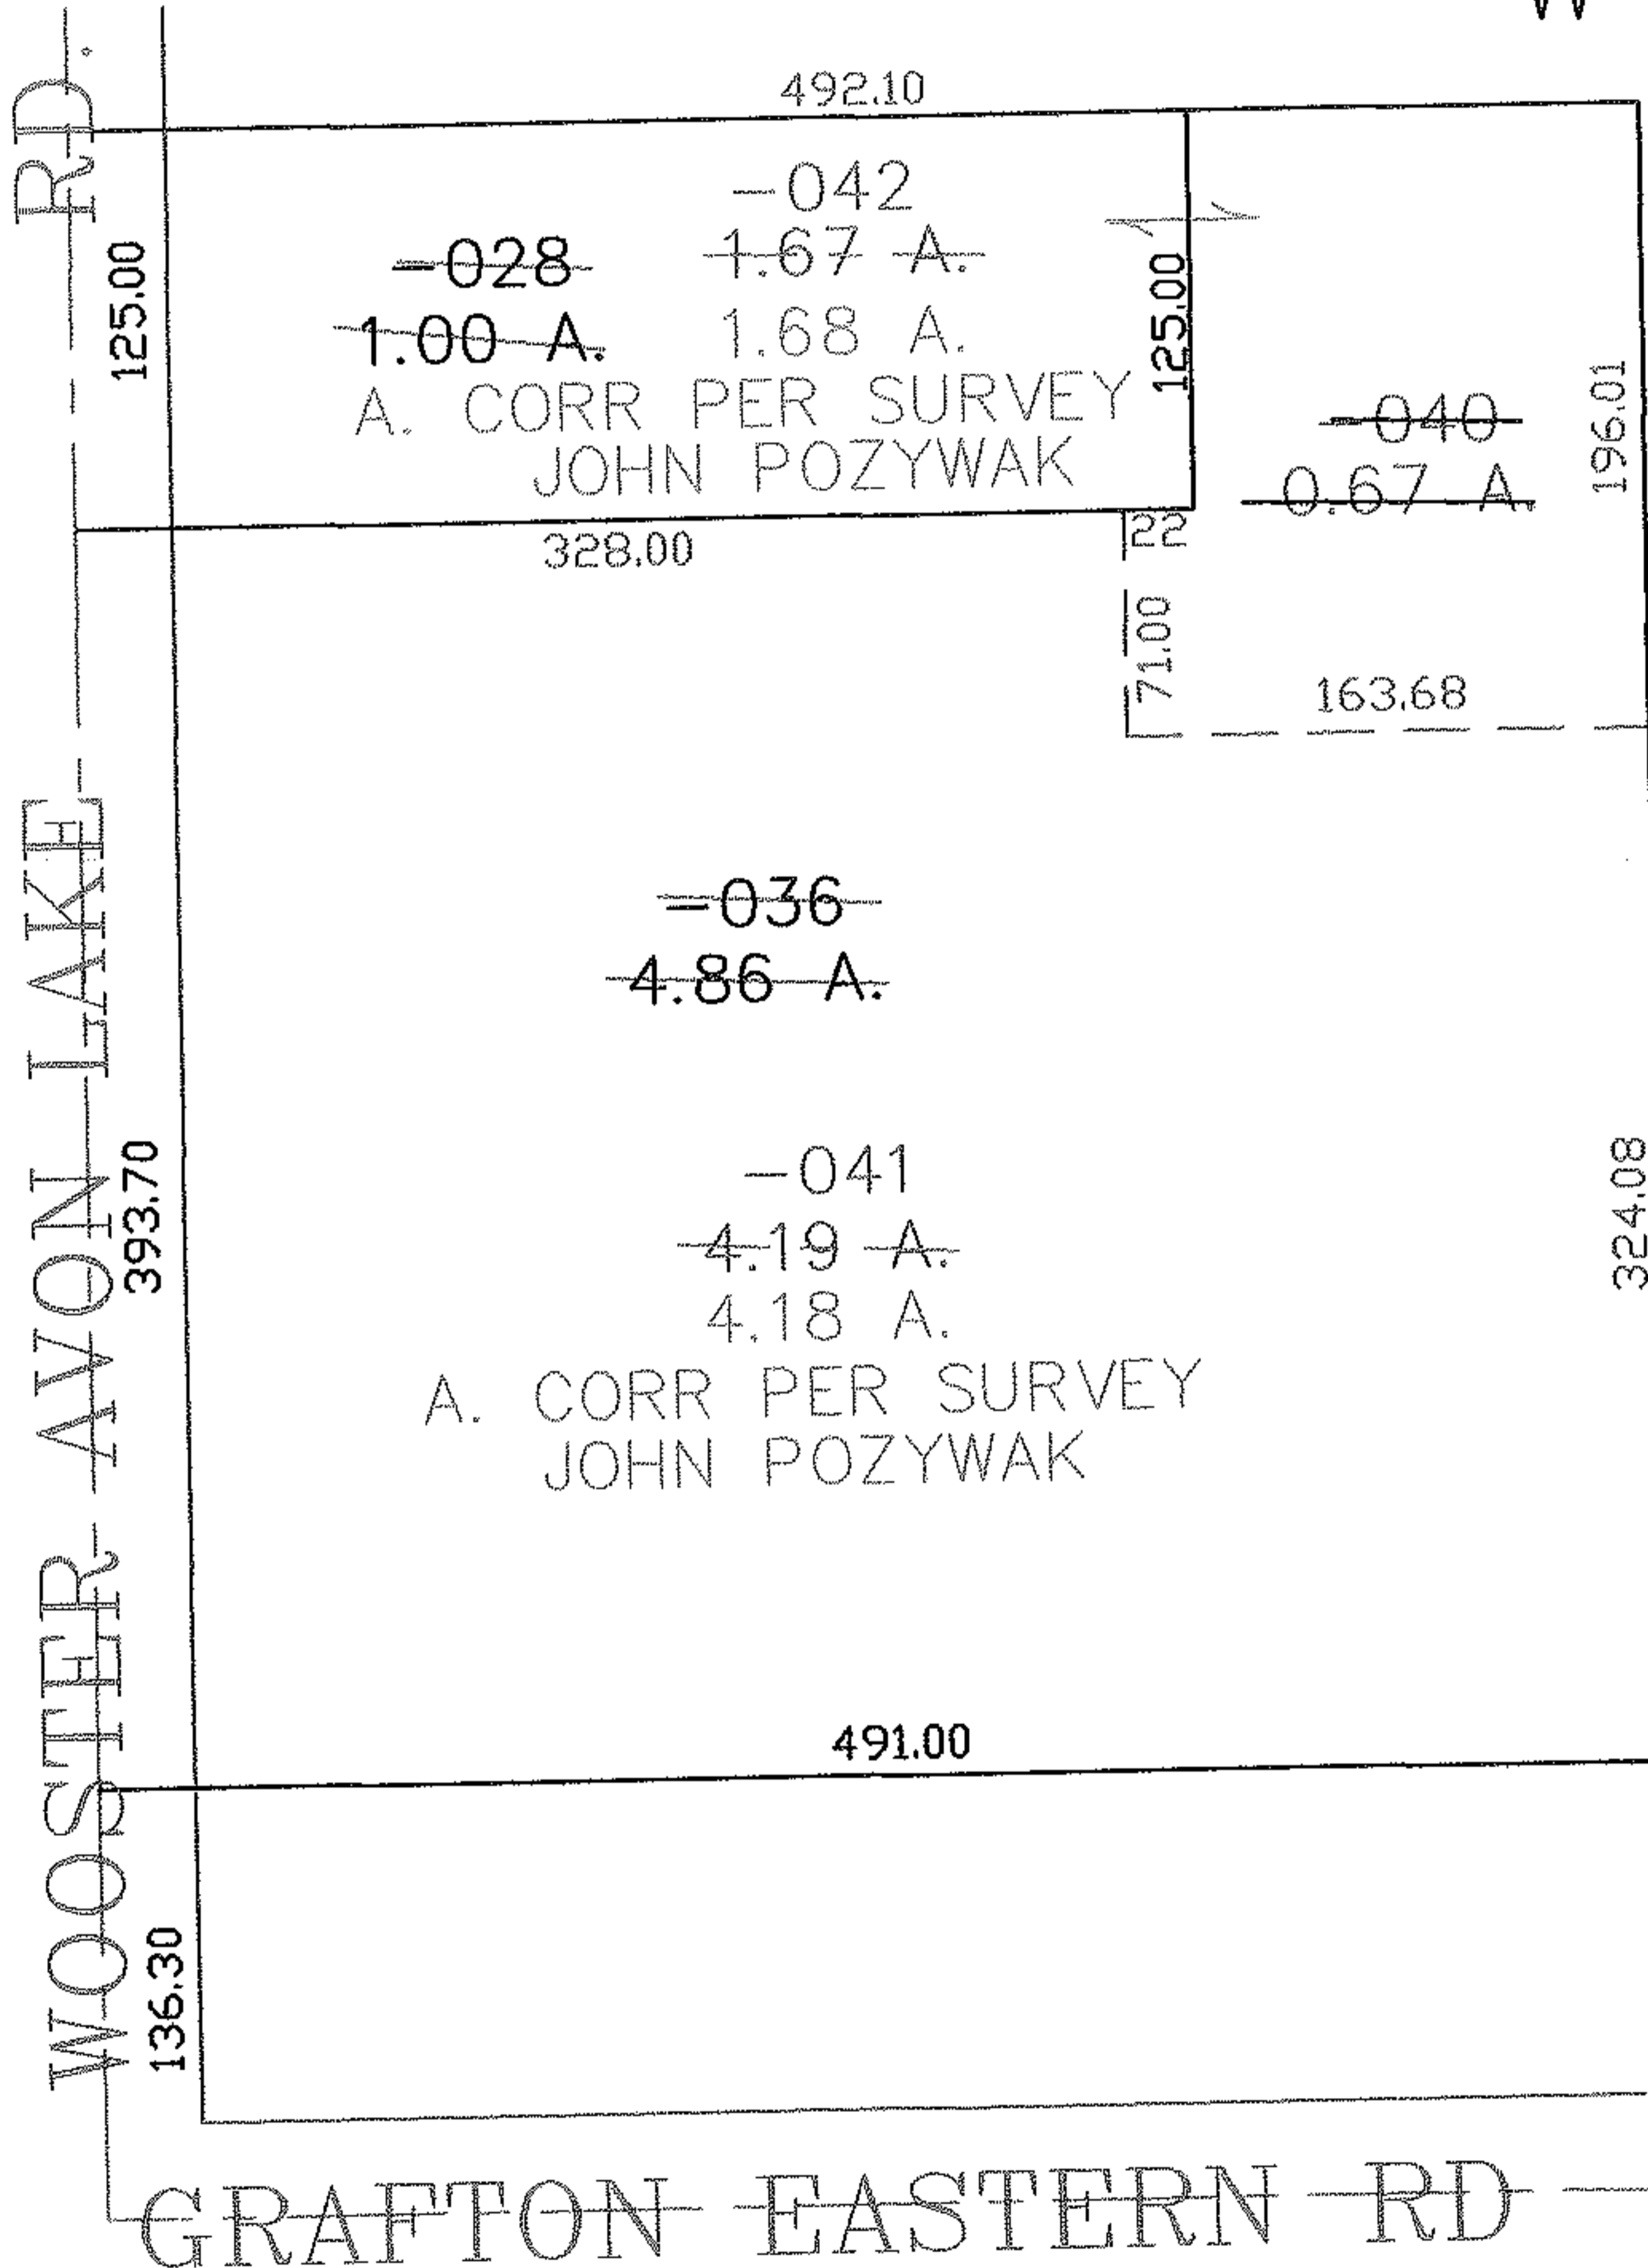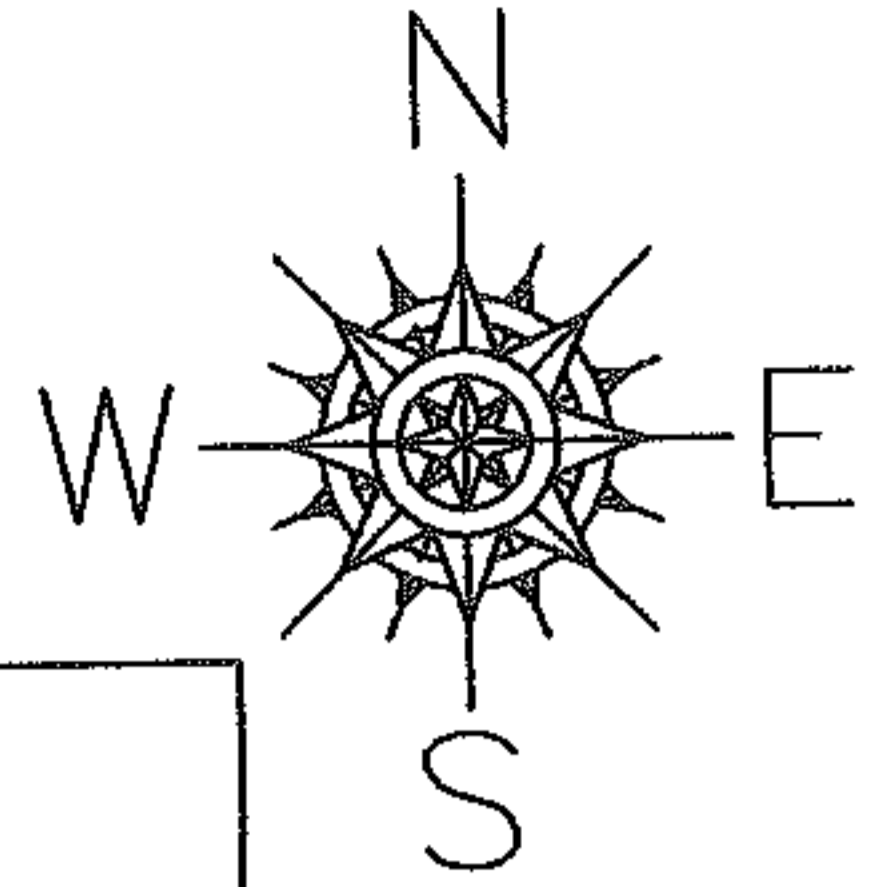

SPLITS/DEEDS PROCESSED

LORAIN COUNTY TAX MAP DEPARTMENT
226 MIDDLE AVE. ELYRIA, OHIO

SURVEYED BY: JOHN POZYWAK
 CLOSURE: 0.00 : 10.000
 MAP PAGE(S): 16-00-015-B
 APPROVED BY: JAH DATE: 2-10-05
 SCALE: 1" = 100 PRIOR INSTRUMENT: DV 563/793