




RASTER

PARENT PARCEL: 05-00-038-106-075

CHILD PARCEL: 05-00-038-106-094, -095

STARTING POINT: NORTHWEST CORNER OF S/4 IN RICE ALLOTMENT

NO. 01844

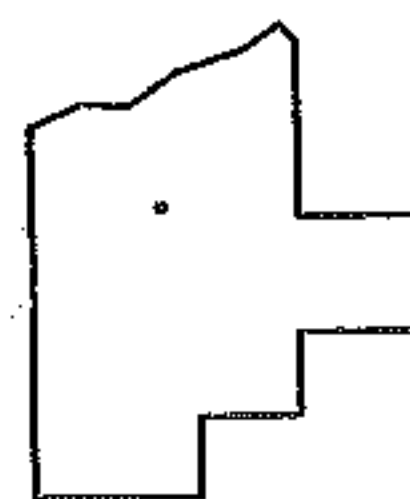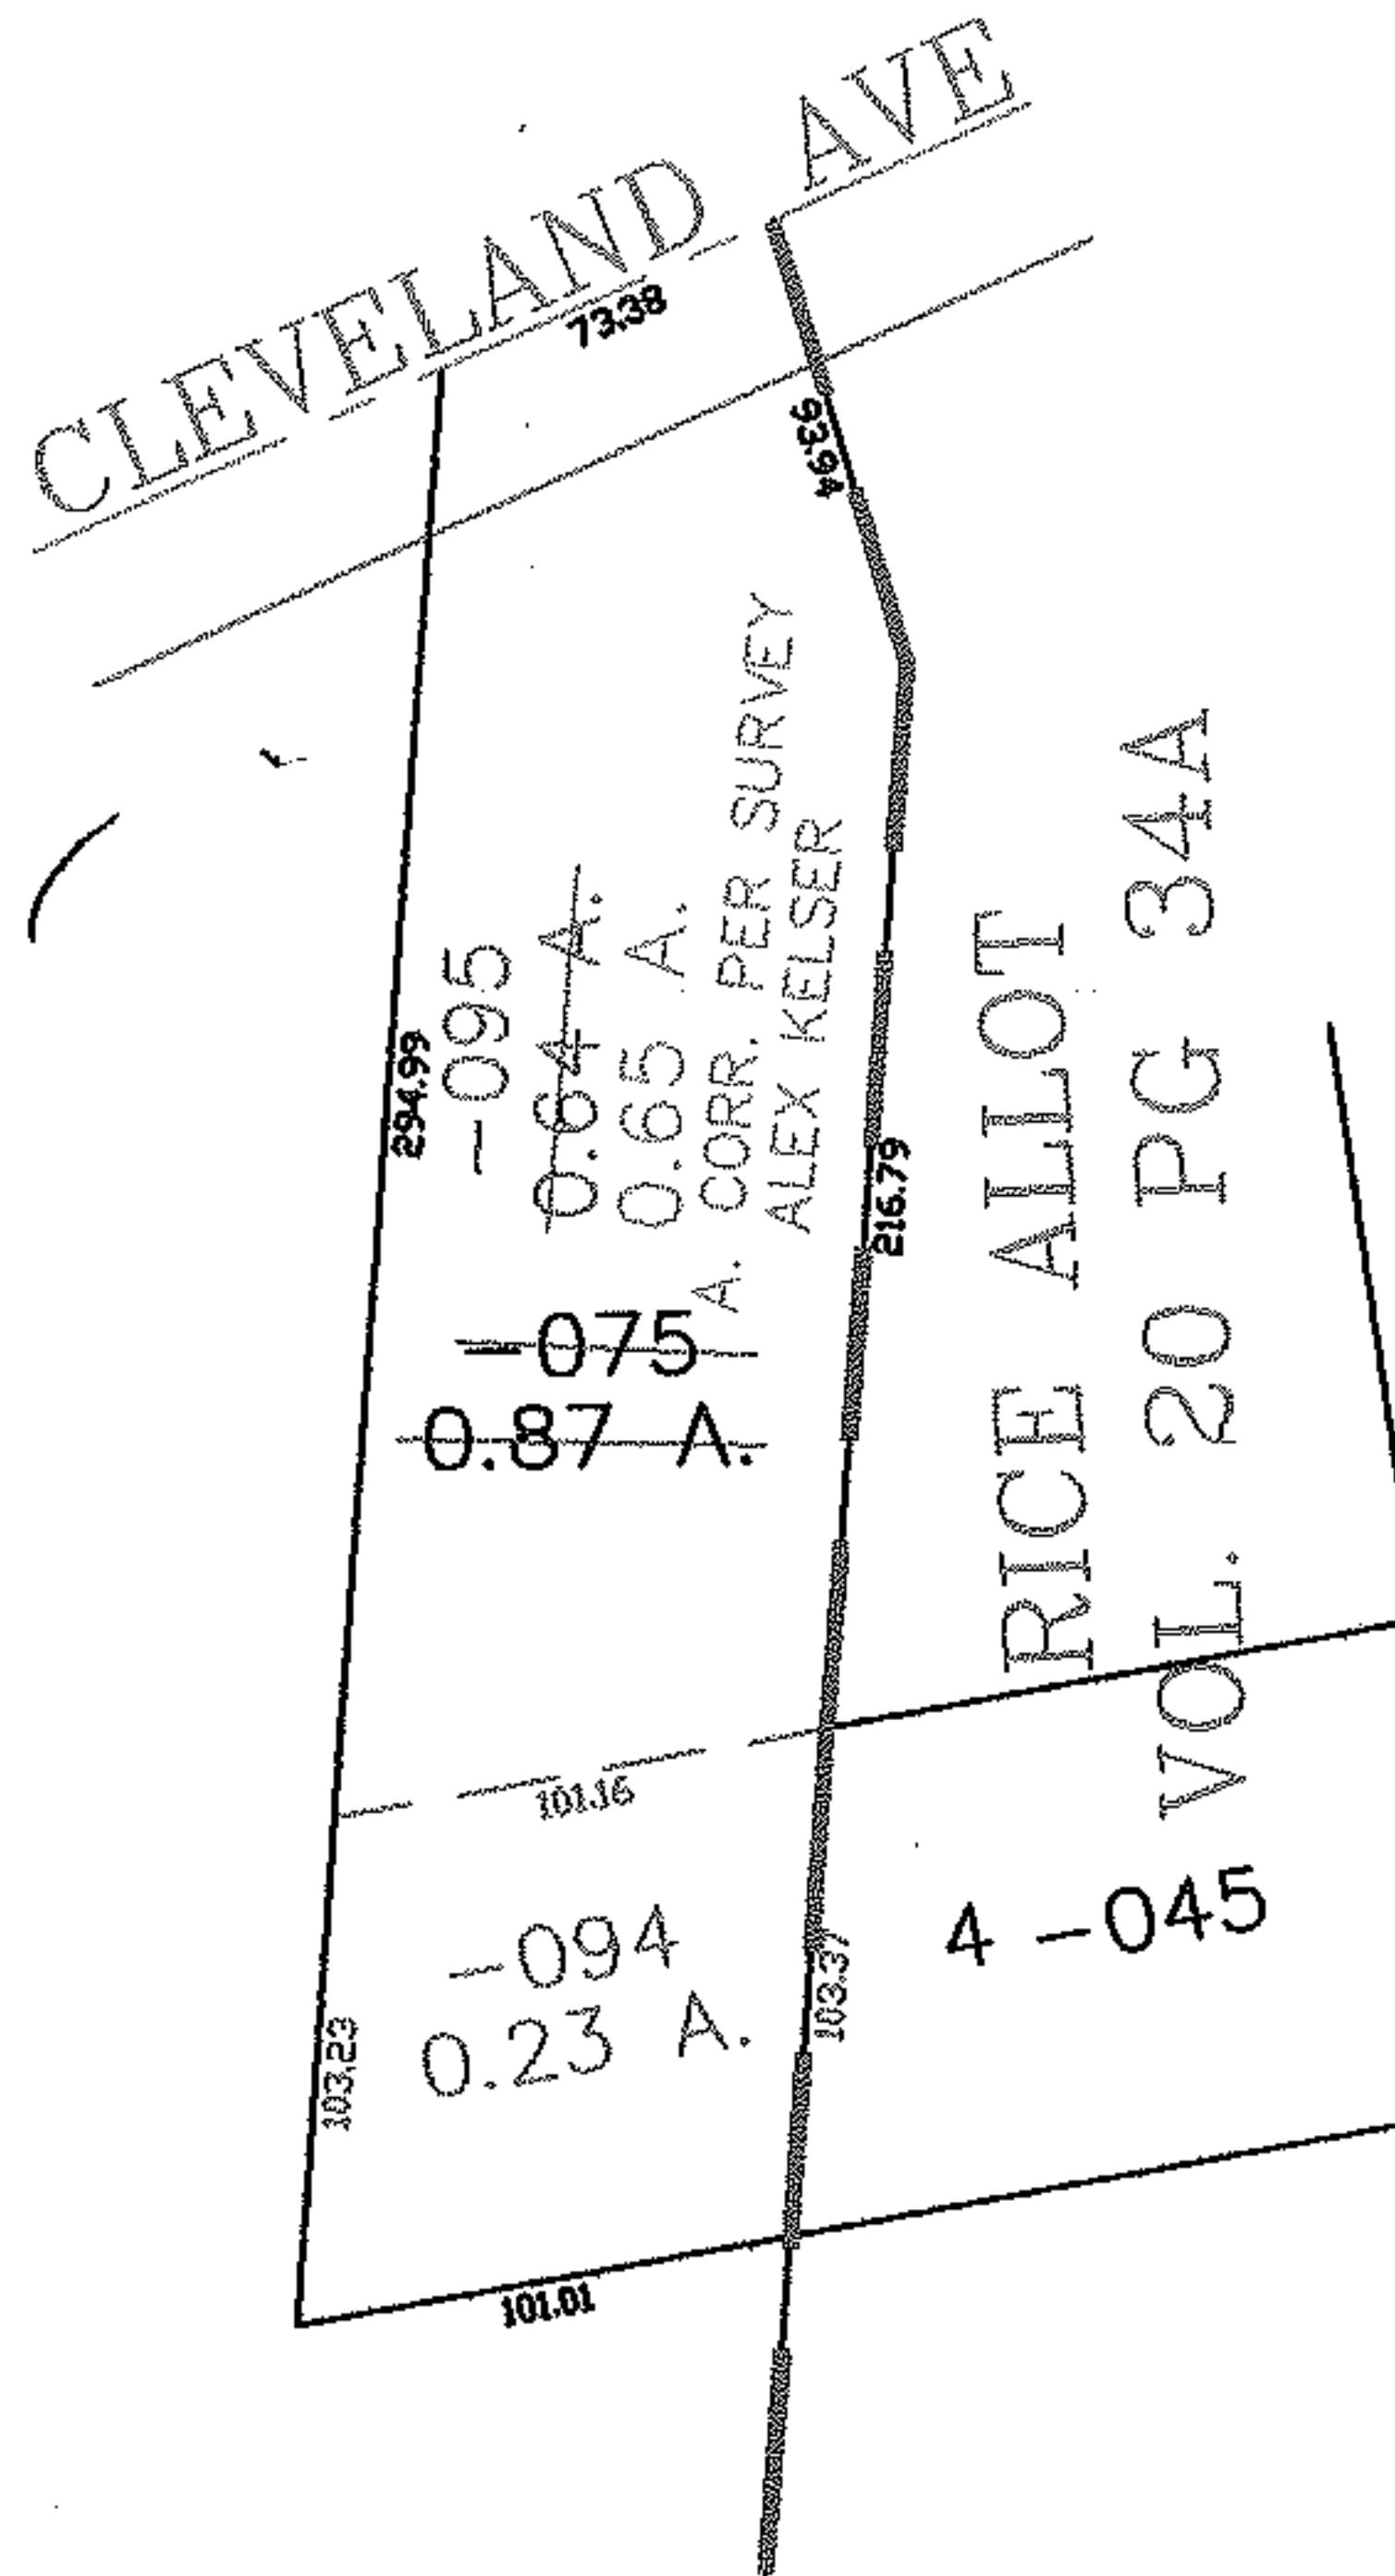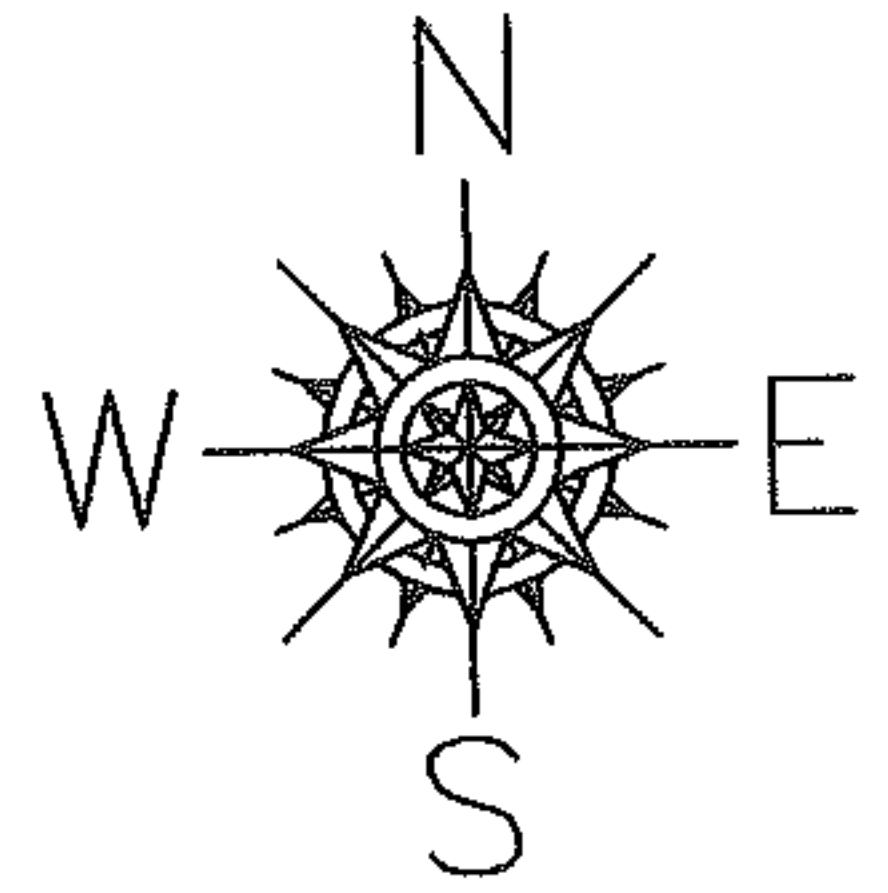

SPLITS/DEEDS PROCESSED

LORAIN COUNTY TAX MAP DEPARTMENT  
226 MIDDLE AVE. ELYRIA, OHIO

SURVEYED BY: ALEX KELSER

CLOSURE: 0.00 : 10.000

MAP PAGE(S): 05-00-038-B

APPROVED BY: JAH DATE: 2-7-05

SCALE: 1" = 100 PRIOR INSTRUMENT: DV 965/407