

RASTER


PARENT PARCEL: 05-00-099-000-093

CHILD PARCEL: --SAME--



STARTING POINT: INT CL COOPER FOSTER AND QUARRY

09-01845-C

AC. CORR.  
PER DEEDS

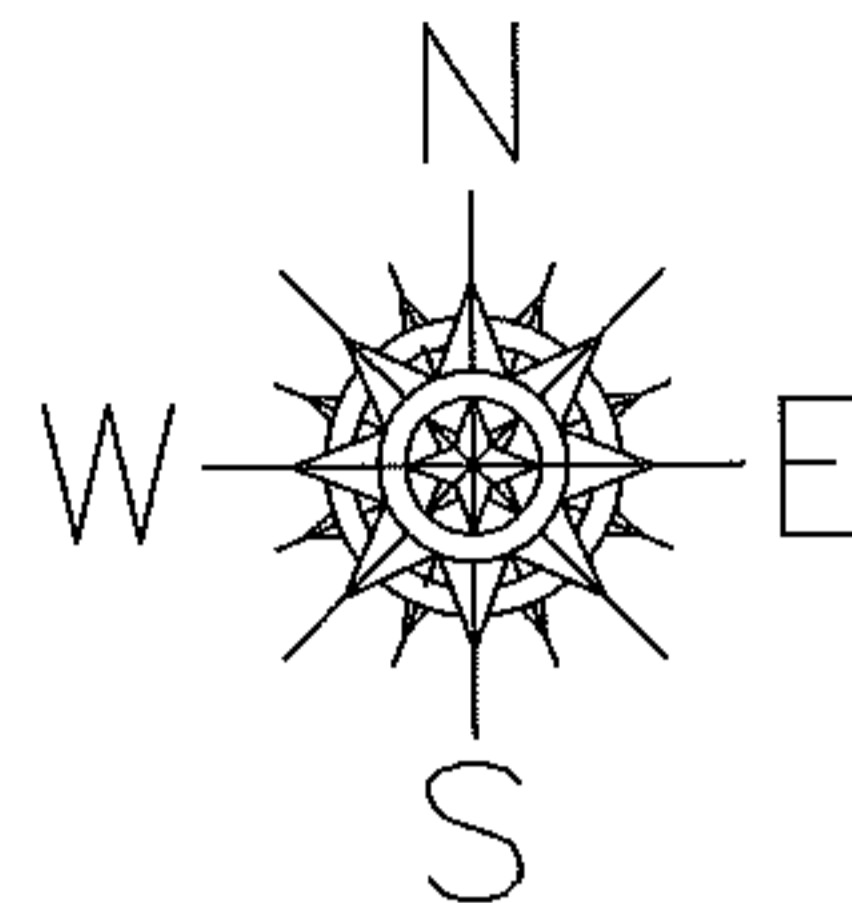

**SEE 5-A**

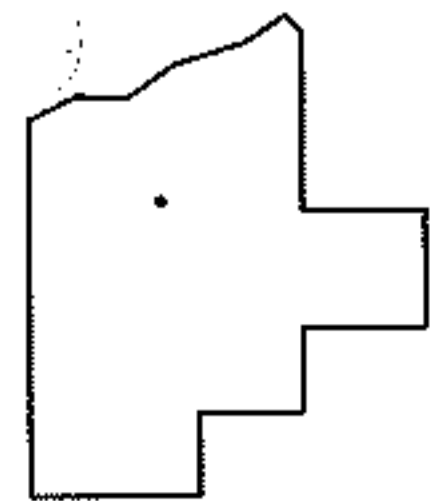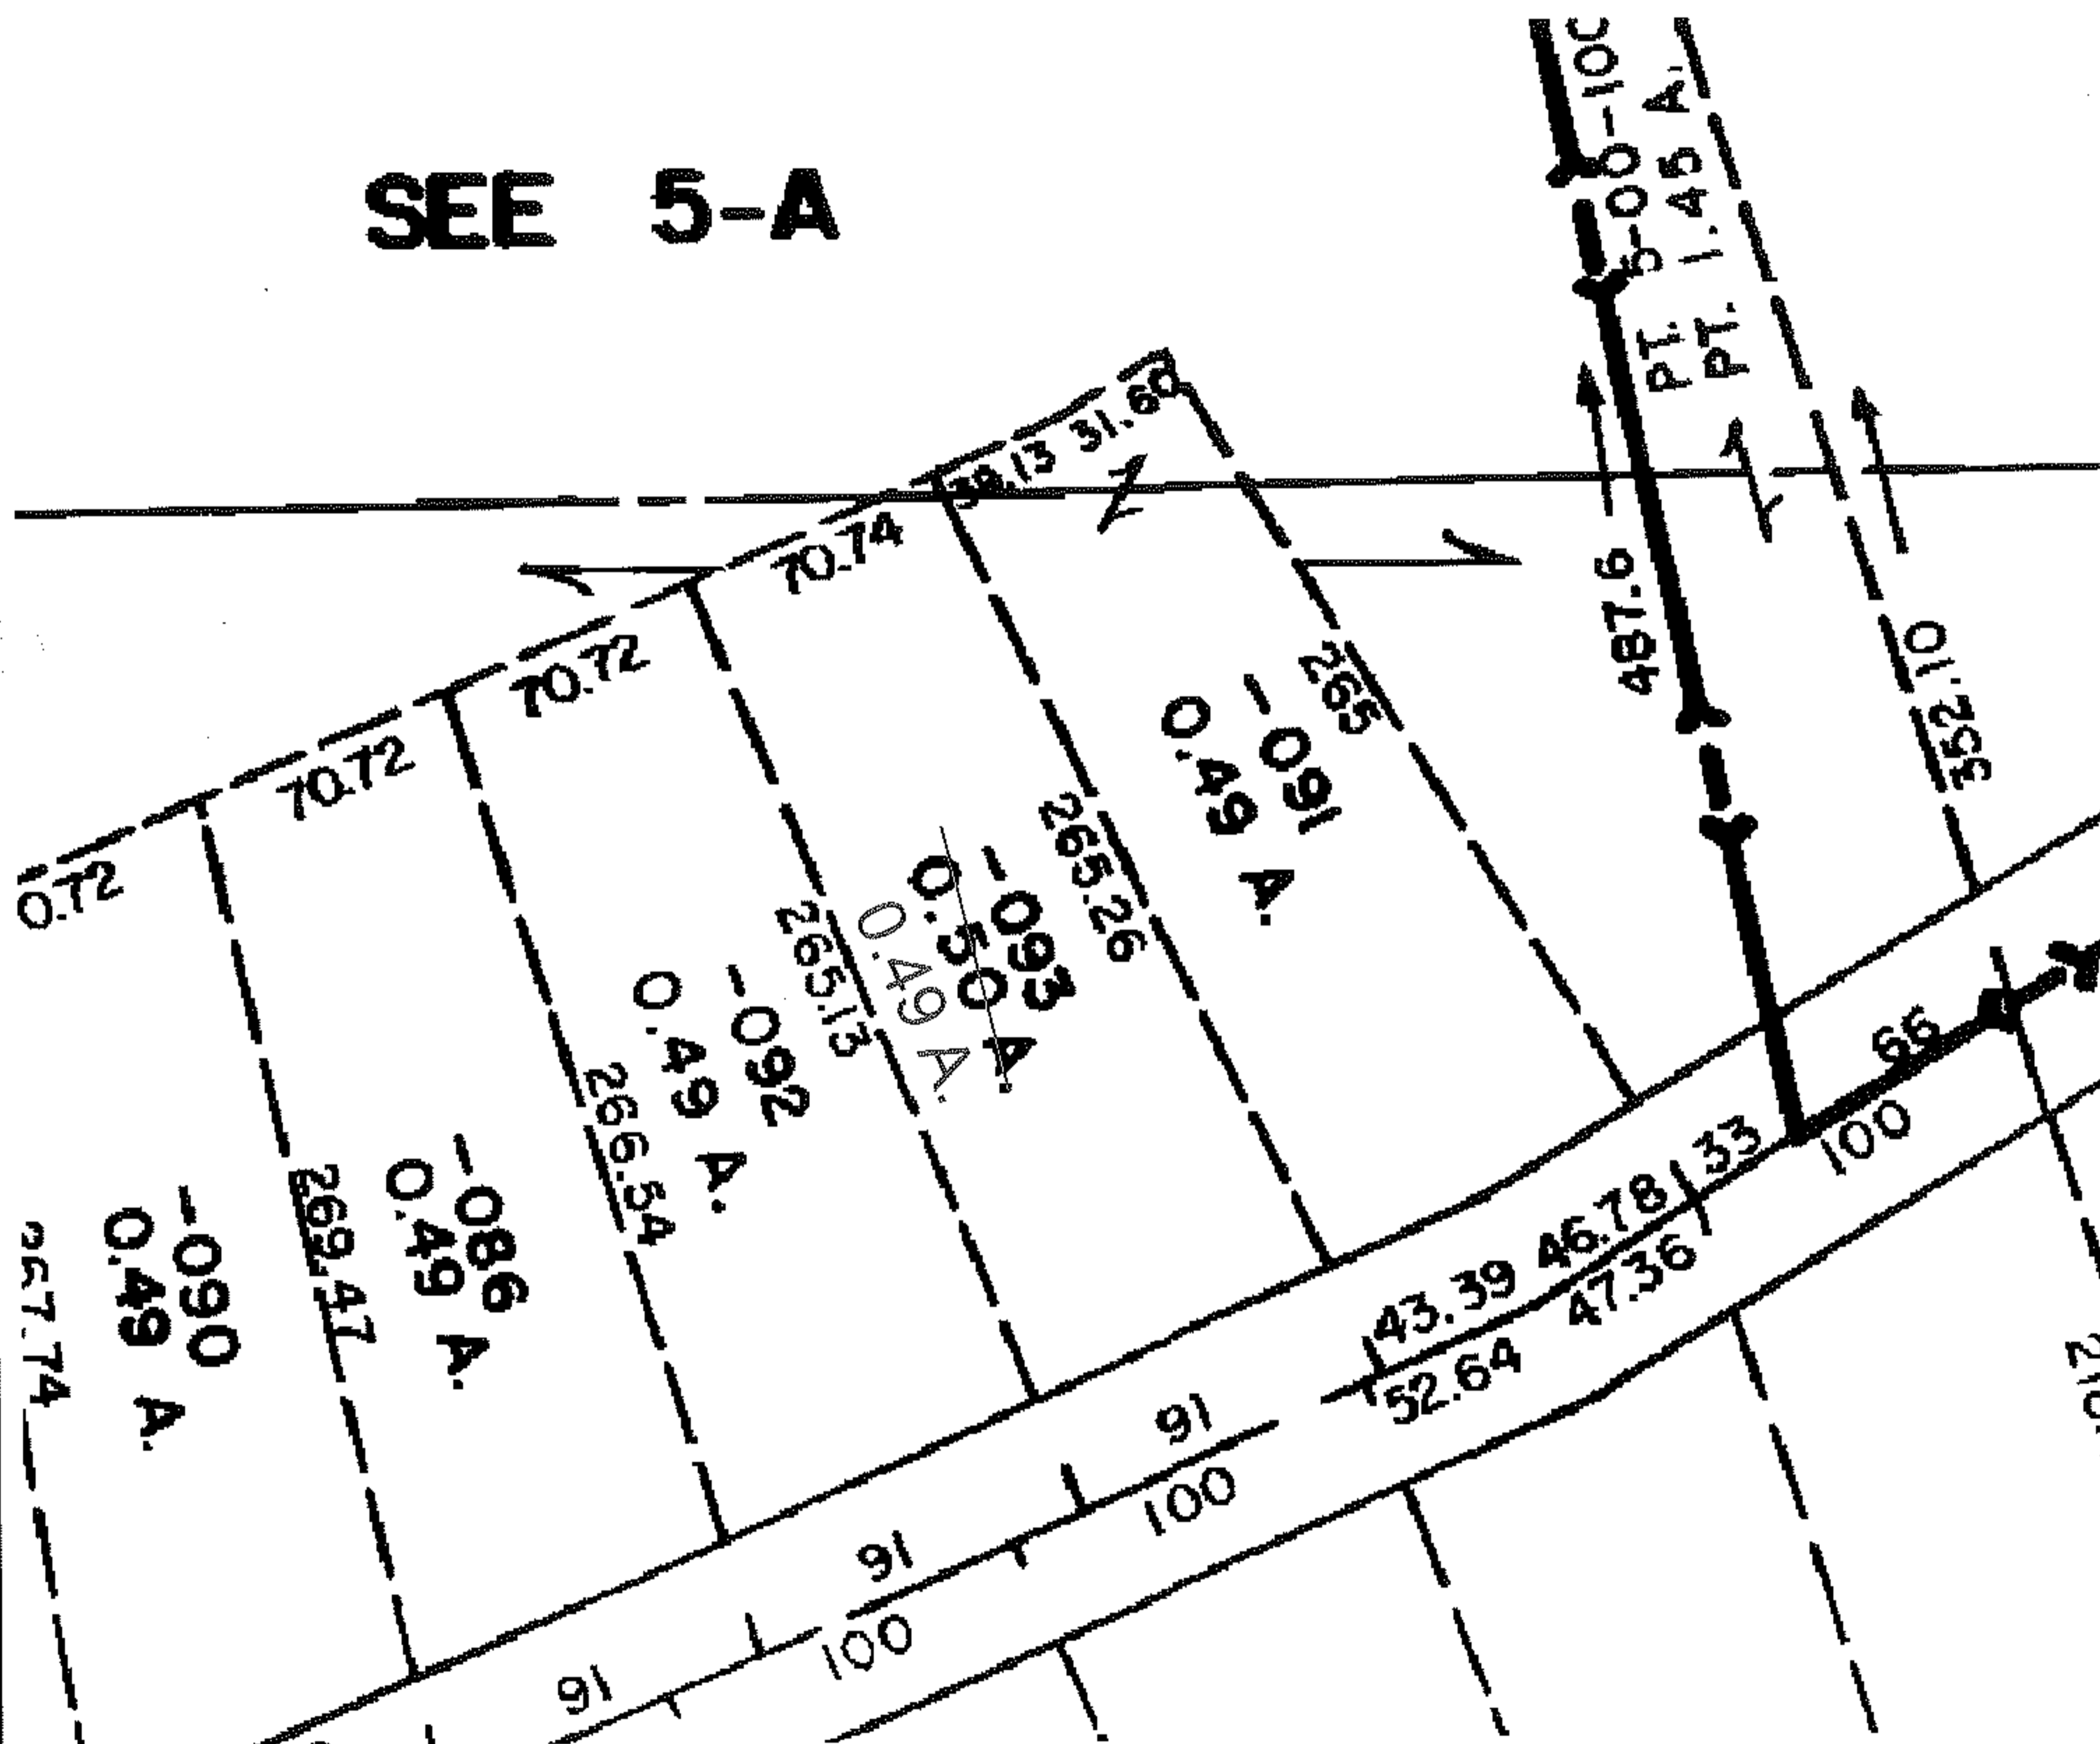

SPLITS/DEEDS PROCESSED

LORAIN COUNTY TAX MAP DEPARTMENT  
226 MIDDLE AVE. ELYRIA, OHIO

SURVEYED BY: N/A

CLOSURE: N/A

MAP PAGE(S): 05-00-099-C

APPROVED BY: DRH DATE: 6/17/2009

SCALE: NOT TO SCALE PRIOR INST.: OR 1086/477