




RASTER

PARENT PARCEL: 12-00-051-000-017

CHILD PARCEL: 12-00-051-000-068, -069

STARTING POINT: CENTER LINE OF COLUMBIA-WEST RIVER RD. & O.L. 51

NO. 01845

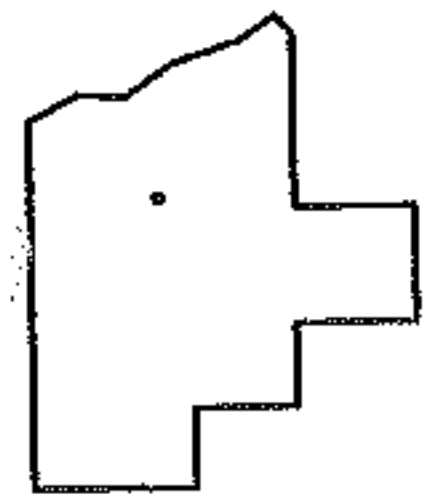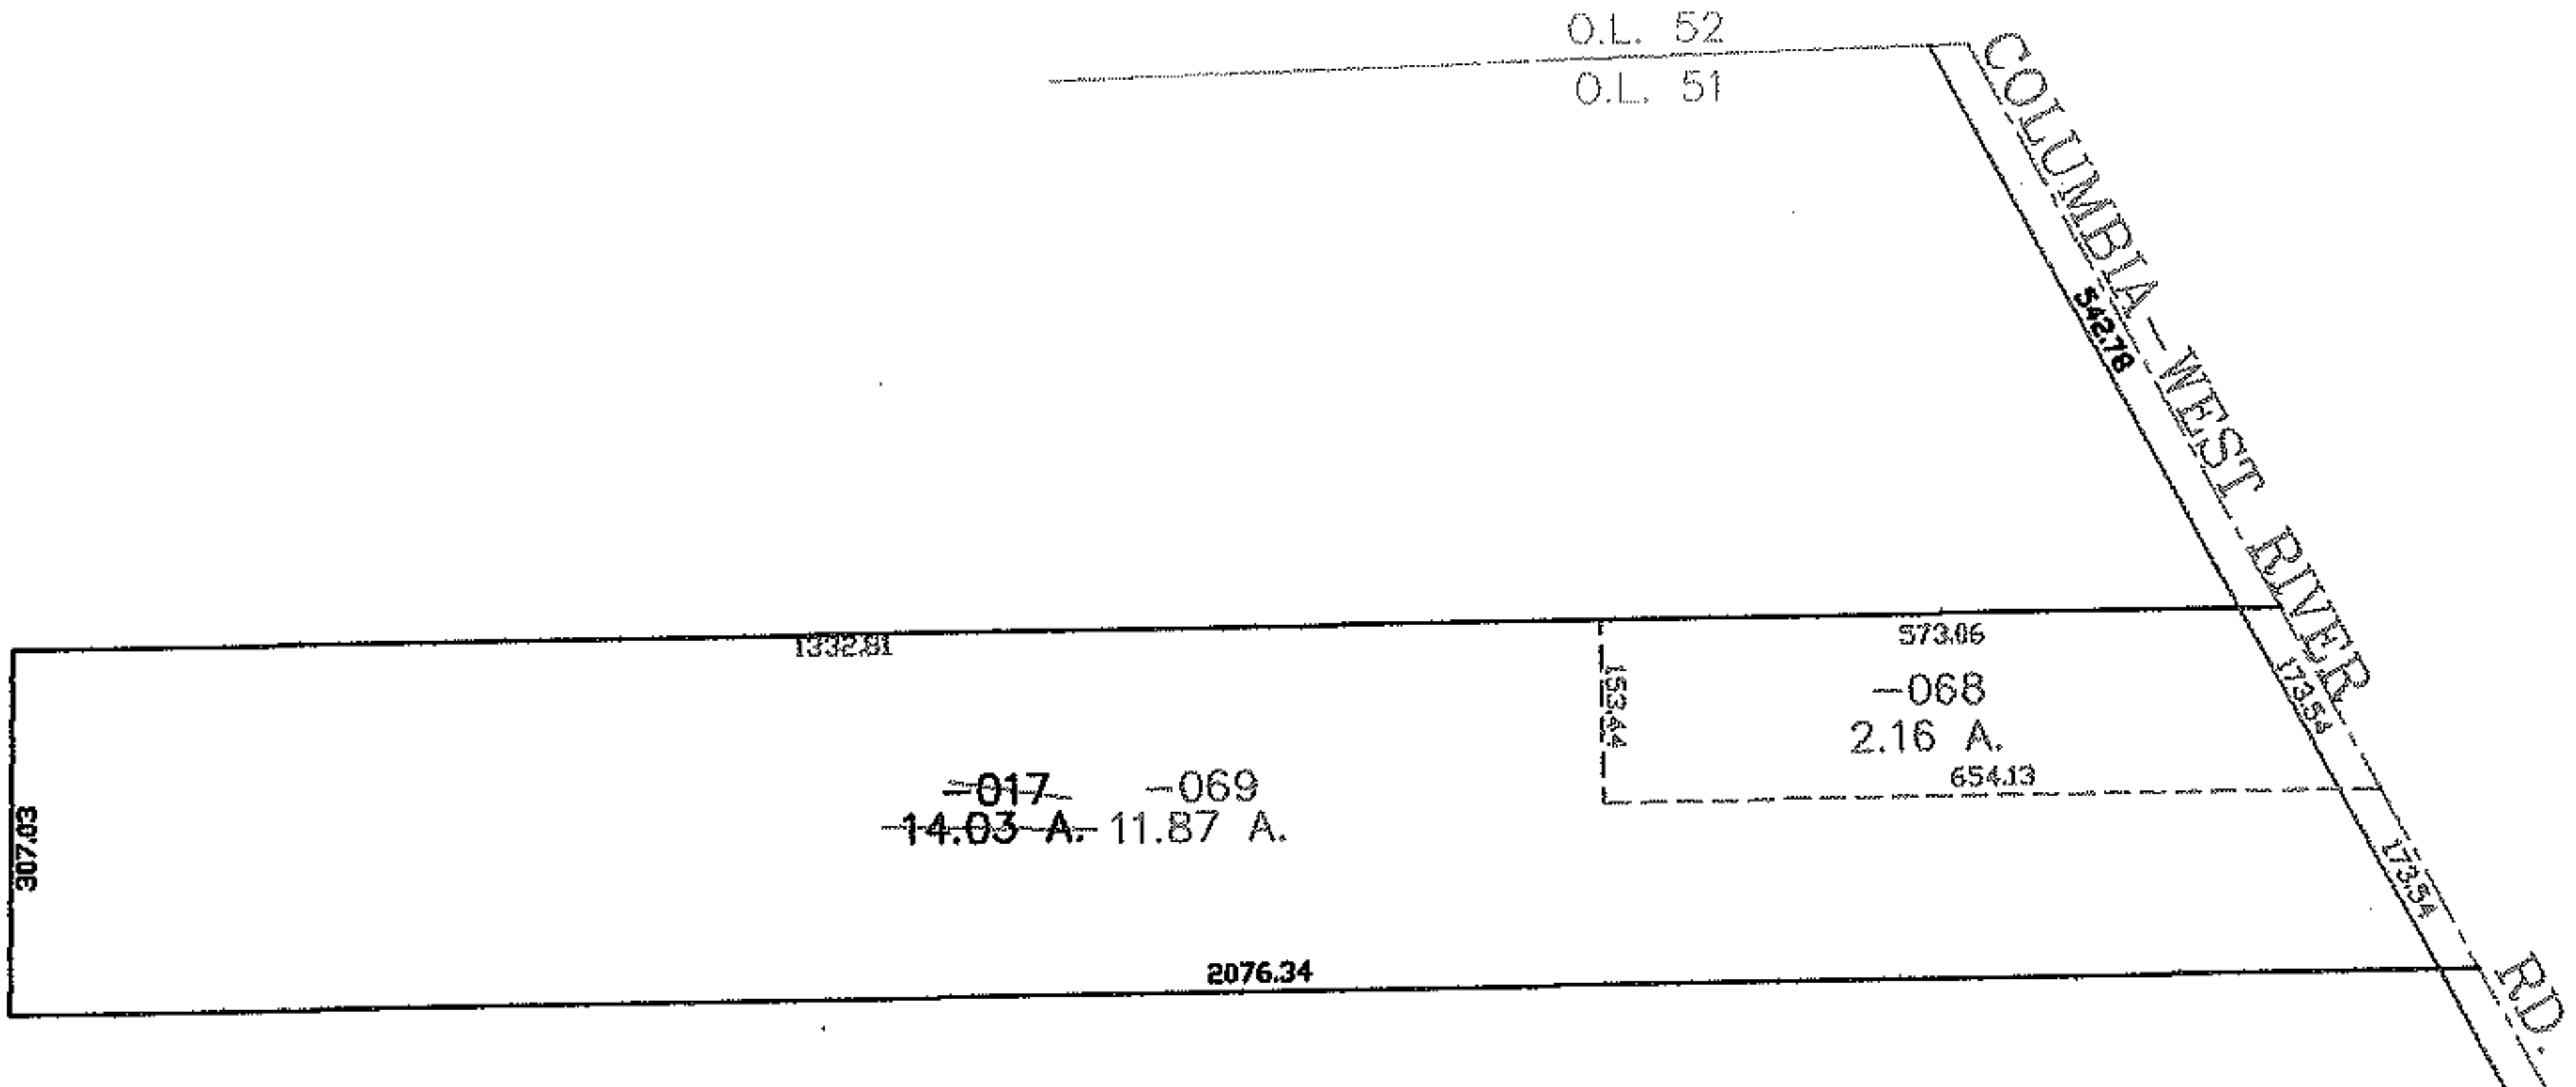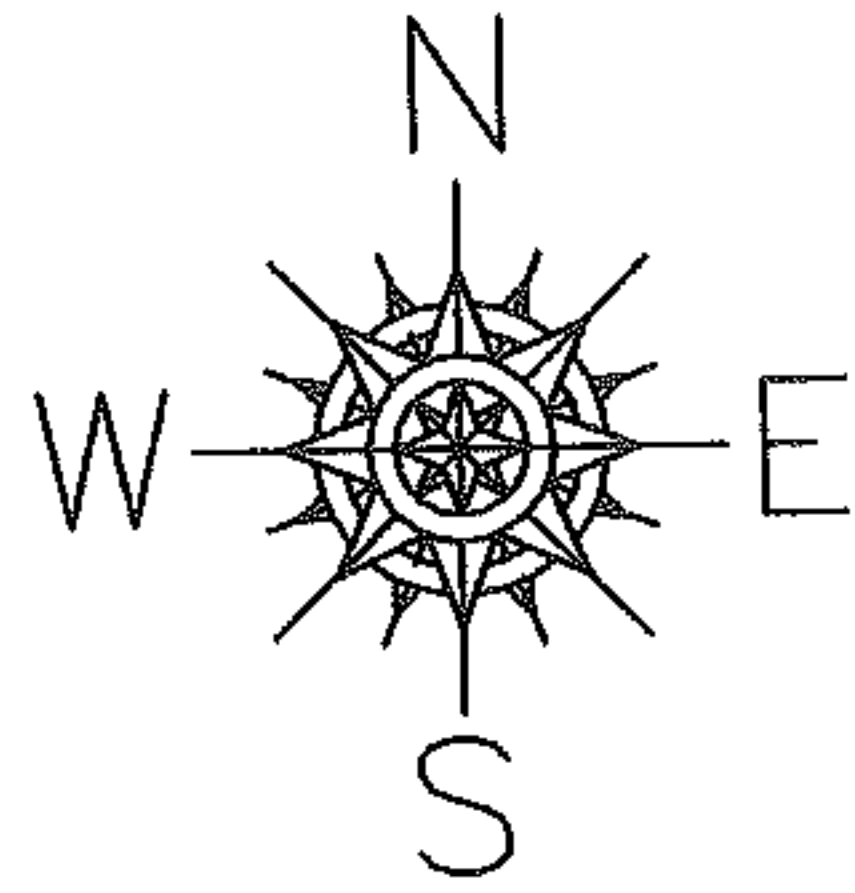

SPLITS/DEEDS PROCESSED
LORAIN COUNTY TAX MAP DEPARTMENT
226 MIDDLE AVE. ELYRIA, OHIO

SURVEYED BY: RICHARD CARLSON
 CLOSURE: 0.00 : 10.000
 MAP PAGE(S): 12-00-051-A
 APPROVED BY: JAH DATE: 2-7-05
 SCALE: 1" = 300 PRIOR INSTRUMENT: DV 1133/548