
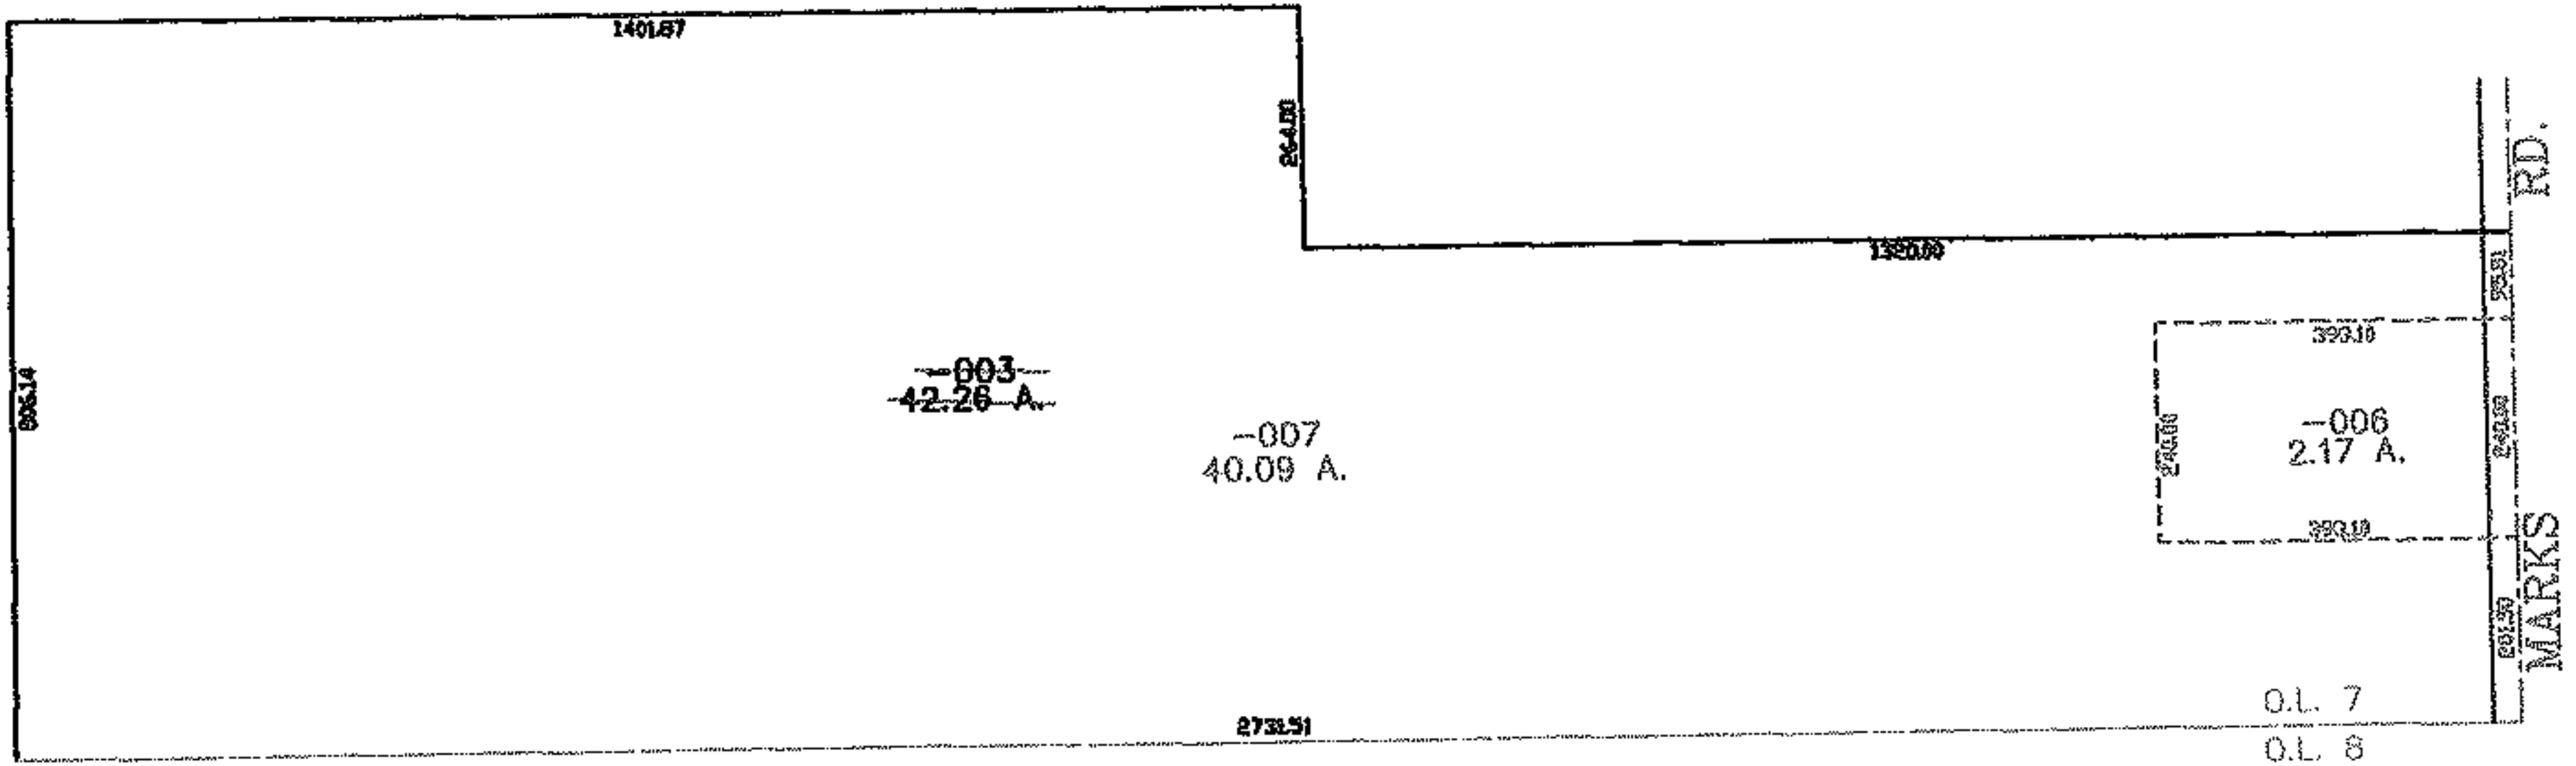


PARENT PARCEL: 12-00-007-000-003

CHILD PARCEL: 12-00-007-000-006, -007

STARTING POINT: CENTERLINE OF MARKS RD. & O.L. 7

NO. 01847

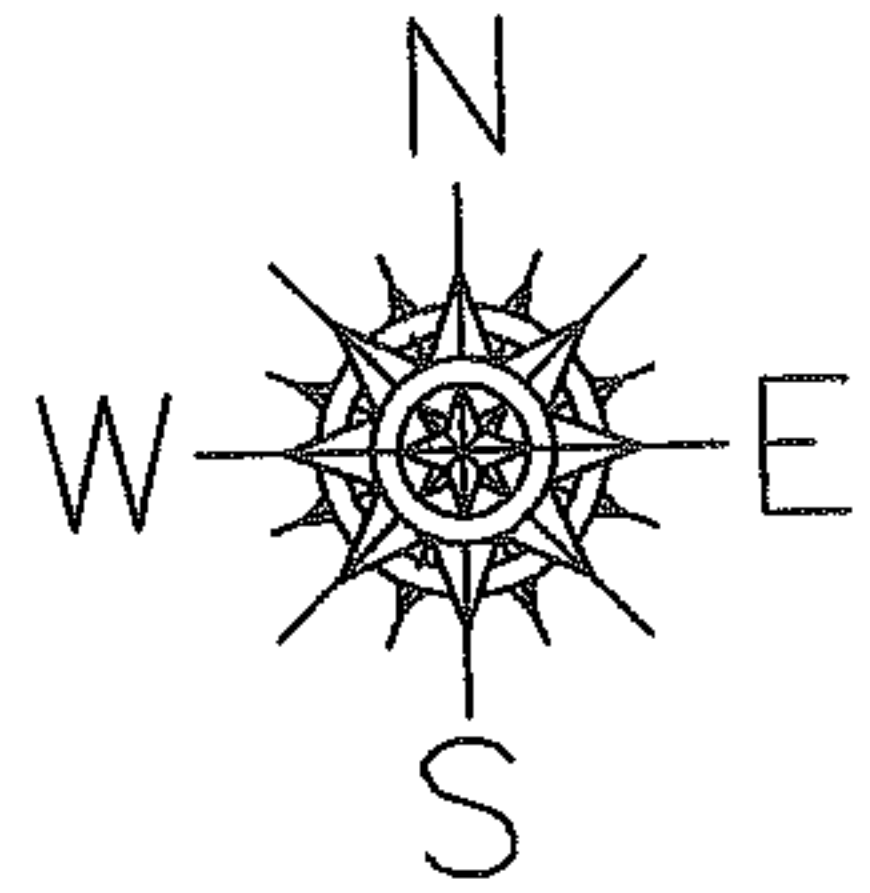

SPLITS/DEEDS PROCESSED  
LORAIN COUNTY TAX MAP DEPARTMENT  
226 MIDDLE AVE. ELYRIA, OHIO

SURVEYED BY: FREDRICK W. BOREMAN  
CLOSURE: 0.00 : 10.000  
MAP PAGE(S): 12-00-007-A  
APPROVED BY: JAH DATE: 2-8-05  
SCALE: 1" = 400 PRIOR INSTRUMENT: 990608954