




RASTER

PARENT PARCEL: 07-00-008-117-024

CHILD PARCEL: 07-00-008-117-078, -079

STARTING POINT: SOUTHEASTERLY CORNER OF S/L 22

NO. 01848

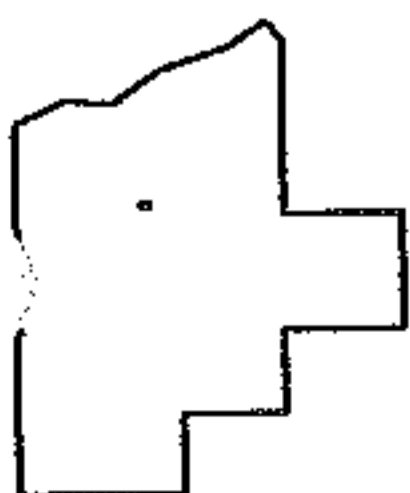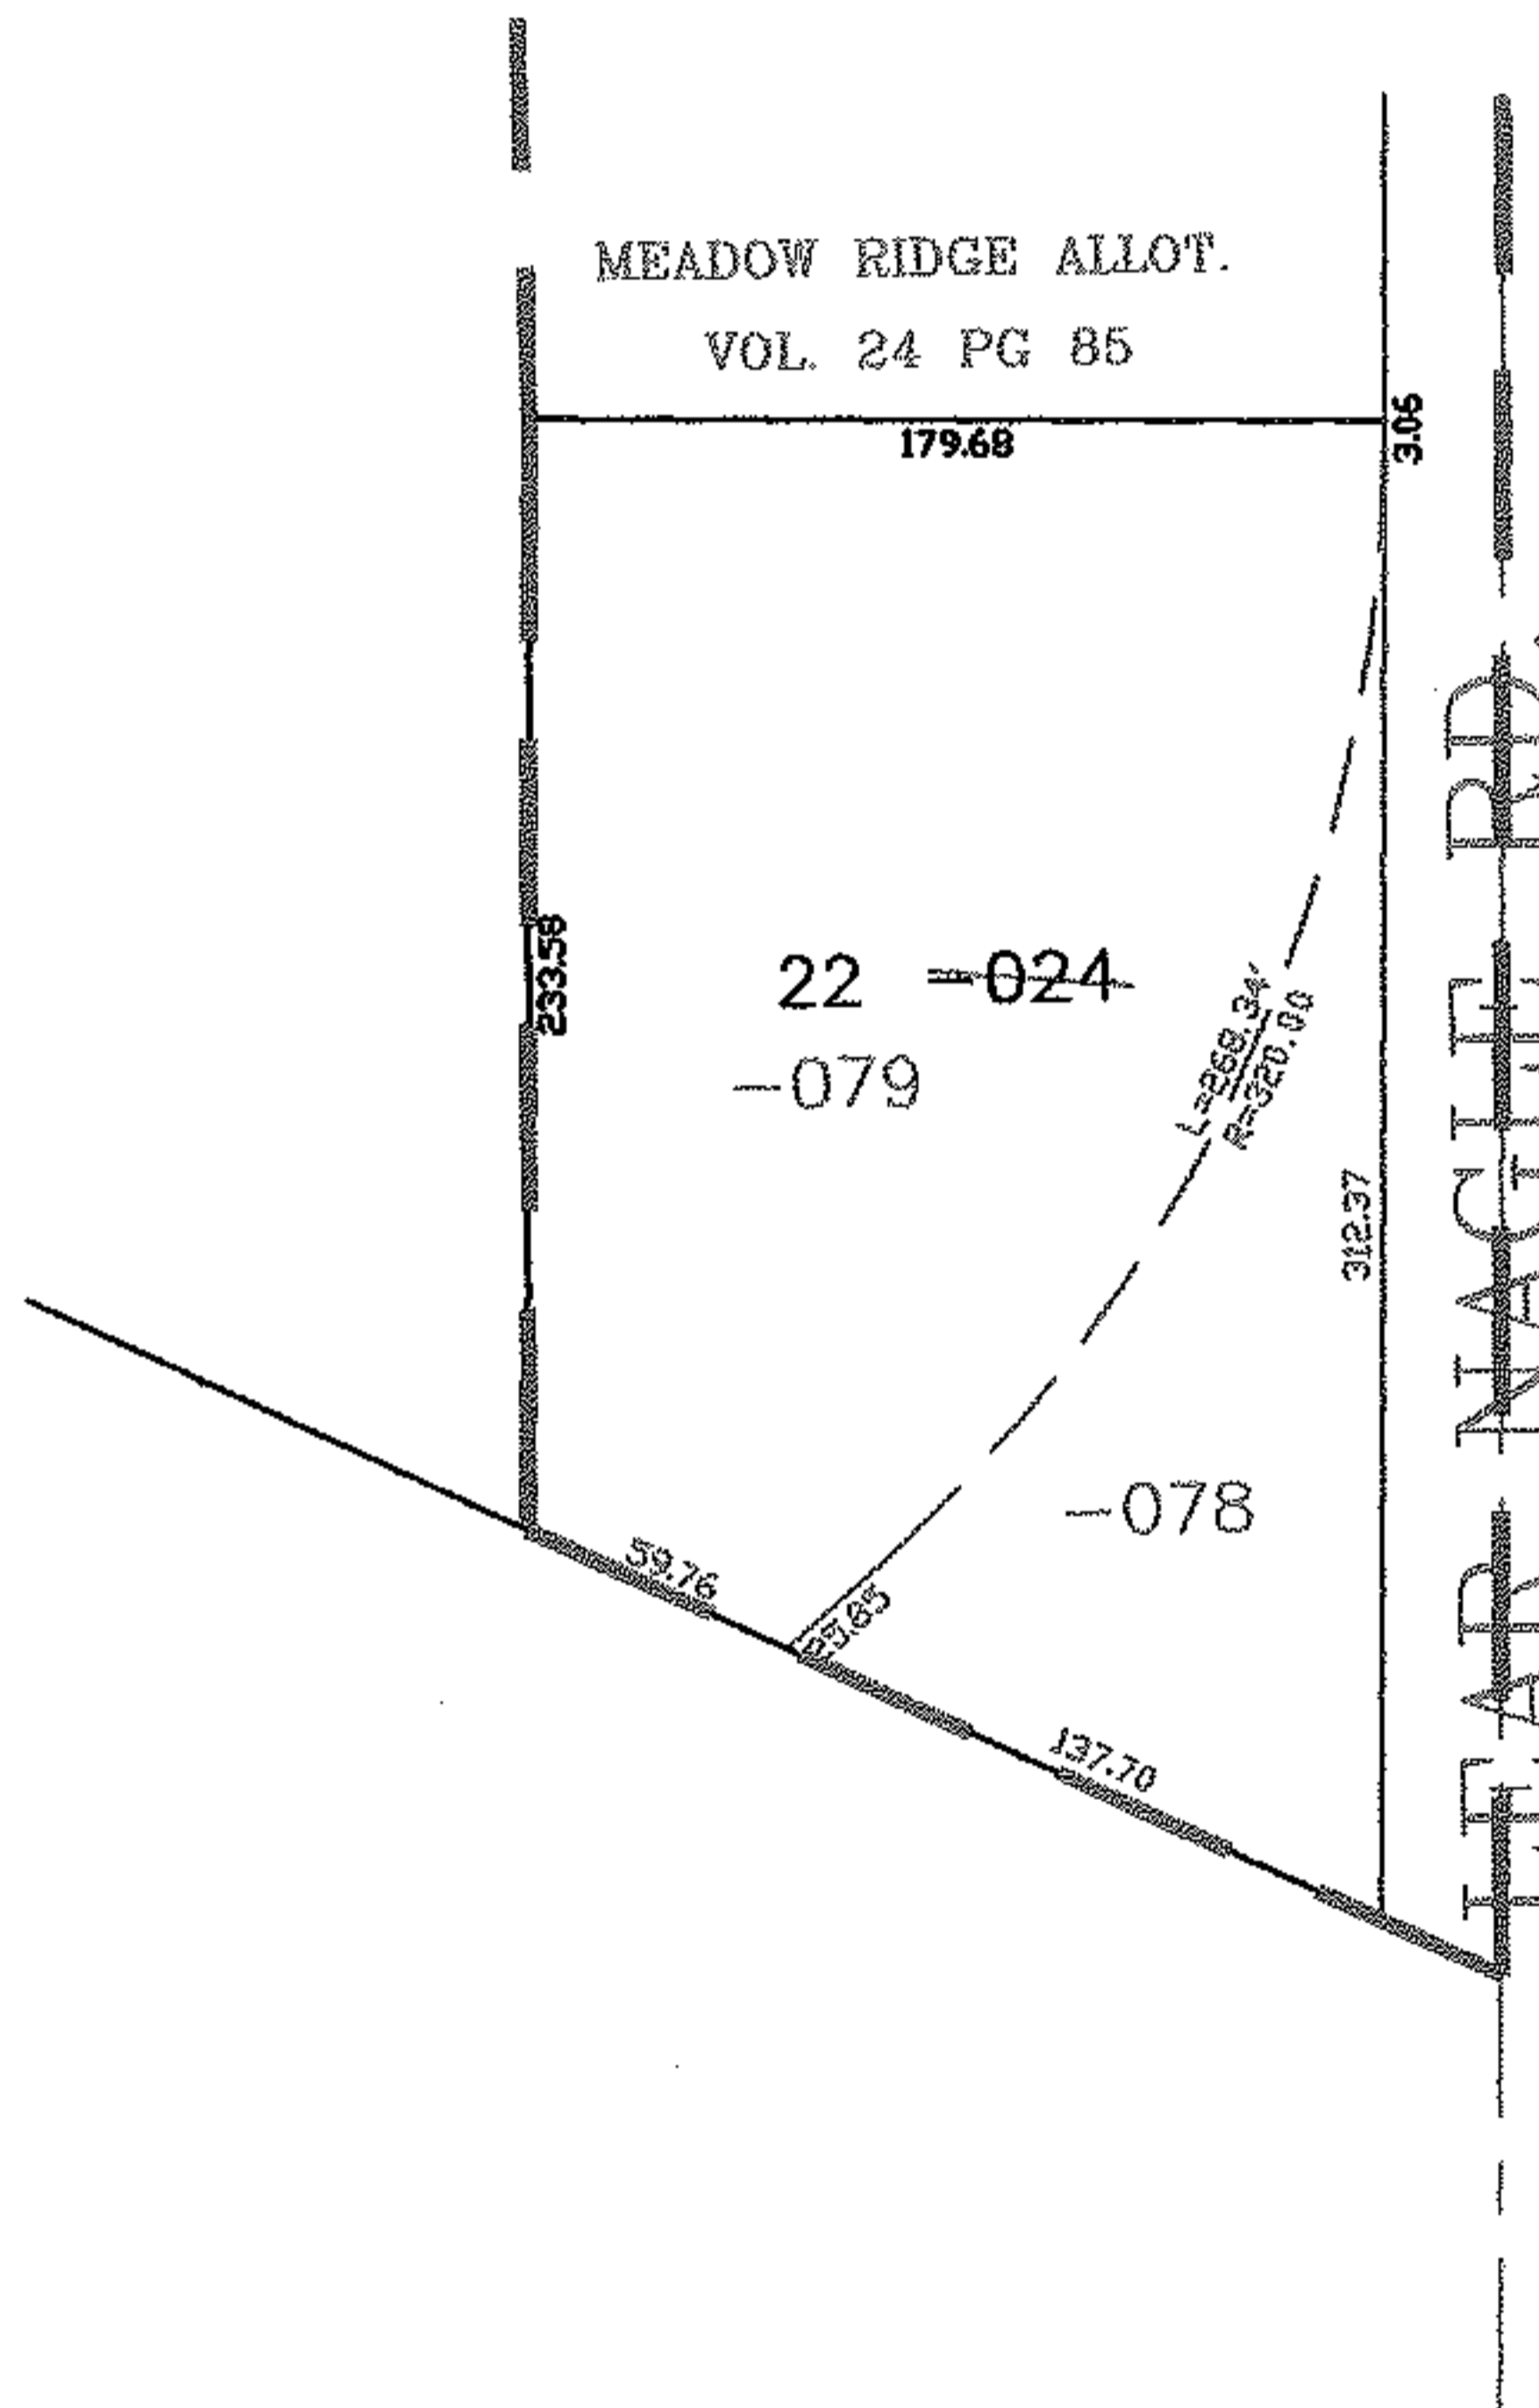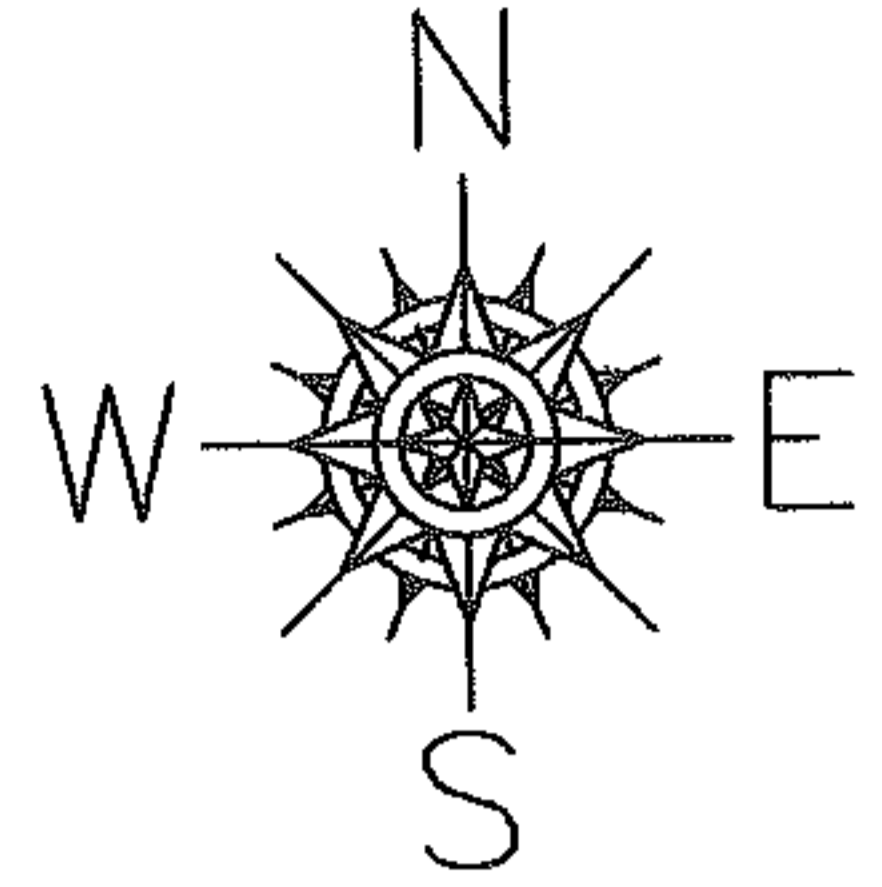

SPLITS/DEEDS PROCESSED

LORAIN COUNTY TAX MAP DEPARTMENT
226 MIDDLE AVE. ELYRIA, OHIO

SURVEYED BY: MARK YEAGER

CLOSURE: 0.00 : 10.000

MAP PAGE(S): 07-00-008-C

APPROVED BY: JAH DATE: 2-8-05

SCALE: 1" = 100 PRIOR INSTRUMENT: DV 957/292