




RASTER

PARENT PARCEL: 07-00-008-117-029 & -074

CHILD PARCEL: 07-00-008-117-080

STARTING POINT: CENTERLINE OF CENTER RIDGE RD. & LEAR NAGLE RD.

NO. 01849

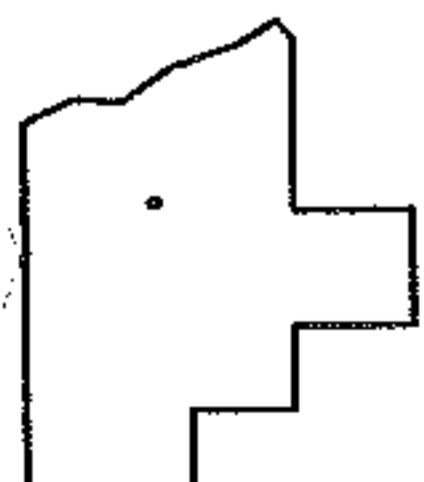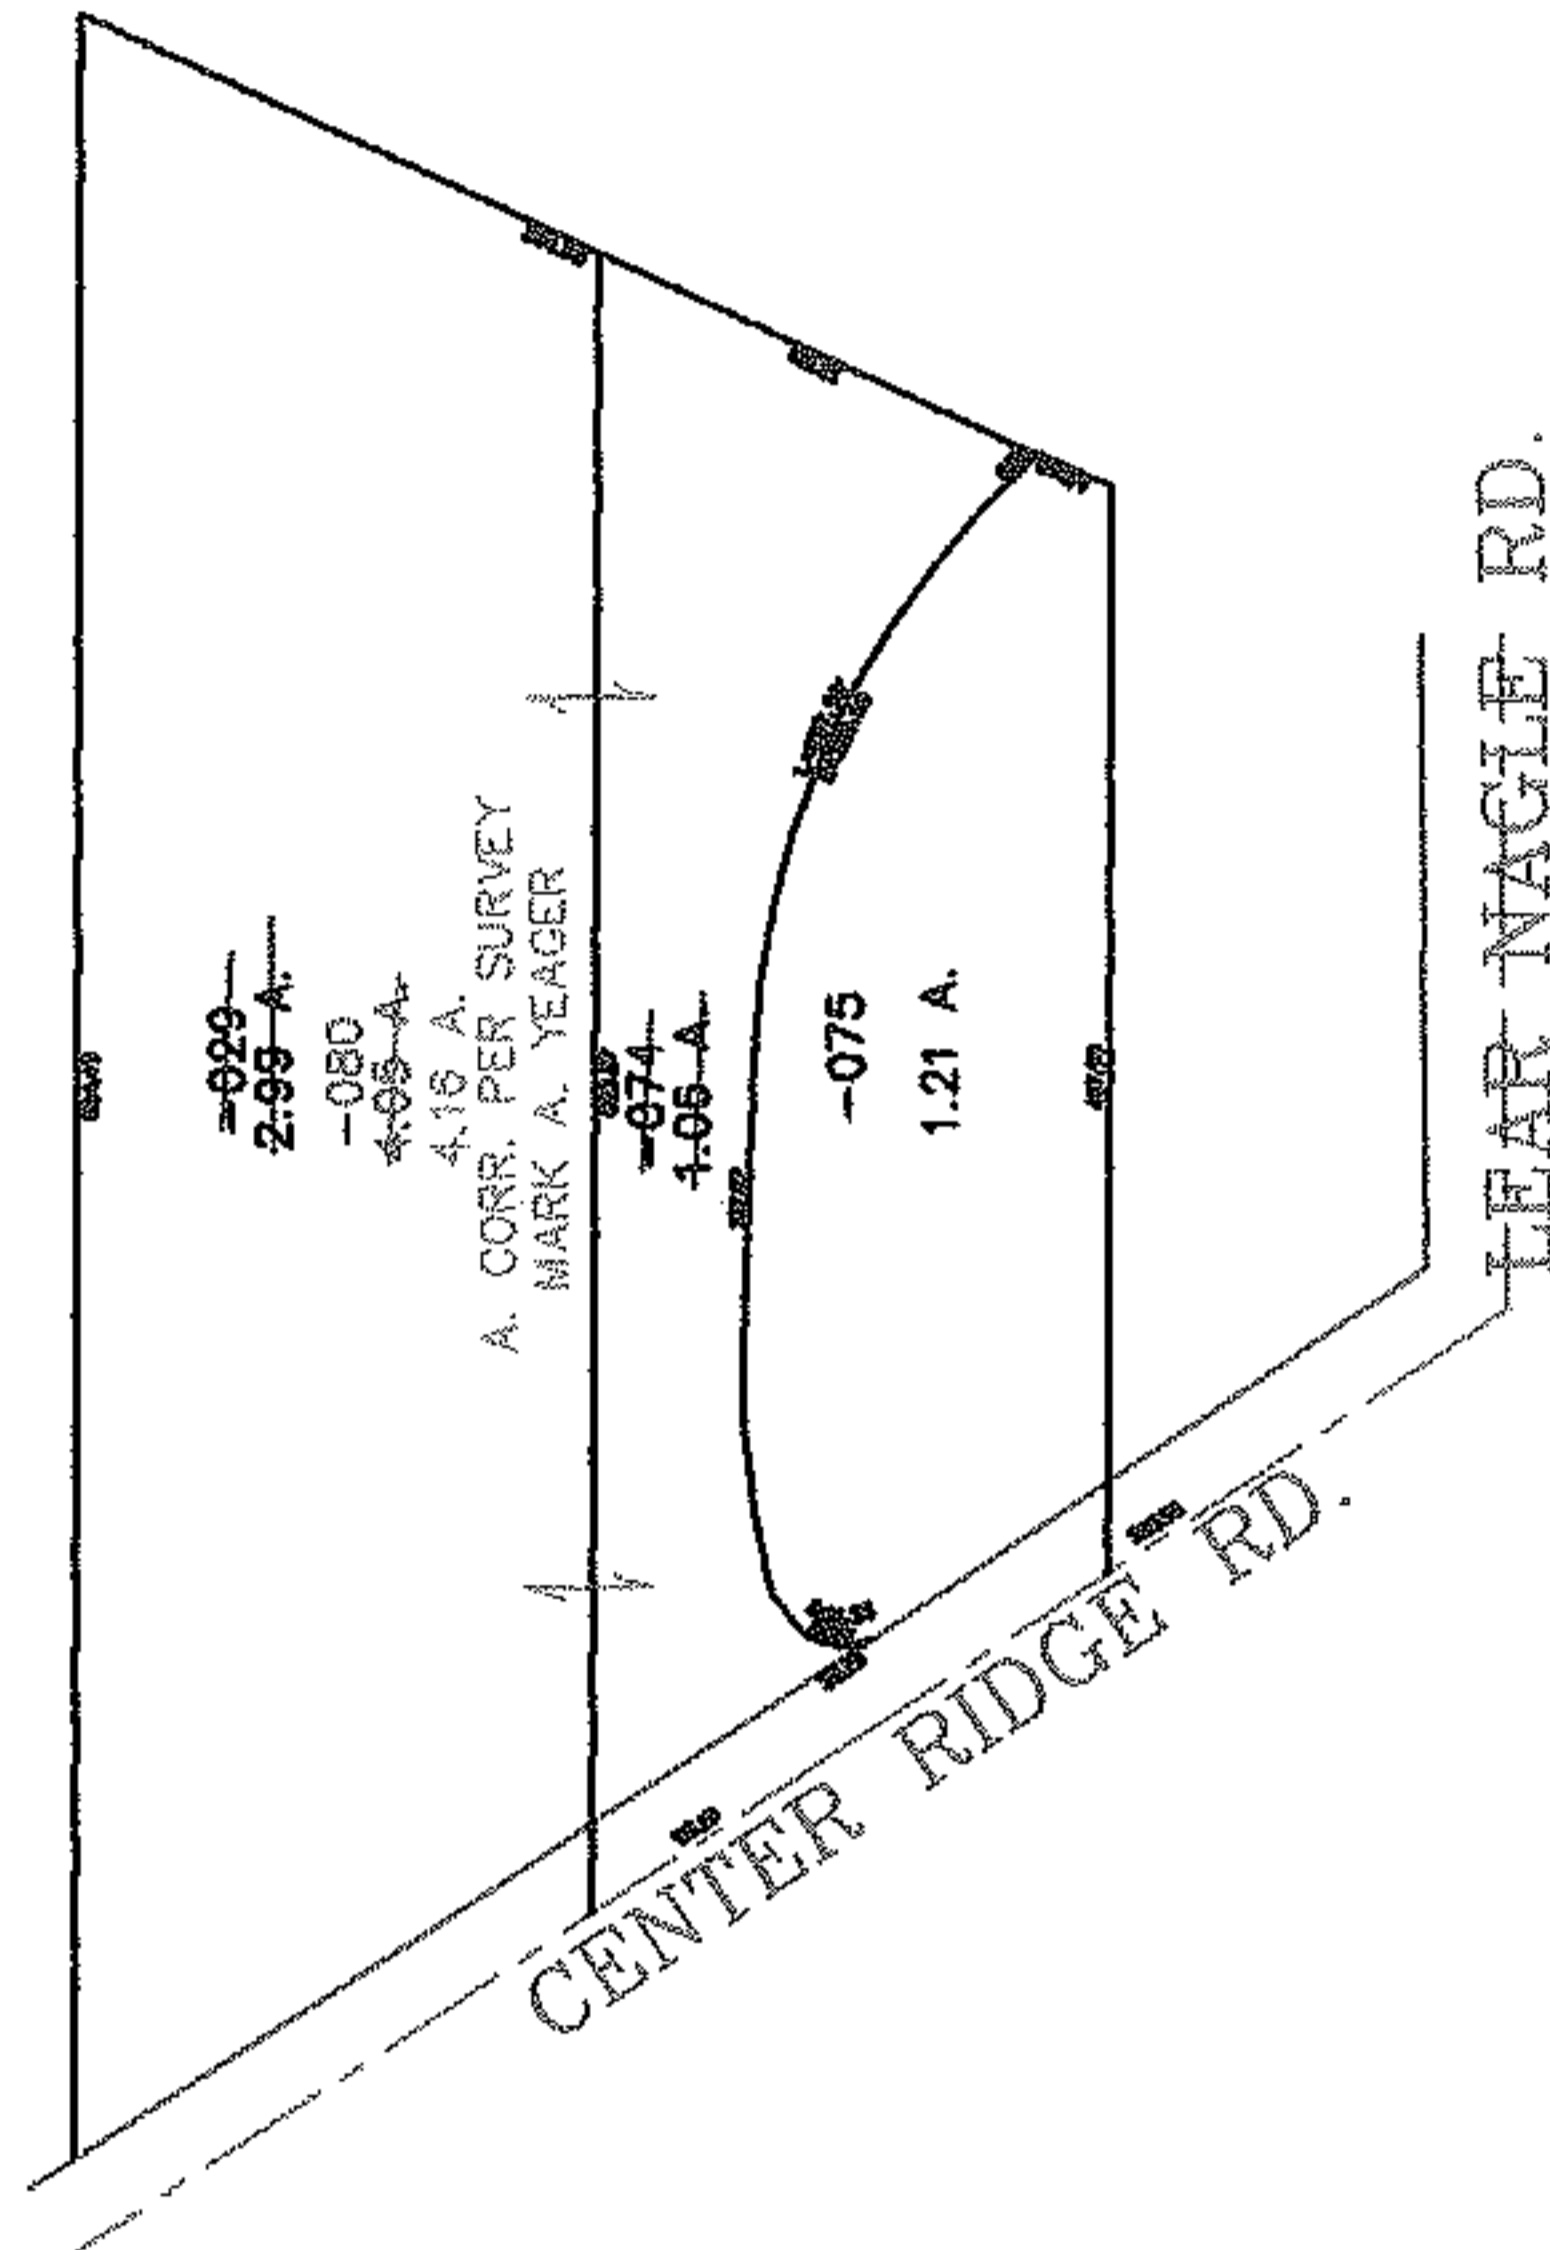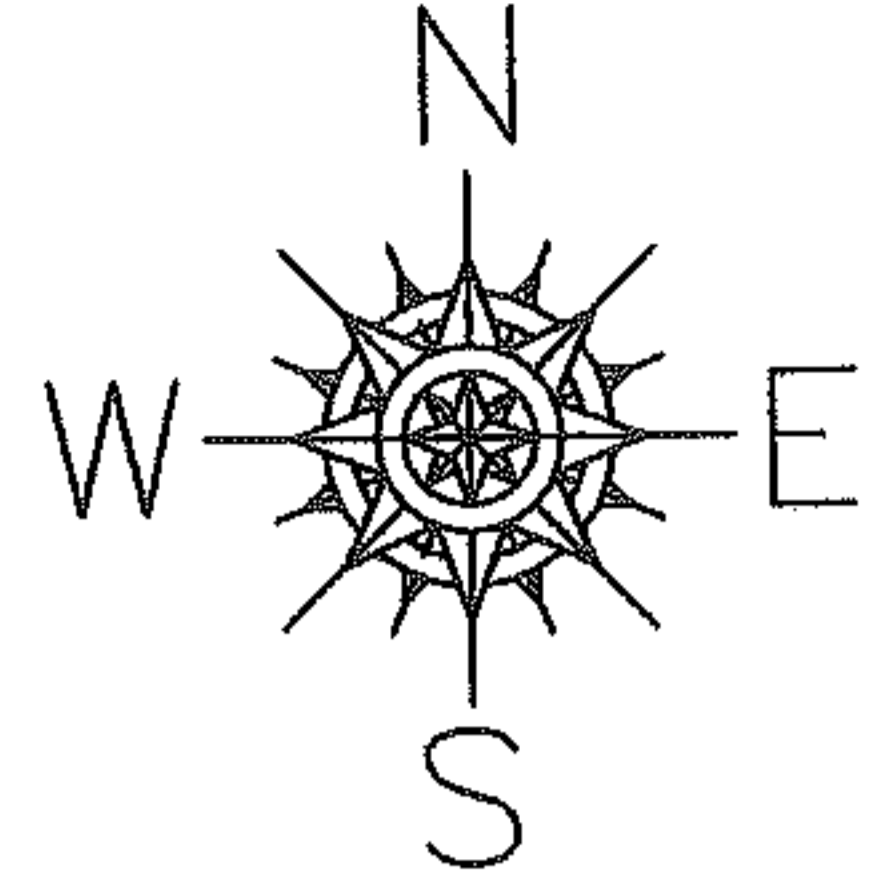

SPLITS/DEEDS PROCESSED
LORAIN COUNTY TAX MAP DEPARTMENT
226 MIDDLE AVE. ELYRIA, OHIO

SURVEYED BY: MARK A. YEAGER
CLOSURE: 0.00 : 10.000
MAP PAGE(S): 07-00-008-C
APPROVED BY: JAH DATE: 2-8-05
SCALE: 1" = 200 PRIOR INSTRUMENT: 20040046172