

MASTER


PARENT PARCEL: 20-05-009-000-030

CHILD PARCEL: SAME



STARTING POINT: CL OF BURSLEY RD AT NE CORNER FROMBAUGH PROPERTY

NO. 09-01853-C

ACREAGE CORRECTION PER SURVEY
FROM 4.78 A. TO 4.75 A.

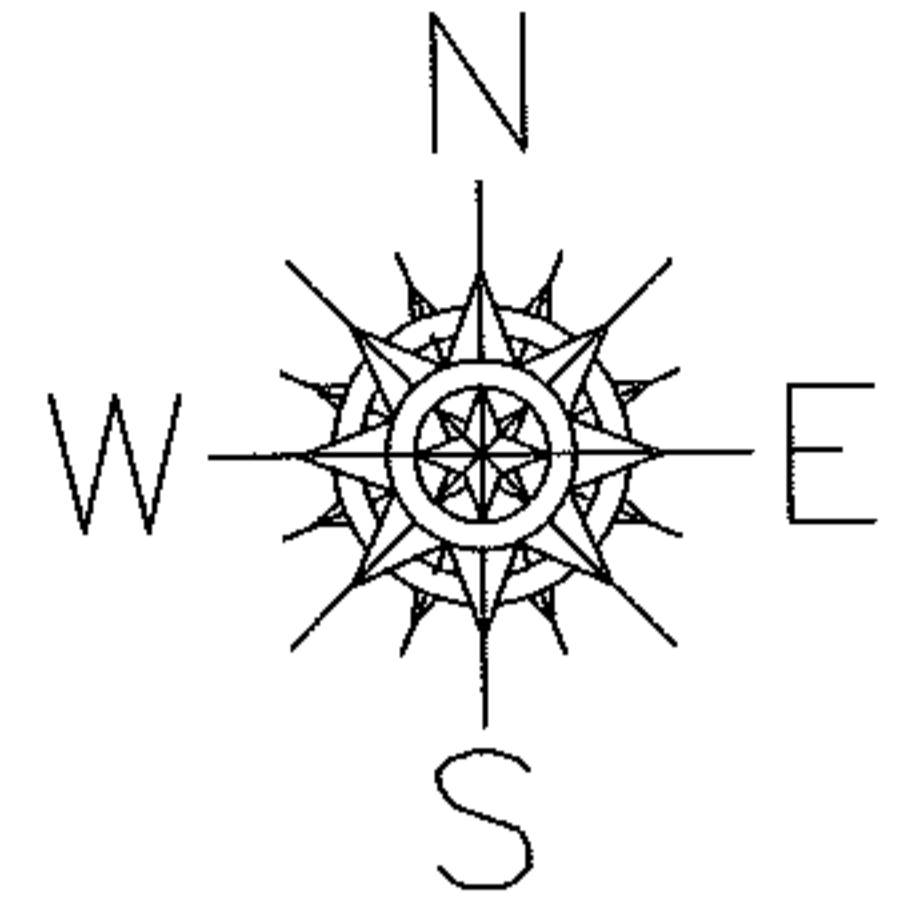

BURSLEY ROAD

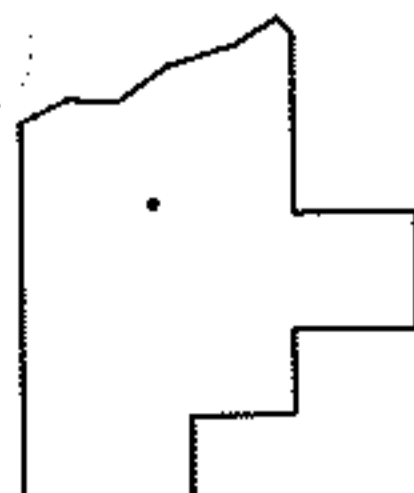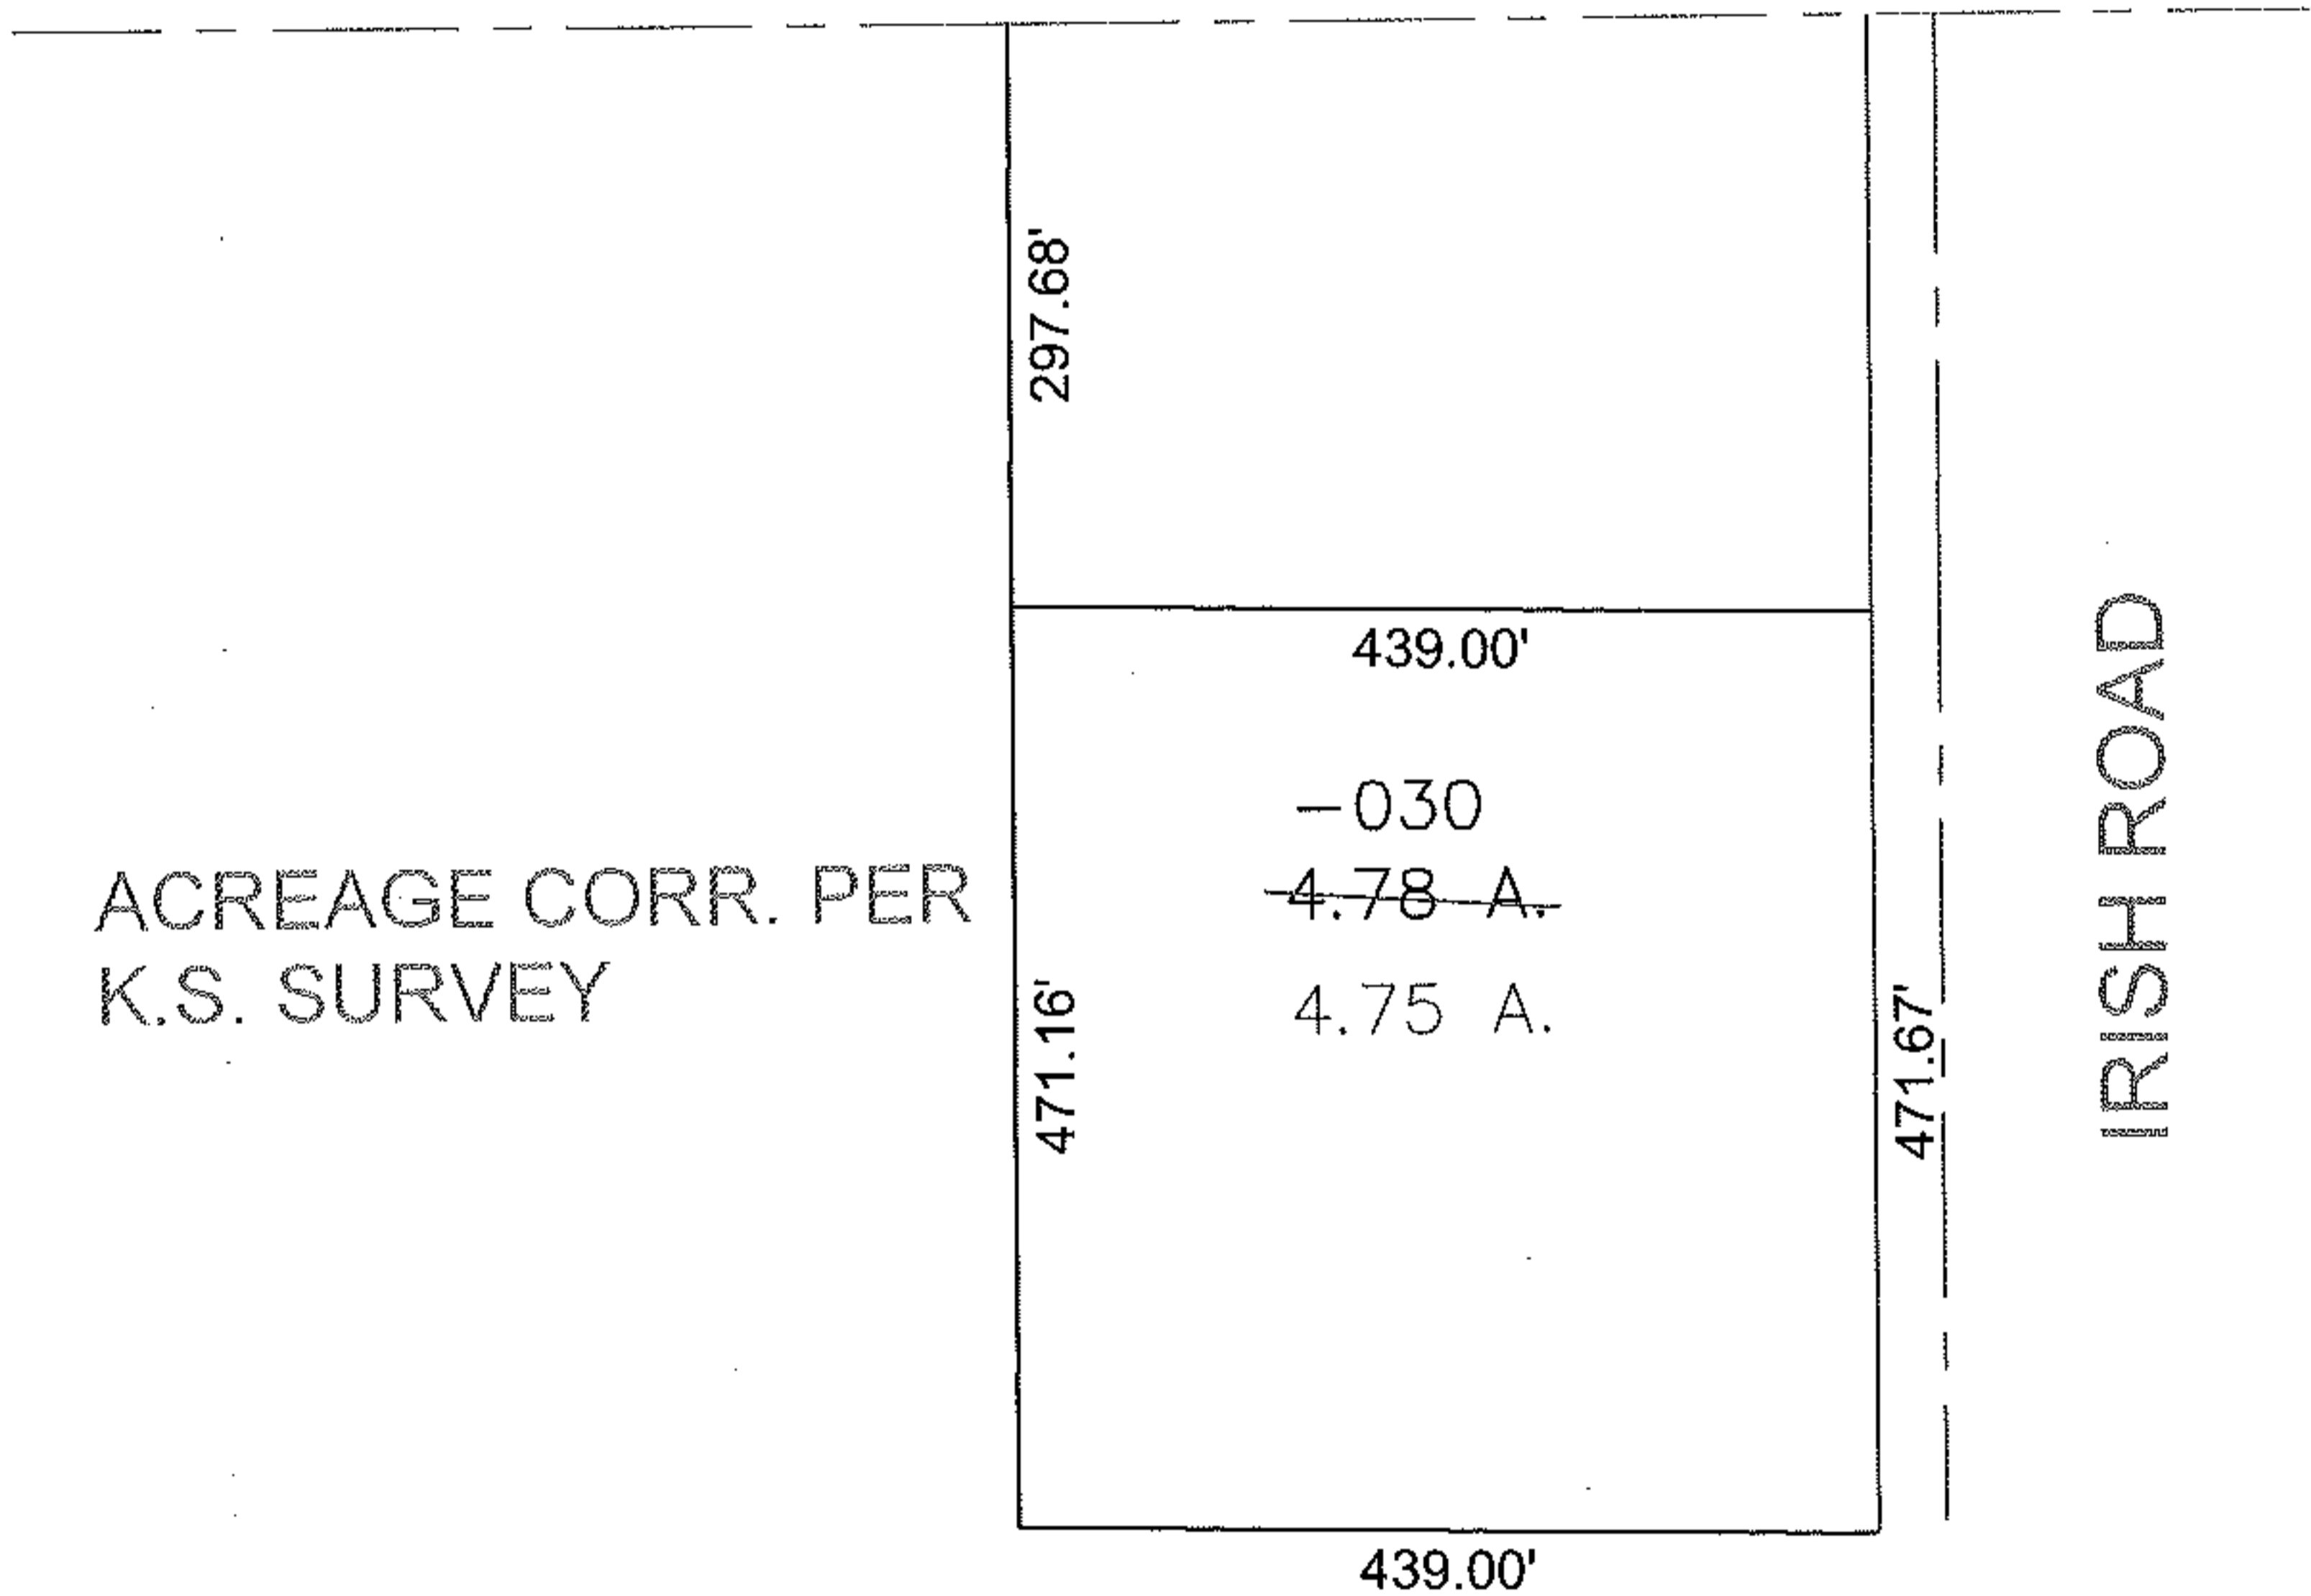

SPLITS/DEEDS PROCESSED
LORAIN COUNTY TAX MAP DEPARTMENT
226 MIDDLE AVE. ELYRIA, OHIO

SURVEYED BY: KLEINOEDER-SCHMIDT & ASSOC.
CLOSURE: 1:10,000
MAP PAGE(S): 20-D
APPROVED BY: MBK DATE: 06/26/2009
SCALE: 1" = 200 PRIOR INSTRUMENT: 20090300772