
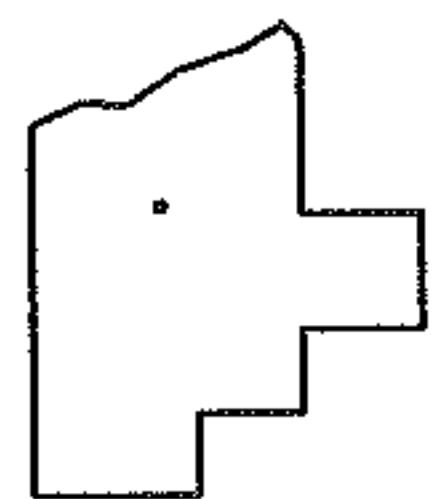
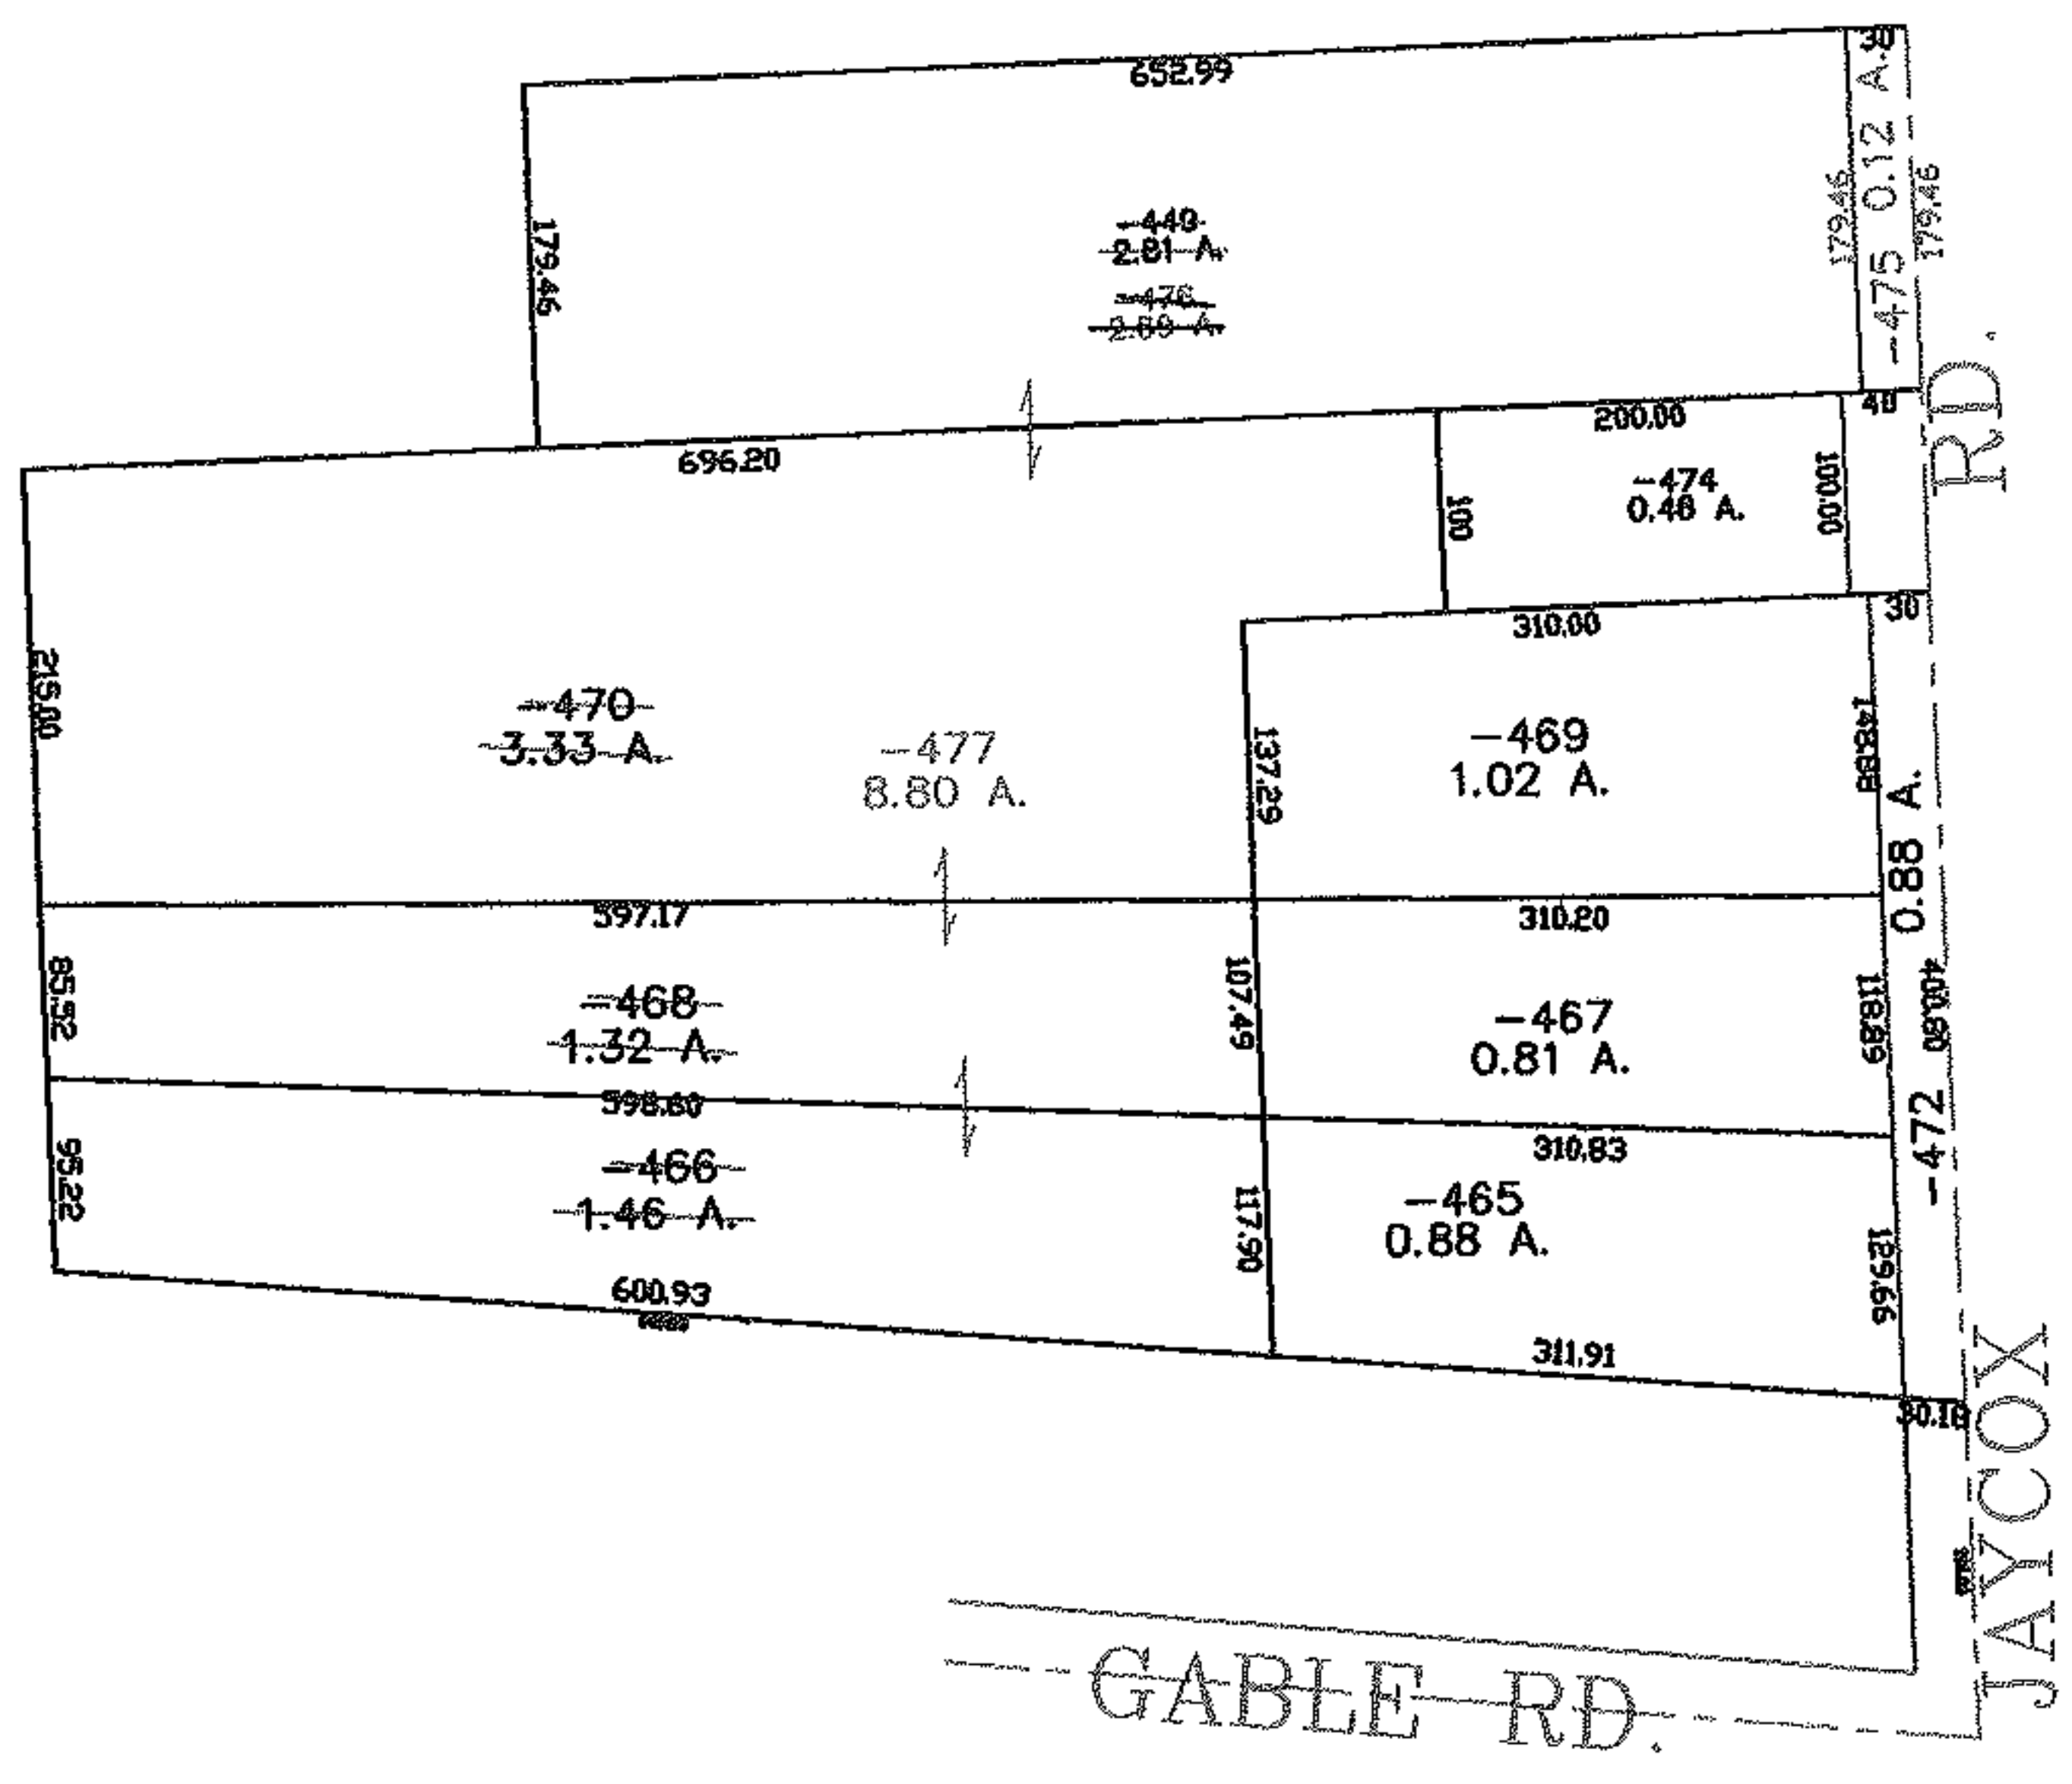


PARENT PARCEL: 04-00-019-143-449
CHILD PARCEL: 04-00-019-143-475 THRU -477
STARTING POINT: CENTERLINE OF GABLE RD. & JAYCOX RD.

NO. 01853

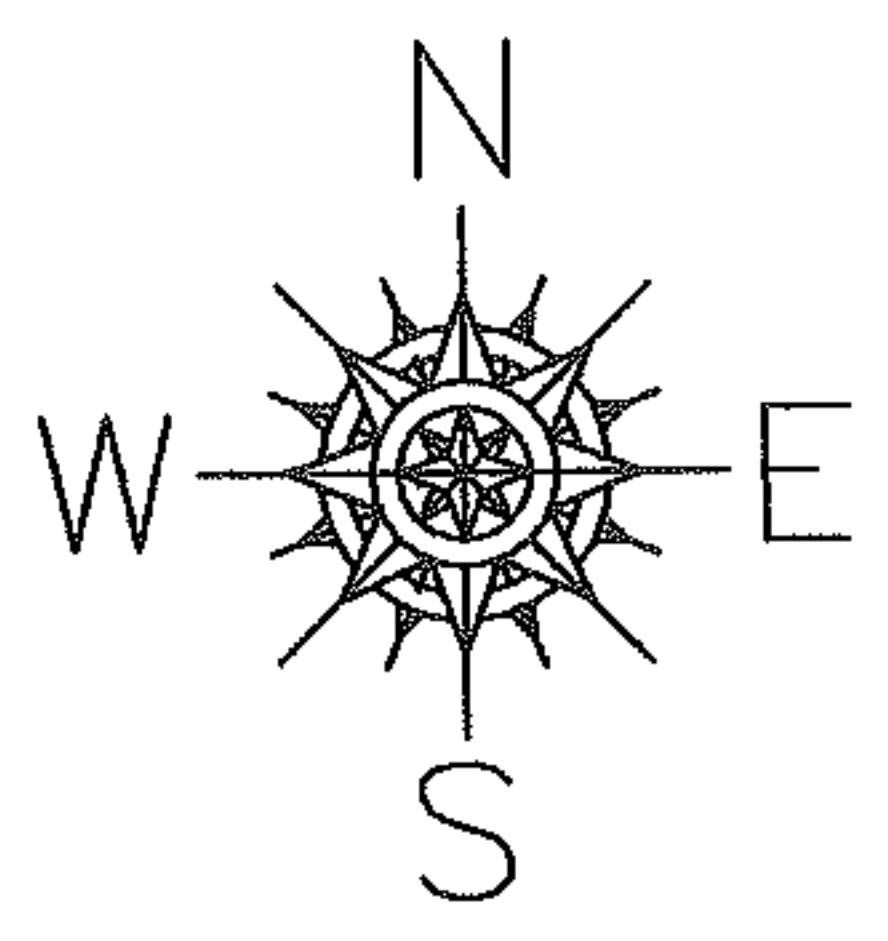

SPLITS/DEEDS PROCESSED
LORAIN COUNTY TAX MAP DEPARTMENT
226 MIDDLE AVE. ELYRIA, OHIO

SURVEYED BY: HENRY REITZ
CLOSURE: 0.00 : 10.000
MAP PAGE(S): 04-00-019-F
APPROVED BY: JAH DATE: 2-17-05
SCALE: 1" = 200 PRIOR INSTRUMENT: 20050050801