



MASTER

PARENT PARCEL: 07-00-008-117-080

CHILD PARCEL: 07-00-008-117-081, -082, -083

STARTING POINT: CENTERLINE OF LEAR NAGLE RD. & CENTER RIDGE RD.

NO. 01855

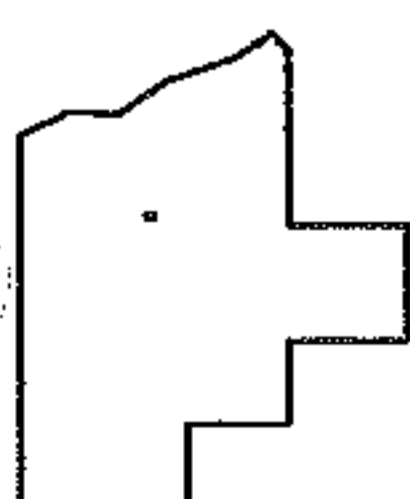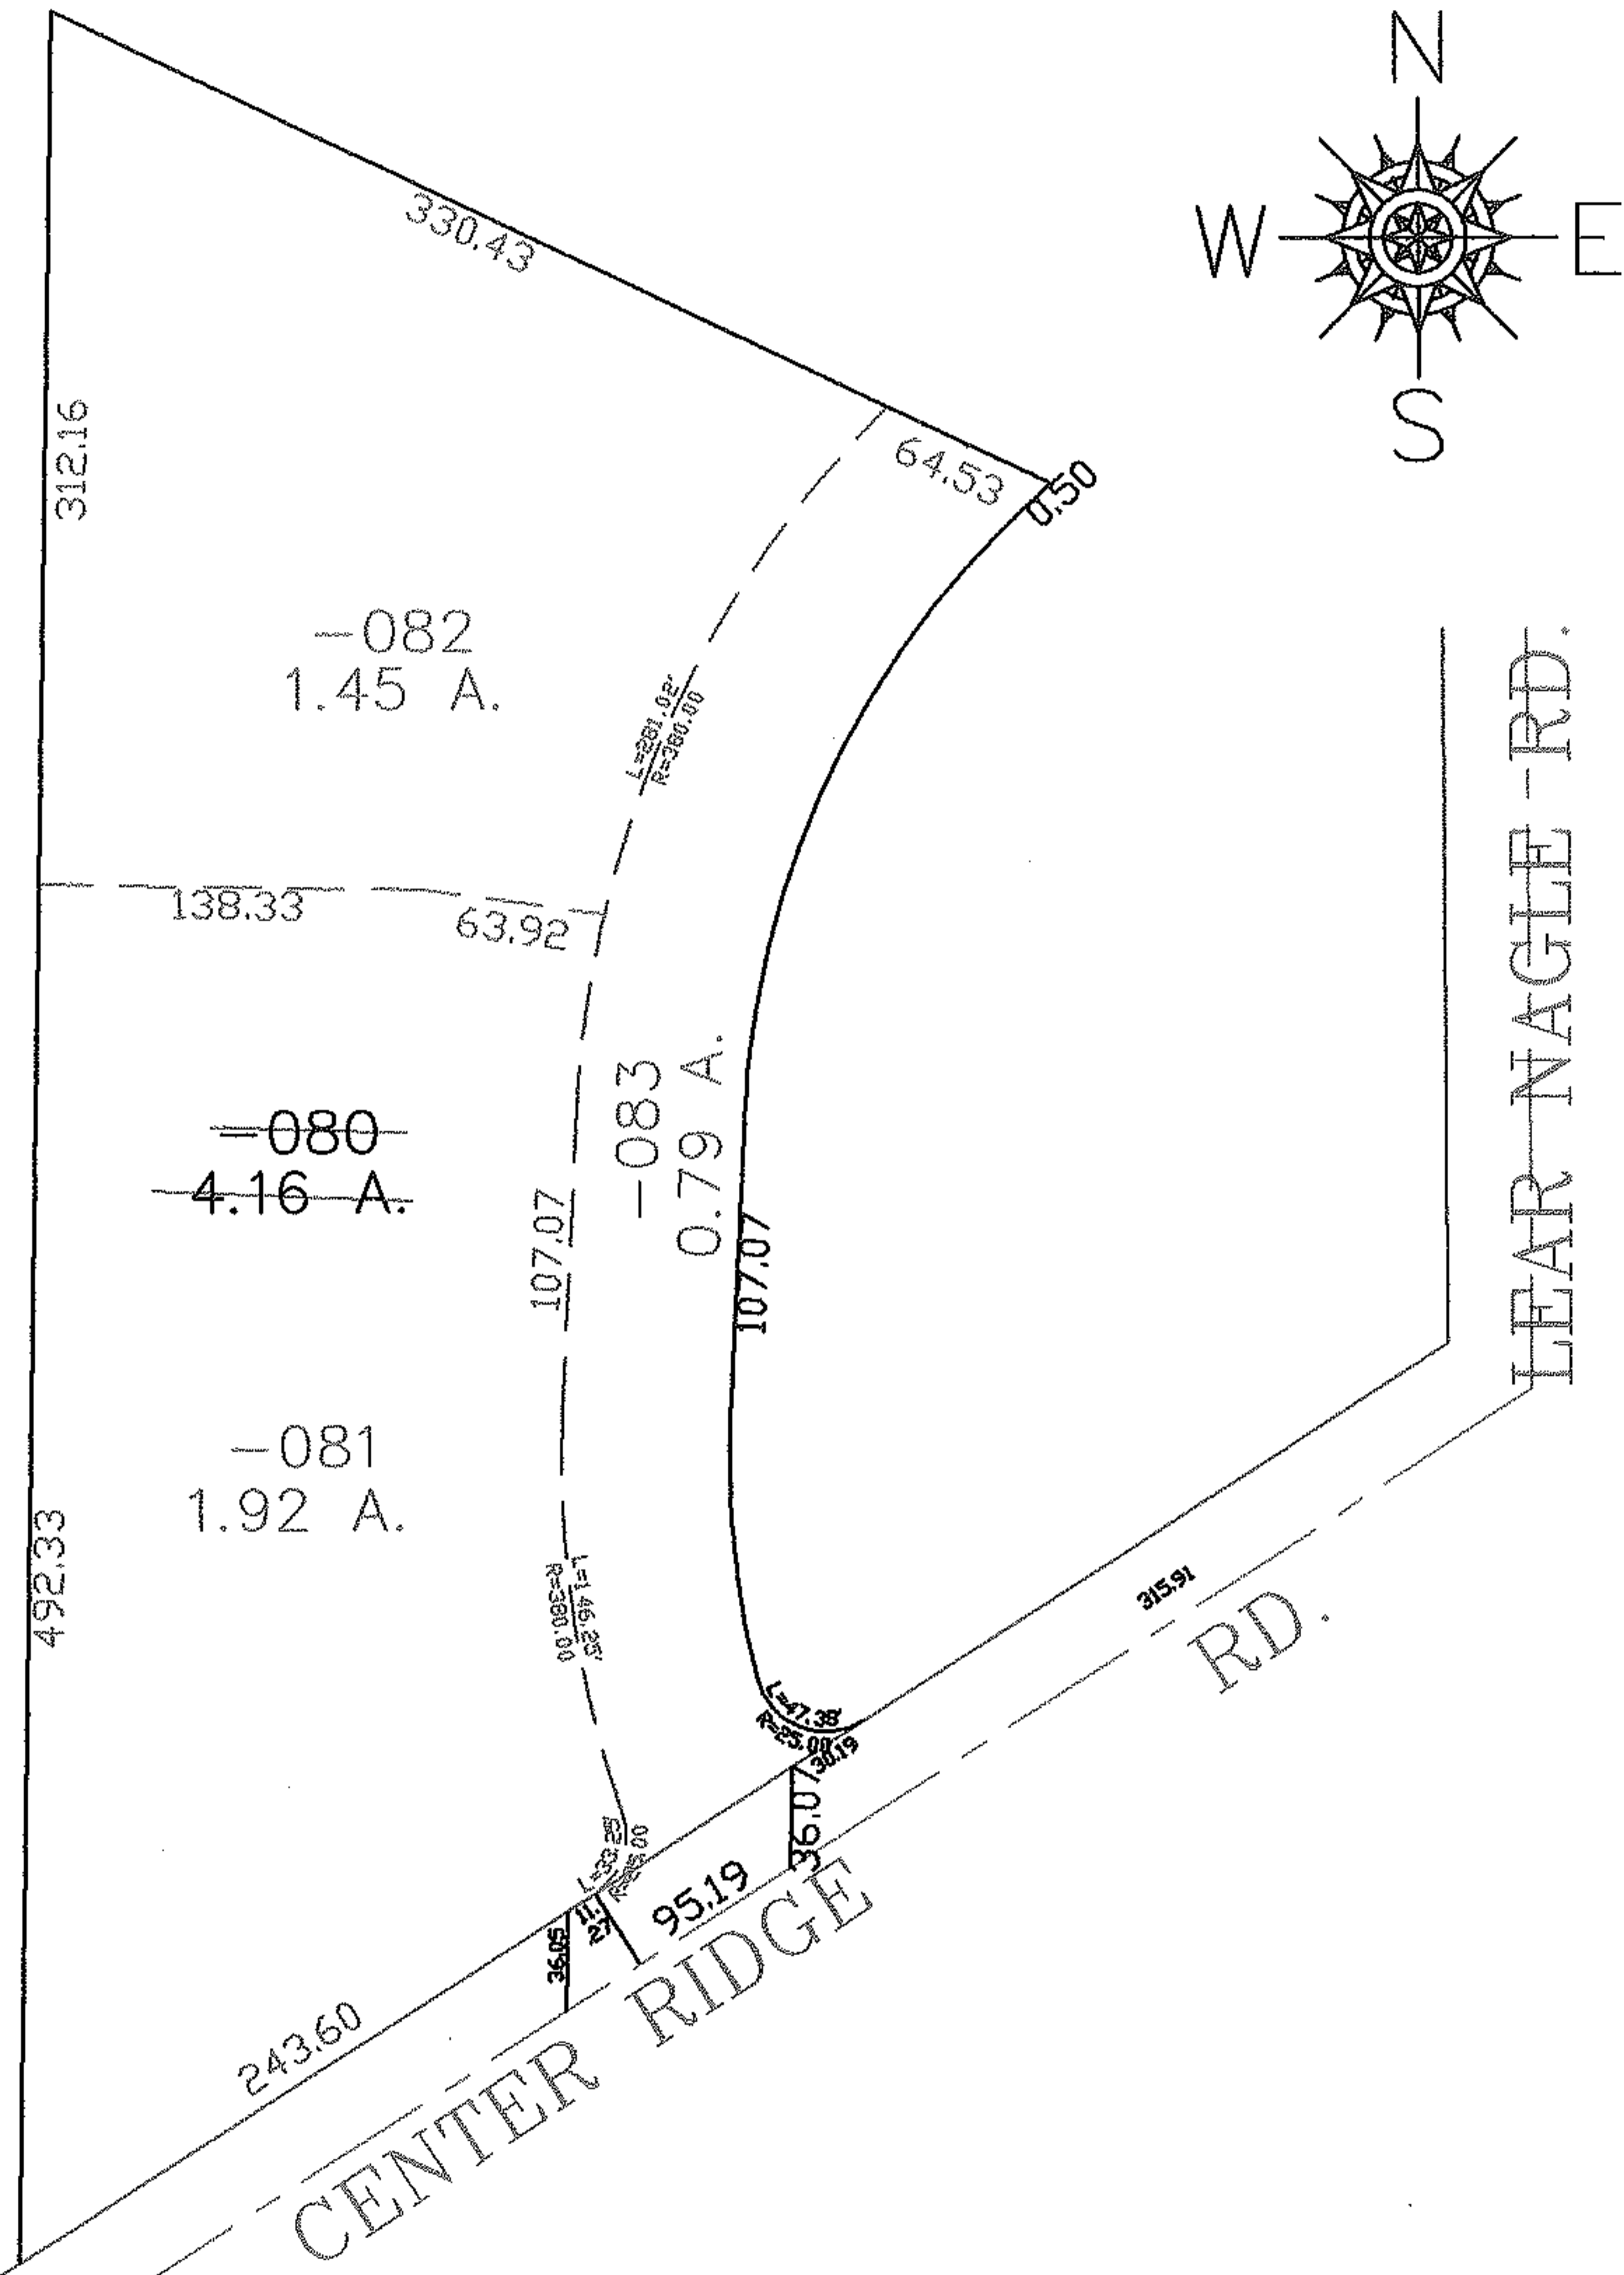

**SPLITS/DEEDS PROCESSED**

LORAIN COUNTY TAX MAP DEPARTMENT  
226 MIDDLE AVE. ELYRIA, OHIO

SURVEYED BY: MARK A. YEAGER

CLOSURE: 0.00 : 10.000

MAP PAGE(S): 7-00-008-C

APPROVED BY: JAH DATE: 2-8-05

SCALE: 1" = 100 PRIOR INSTRUMENT: 19990659814