

MASTER



PARENT PARCEL: 03-00-060-000-007

CHILD PARCEL: --SAME--

STARTING POINT: INT CL TRAXLER DR AND OLD COLORADO AVE

09-01858-C

AC. CORR. PER SURVEY DAVID ELWELL

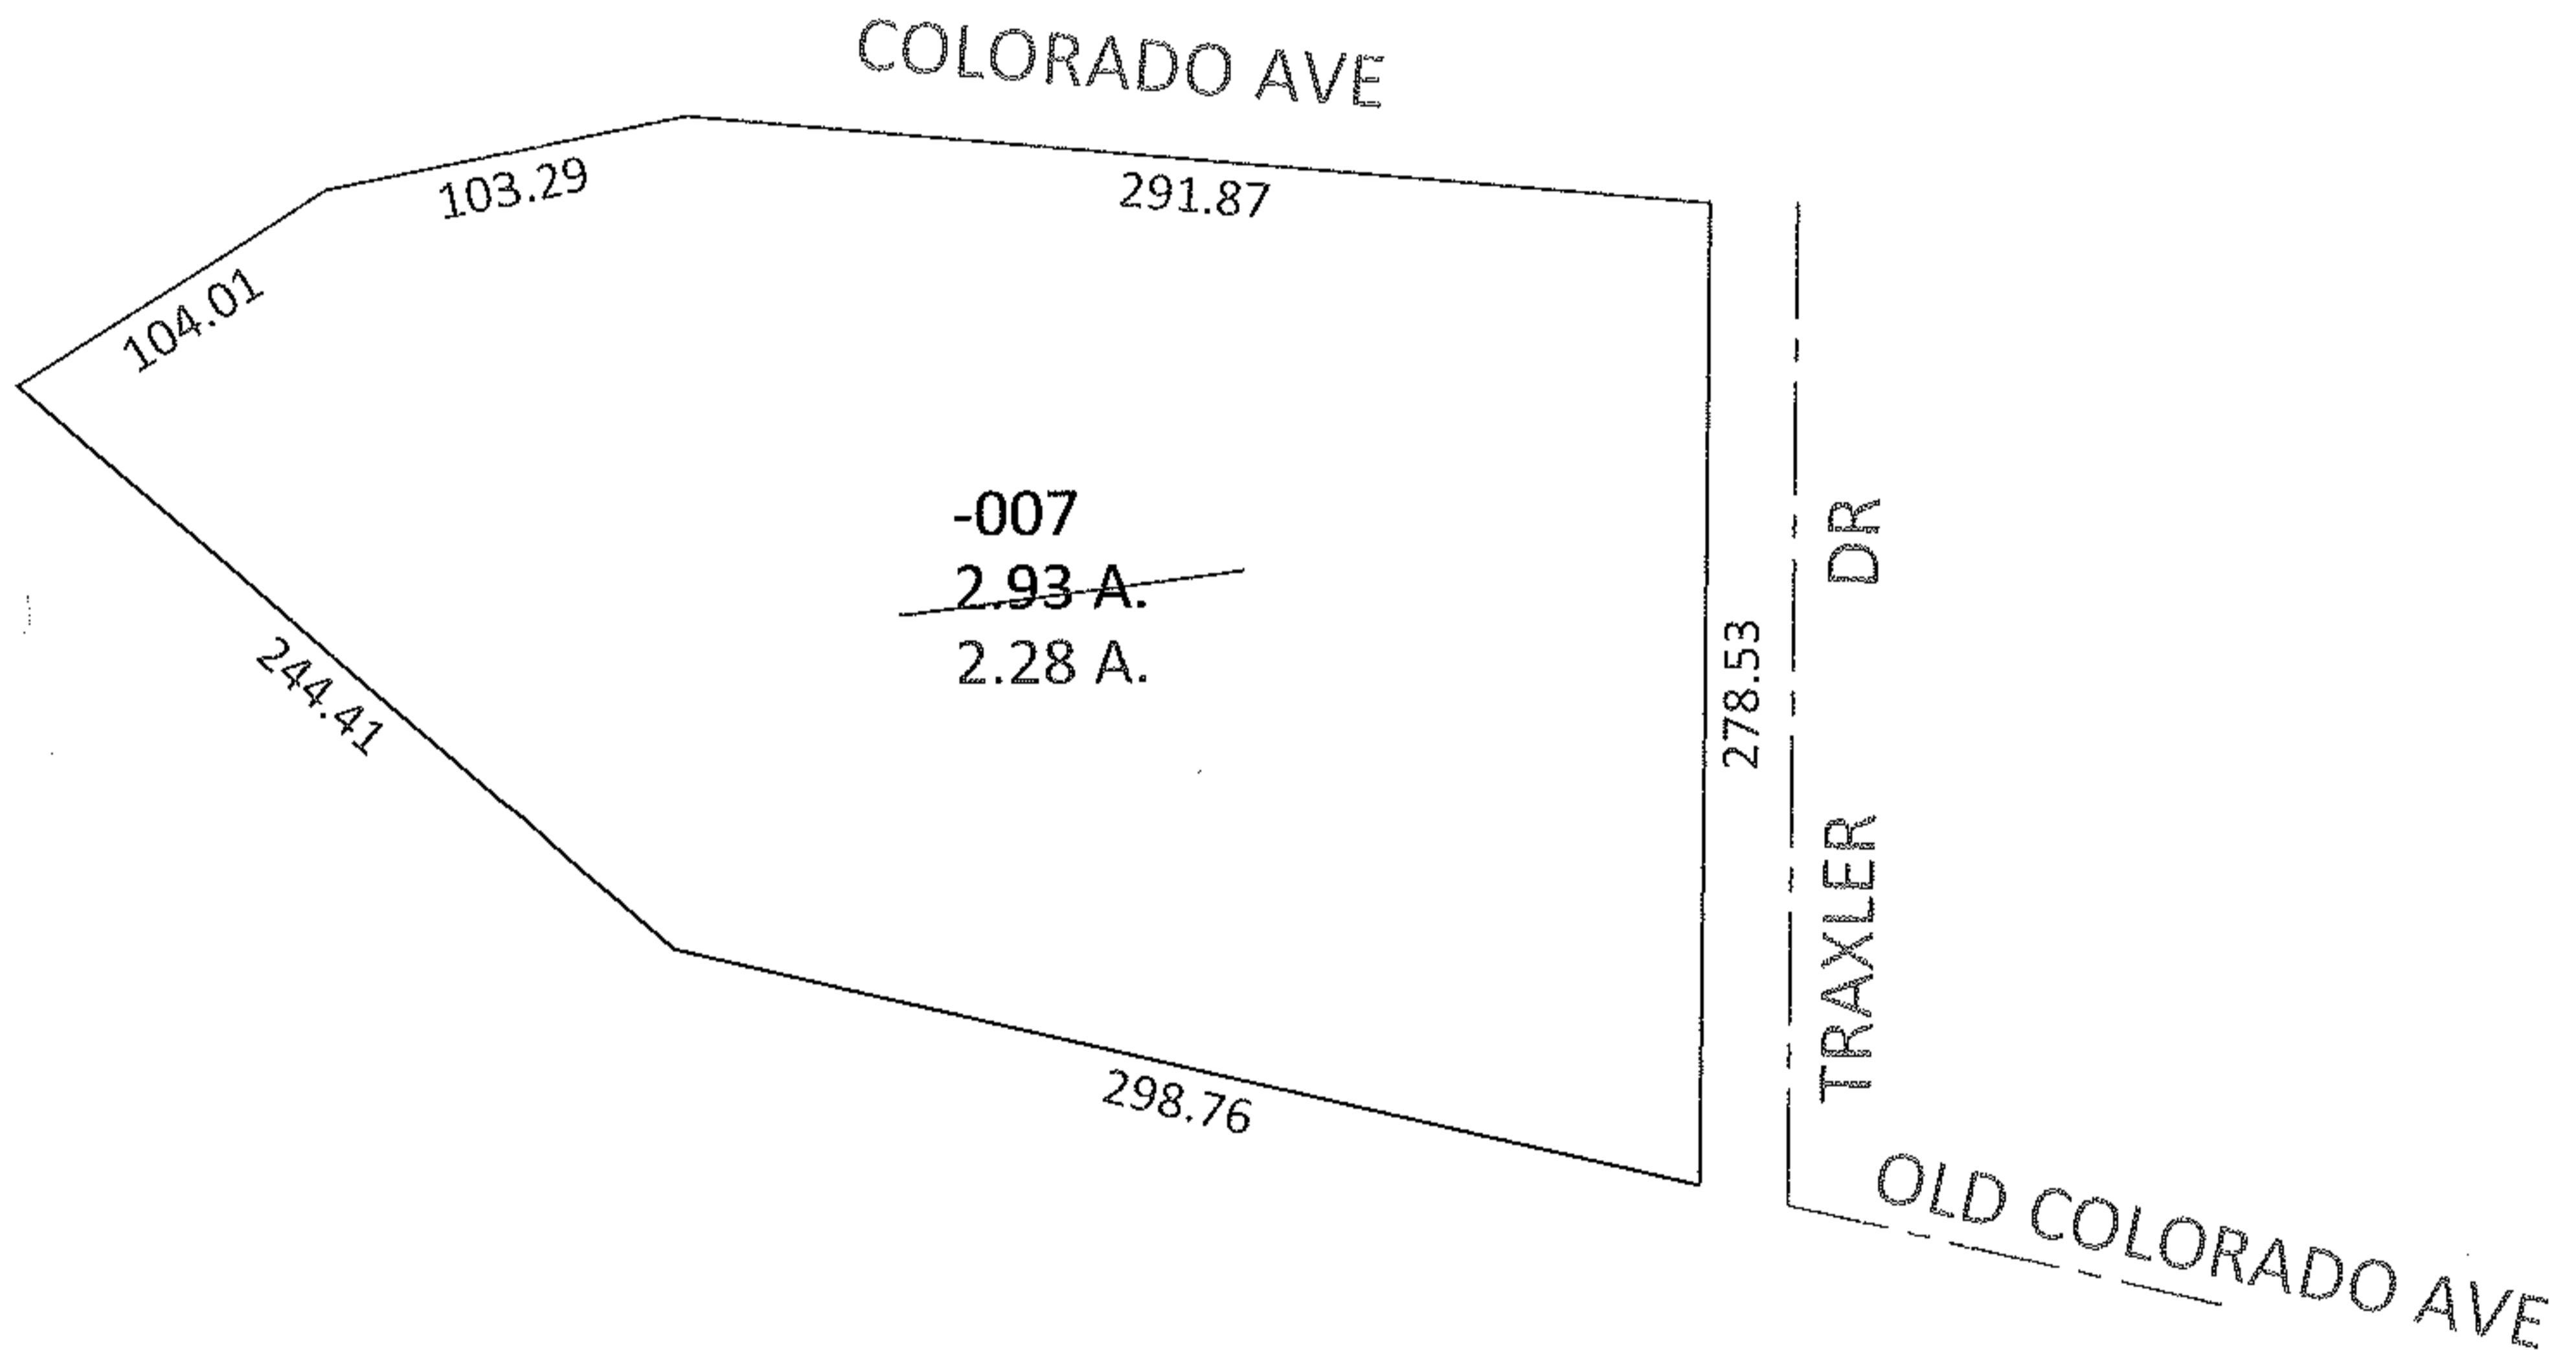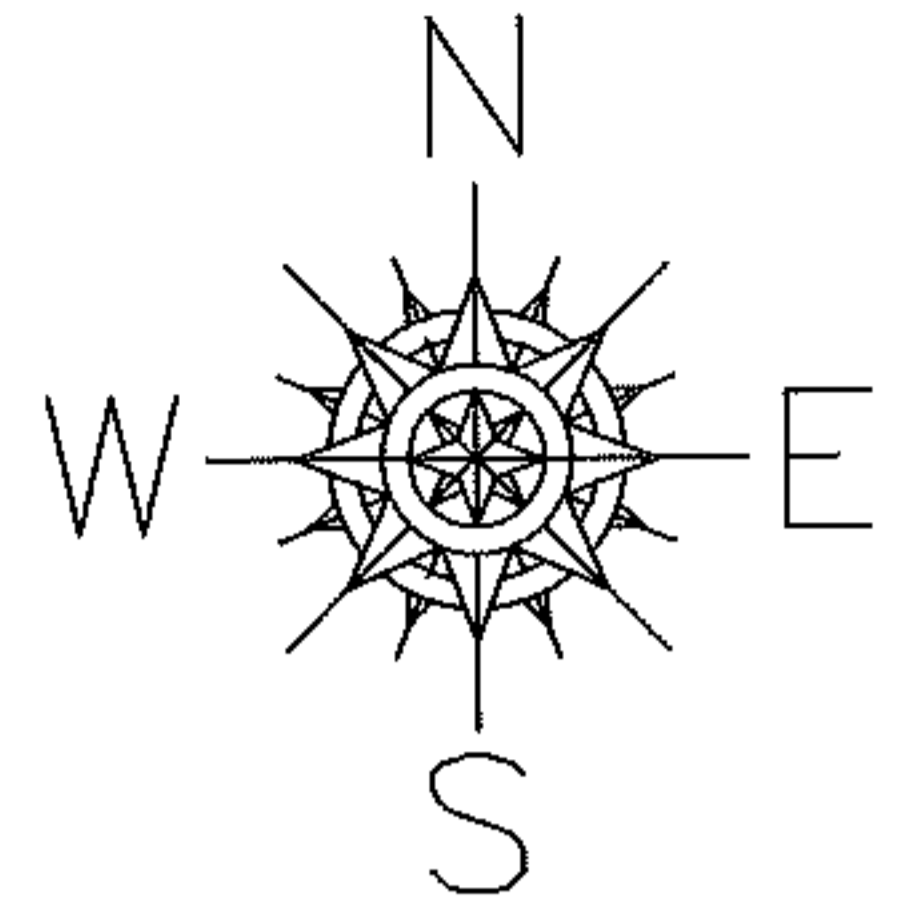

SPLITS/DEEDS PROCESSED

LORAIN COUNTY TAX MAP DEPARTMENT
226 MIDDLE AVE. ELYRIA, OHIO

SURVEYED BY: DAVID L. ELWELL

CLOSURE: 1:10,000

MAP PAGE(S): 03-00-060-B

APPROVED BY: DRH DATE: 7/10/2009

SCALE: 1" = 100 PRIOR INSTRUMENT: 1409/706