


PARENT PARCEL: 01-00-003-139-032



CHILD PARCEL: 01-00-003-139-064 THRU -067

STARTING POINT: SOUTH LINE OF BLOCK "5" OF NATURES PRESERVE SUBD.

NO. 01860

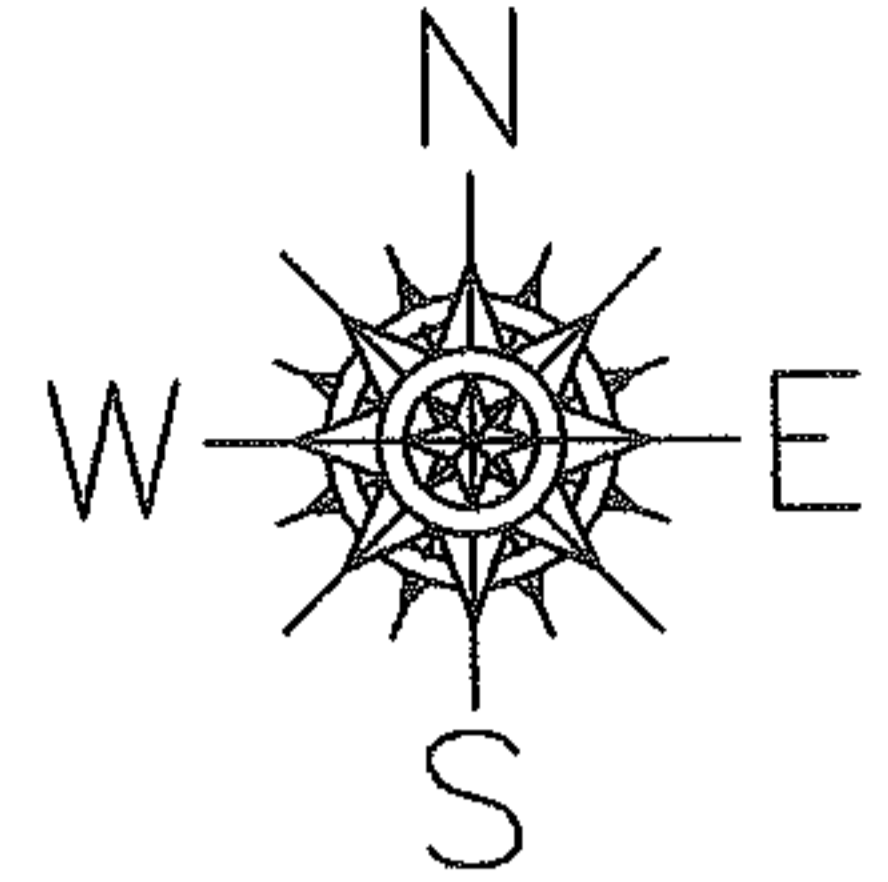

NATURES PRESERVE SUBD.
VOL 67/42

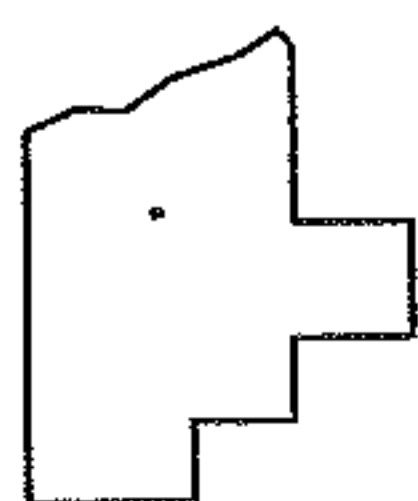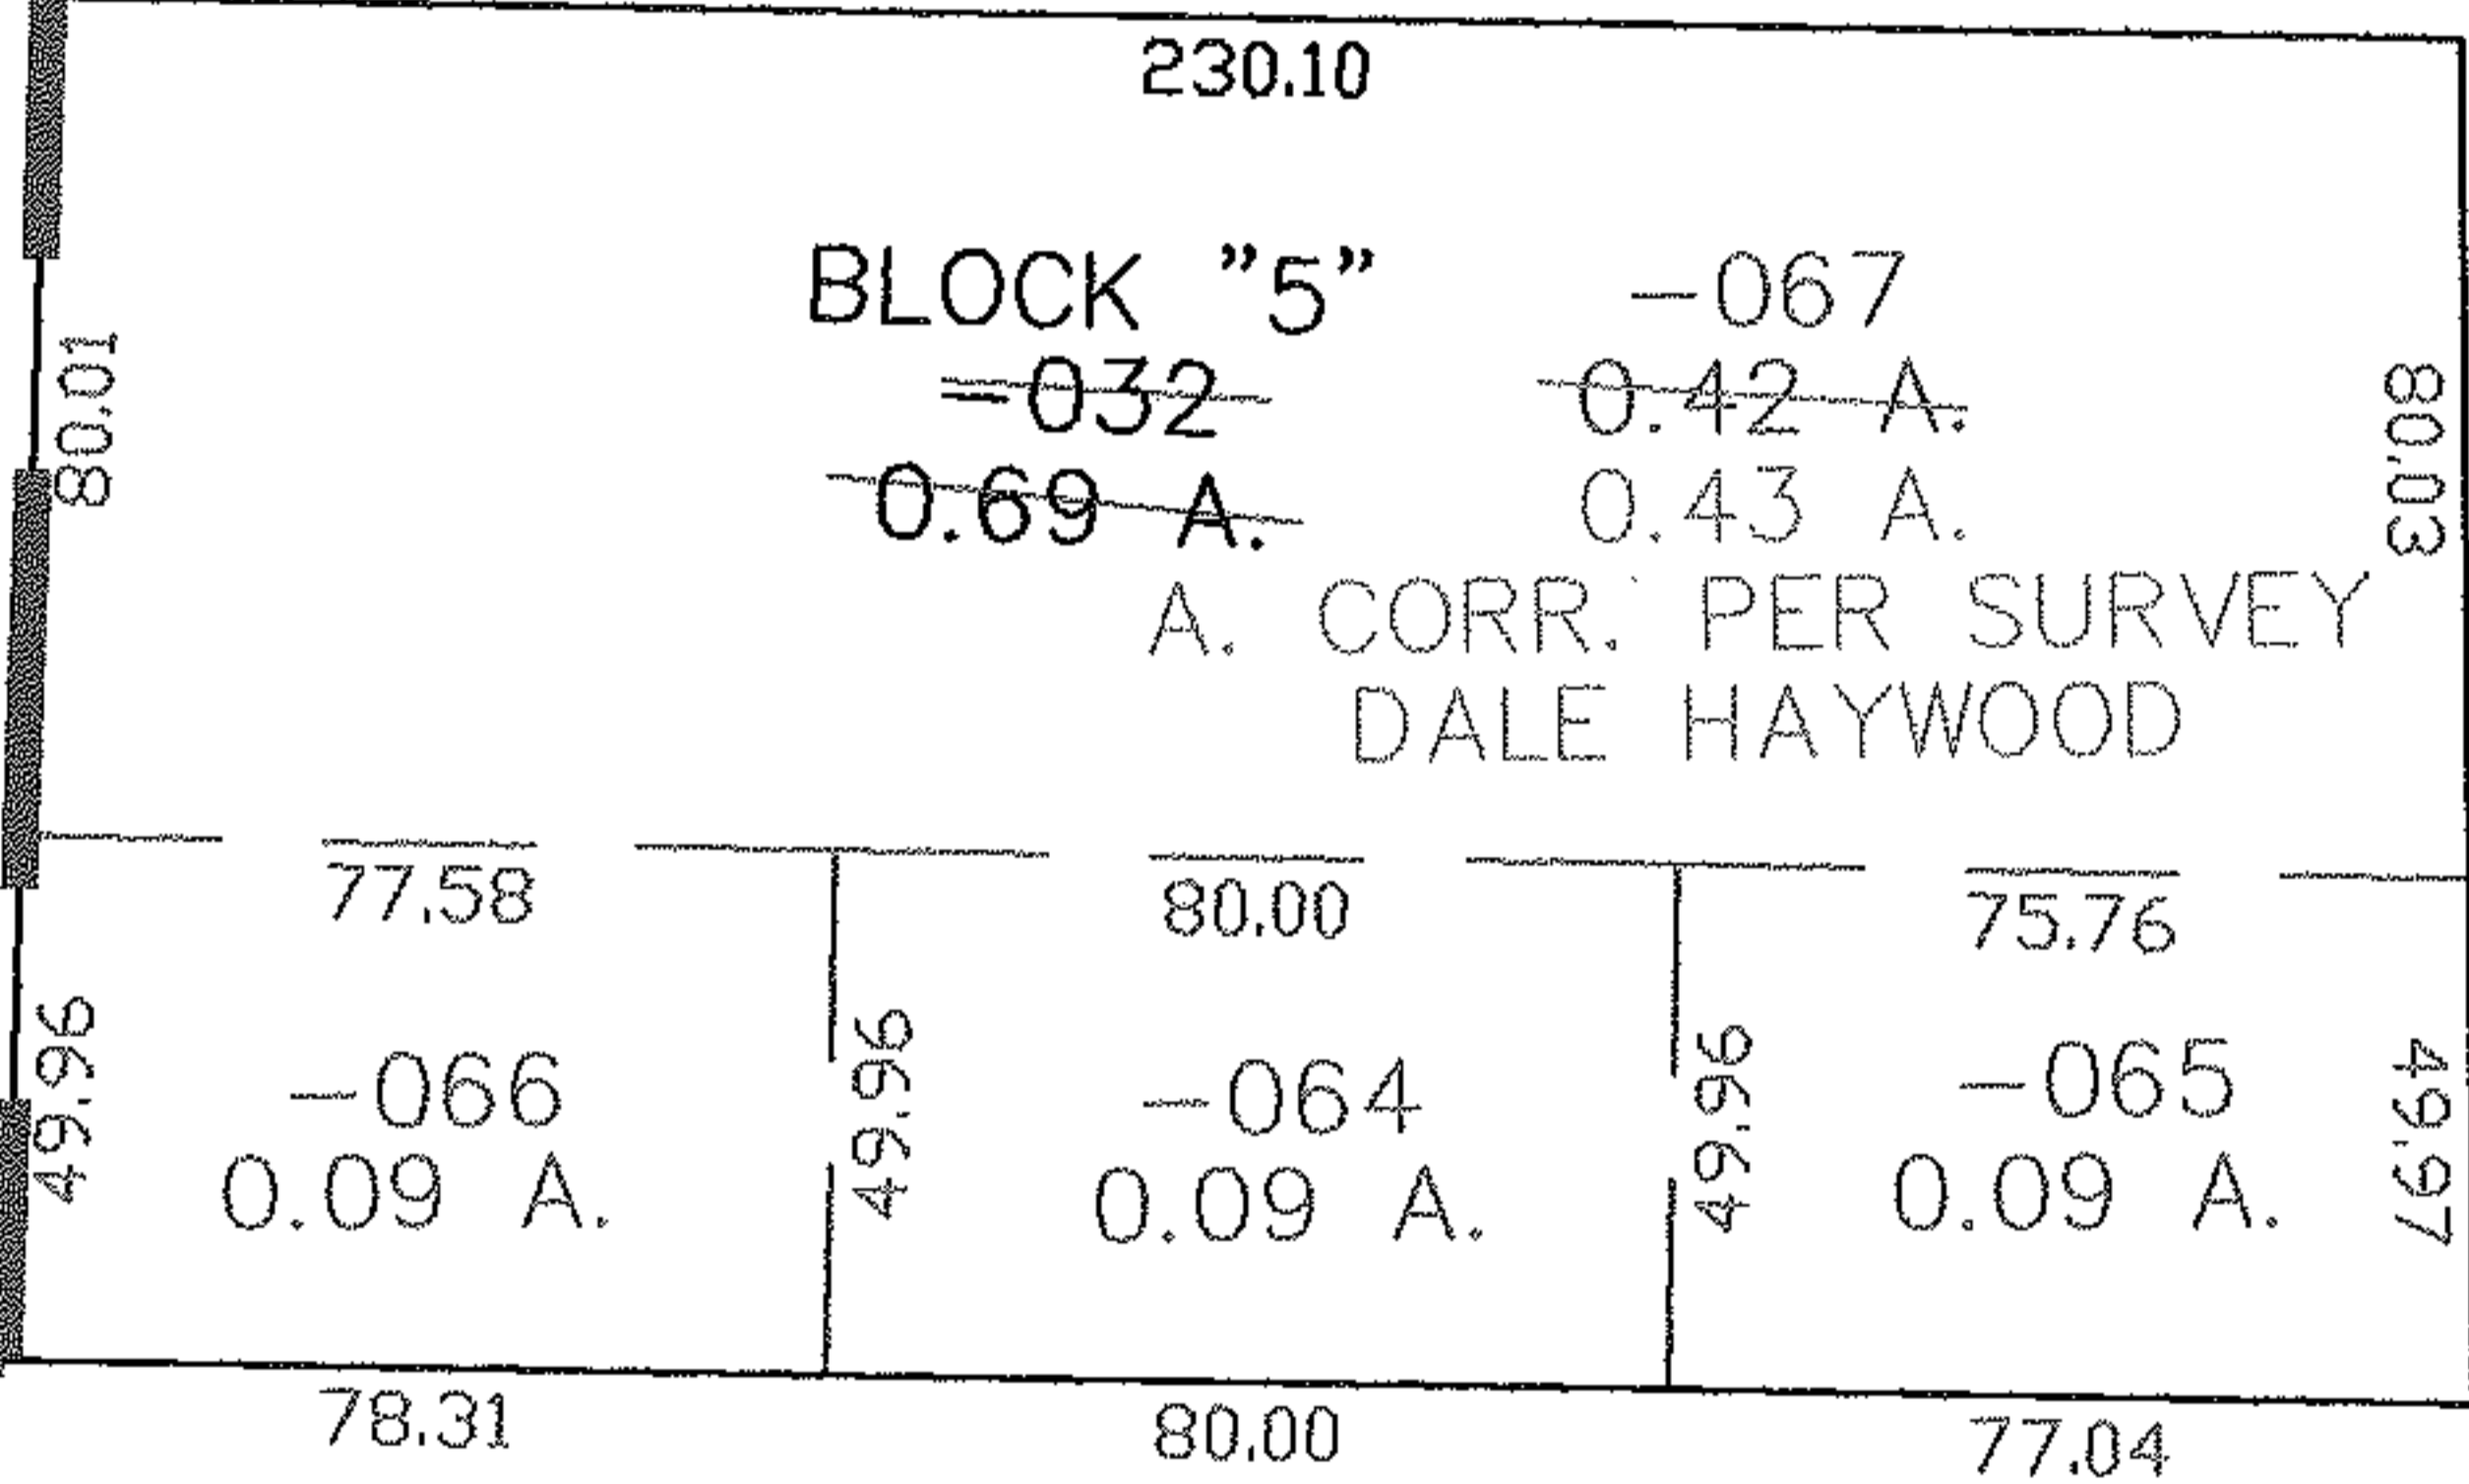

SPLITS/DEEDS PROCESSED

LORAIN COUNTY TAX MAP DEPARTMENT
226 MIDDLE AVE. ELYRIA, OHIO

SURVEYED BY: DALE HAYWOOD

CLOSURE: 0.00 : 10.000

MAP PAGE(S): 01-00-003-C

APPROVED BY: JAH DATE: 2-22-05

SCALE: 1" = 100' PRIOR INSTRUMENT: PL. VL 67/42