

RASTER


PARENT PARCEL: 18-00-022-103-007

CHILD PARCEL: SAME

STARTING POINT: N/W CORNER DAVIS PROPERTY


09-01864-C

MAP CORRECTION ONLY

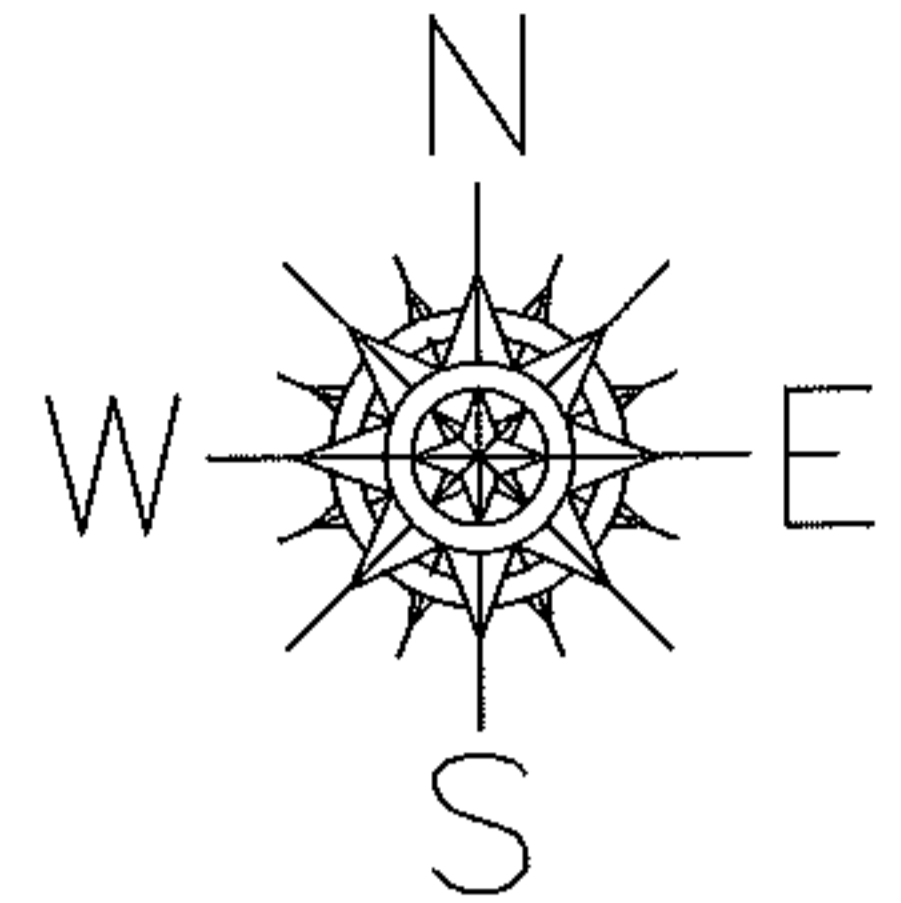


FRONTAGE - 85 FEET - PER PREVIOUS DEEDS
(FROM 84 FEET)

FOREST STREET

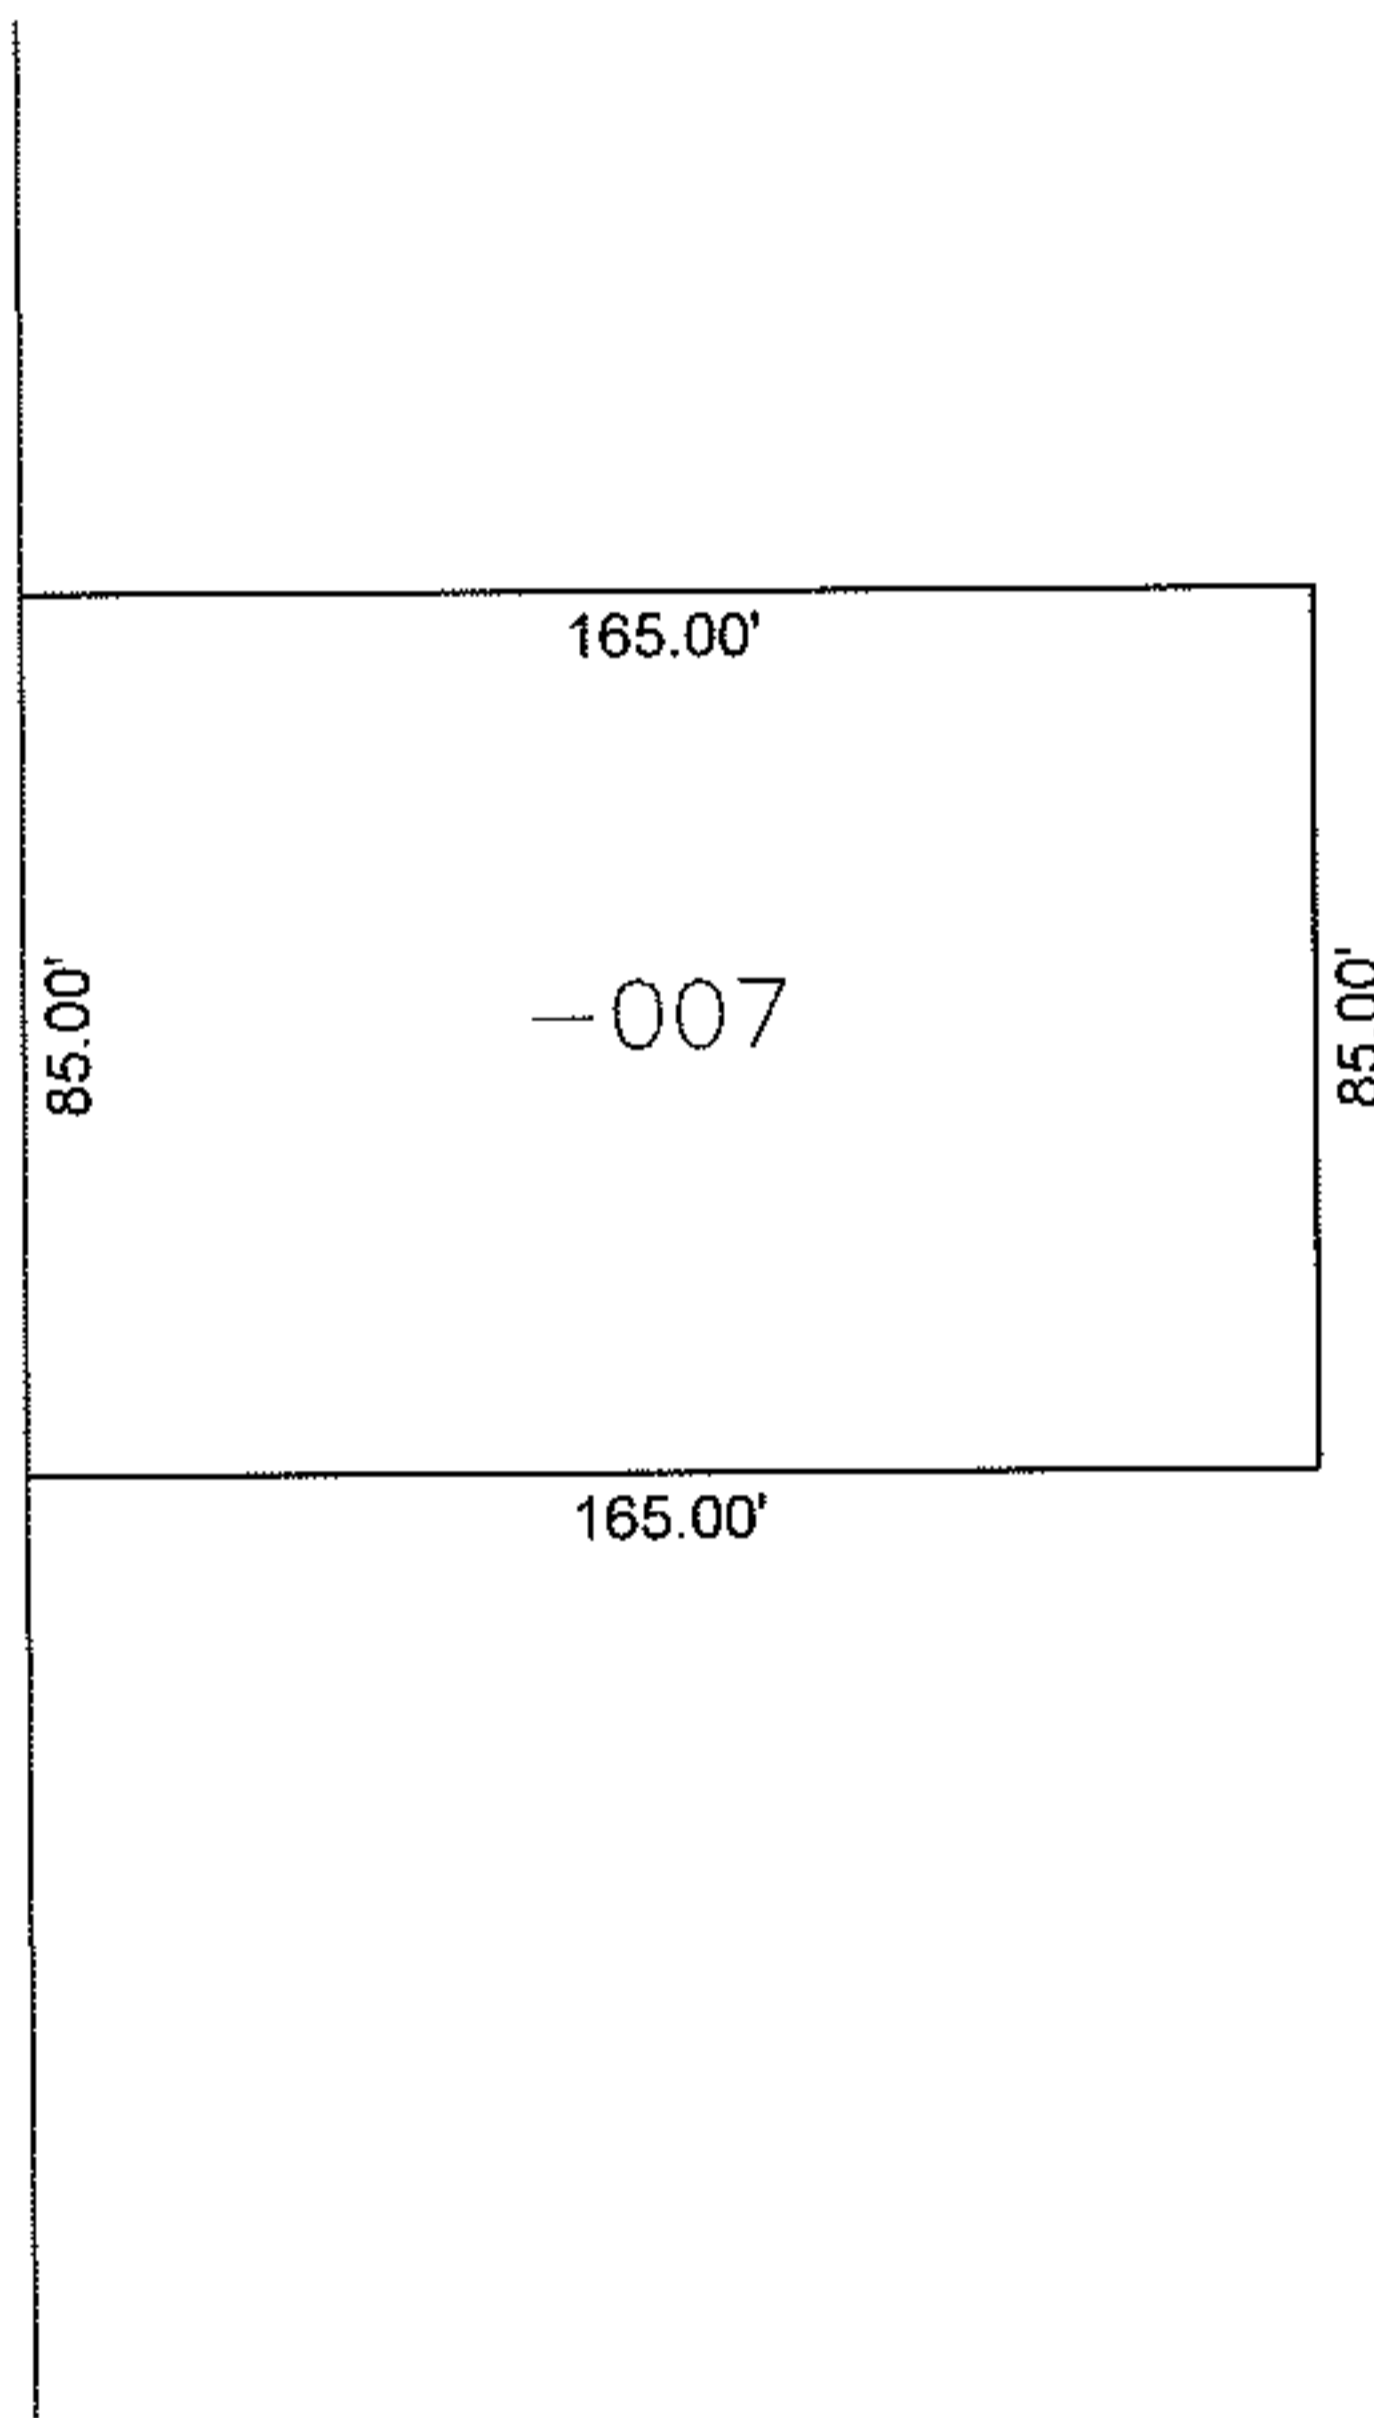

NOT TO SCALE

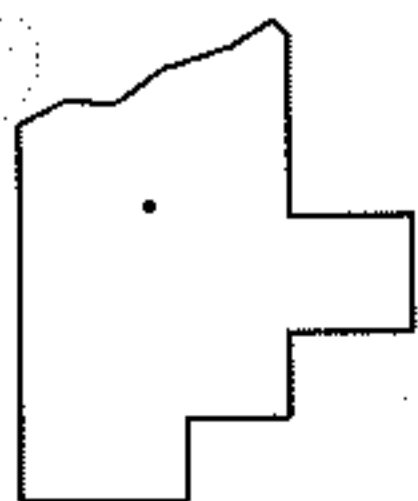

SPLITS/DEEDS PROCESSED
LORAIN COUNTY TAX MAP DEPARTMENT
226 MIDDLE AVE. ELYRIA, OHIO

SURVEYED BY: N/A
CLOSURE: N/A
MAP PAGE(S): 18-00-022-A
APPROVED BY: MBK DATE: 08/03/2009
SCALE: N/A PRIOR INSTRUMENT: 20030956085