
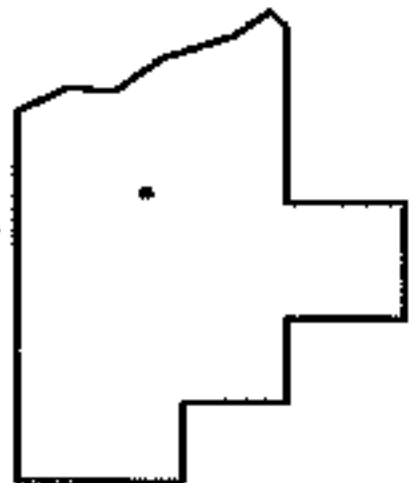
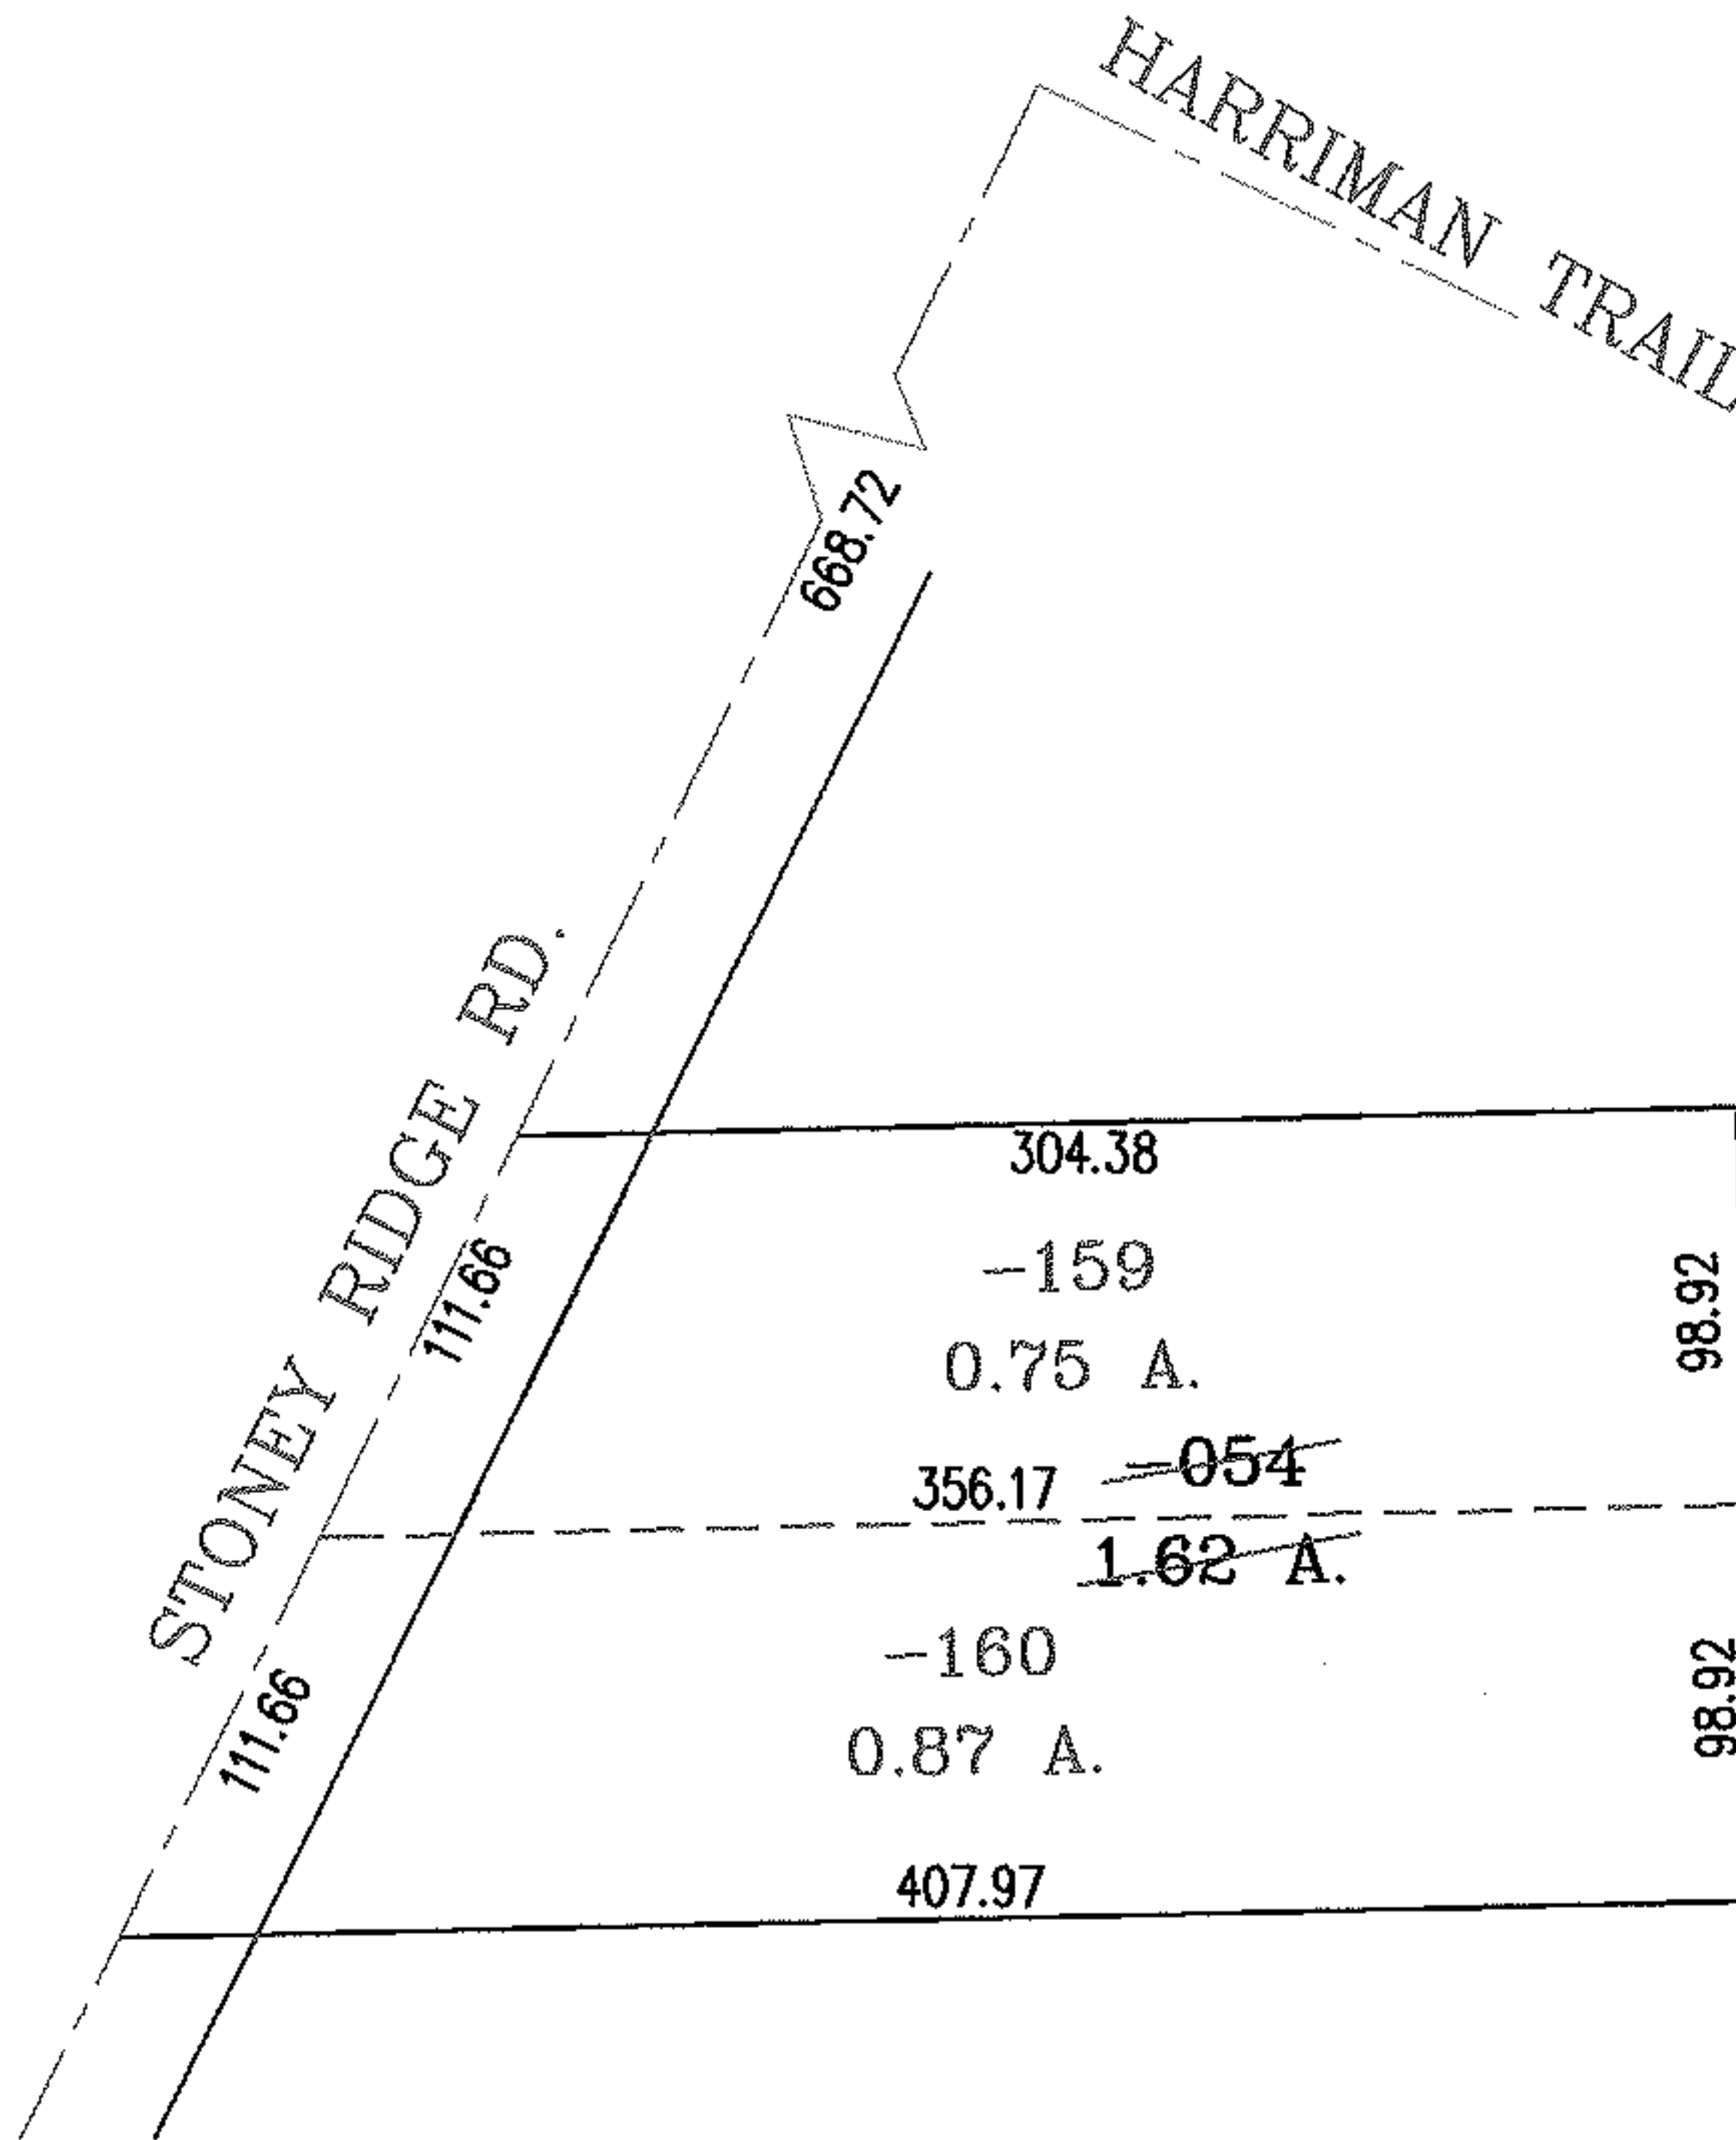


PARENT PARCEL: 04-00-011-108-054

CHILD PARCEL: 04-00-011-108-159,-160

STARTING POINT: INTERSECTION OF C/L OF STONEY RIDGE RD. AND C/L OF HARRIMAN TRAIL

NO. 01868

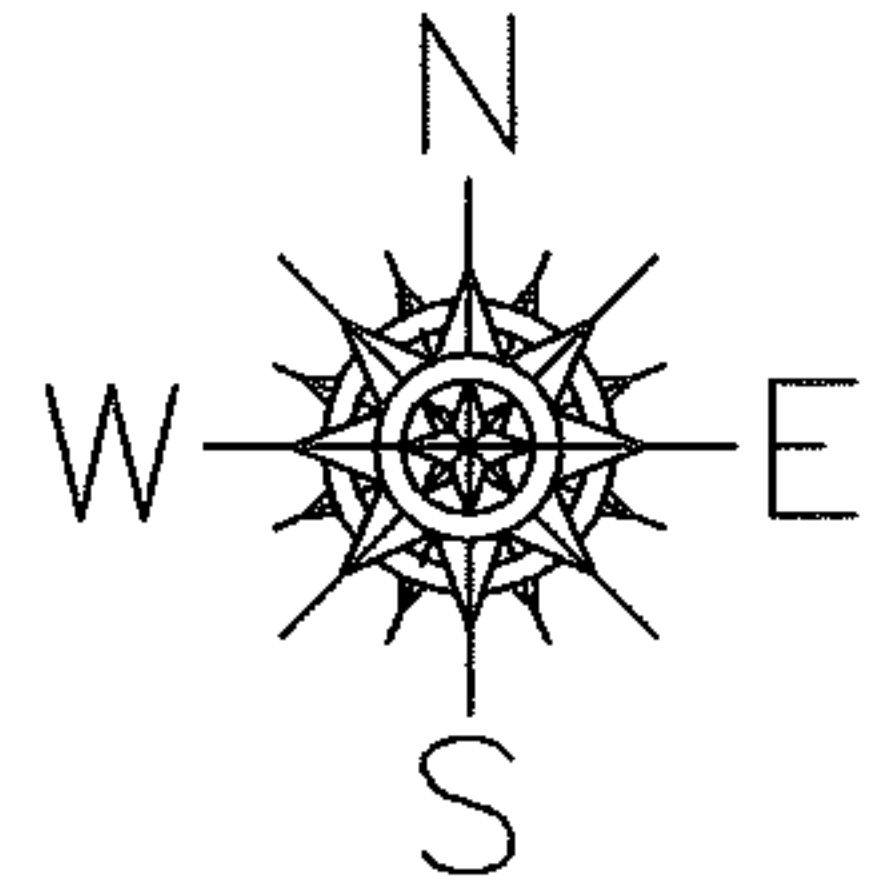

SPLITS/DEEDS PROCESSED

LORAIN COUNTY TAX MAP DEPARTMENT
226 MIDDLE AVE. ELYRIA, OHIO

SURVEYED BY: JAMES A. RESAR

CLOSURE: .00:10.000

MAP PAGE(S): 4-00-011-H

APPROVED BY: RRM DATE: 3-7-05

SCALE: 1" = 100' PRIOR INSTRUMENT: 20040987025