

RASTER

PARENT PARCEL: 10-00-015-109-011
LD PARCEL: XX-XX-XXX-XXX-XXX
STARTING POINT: N.W. CORNER OF S/L 116 IN BRENTWOOD ALLOT. NO. 2, V. 16 PG. 11A

09-01870-C

DEPTH CORRECTION




10-00-015-109-011

~~100.00 X~~

100.00 X 147.29

CORR. PER DEED

20080255455

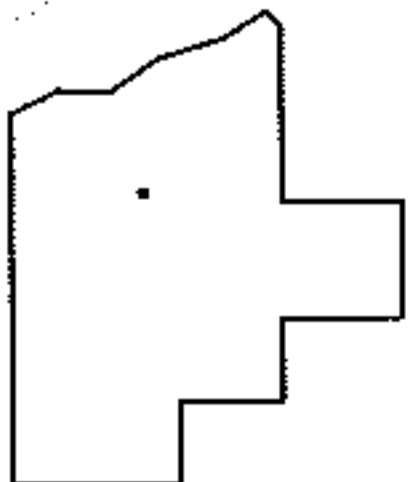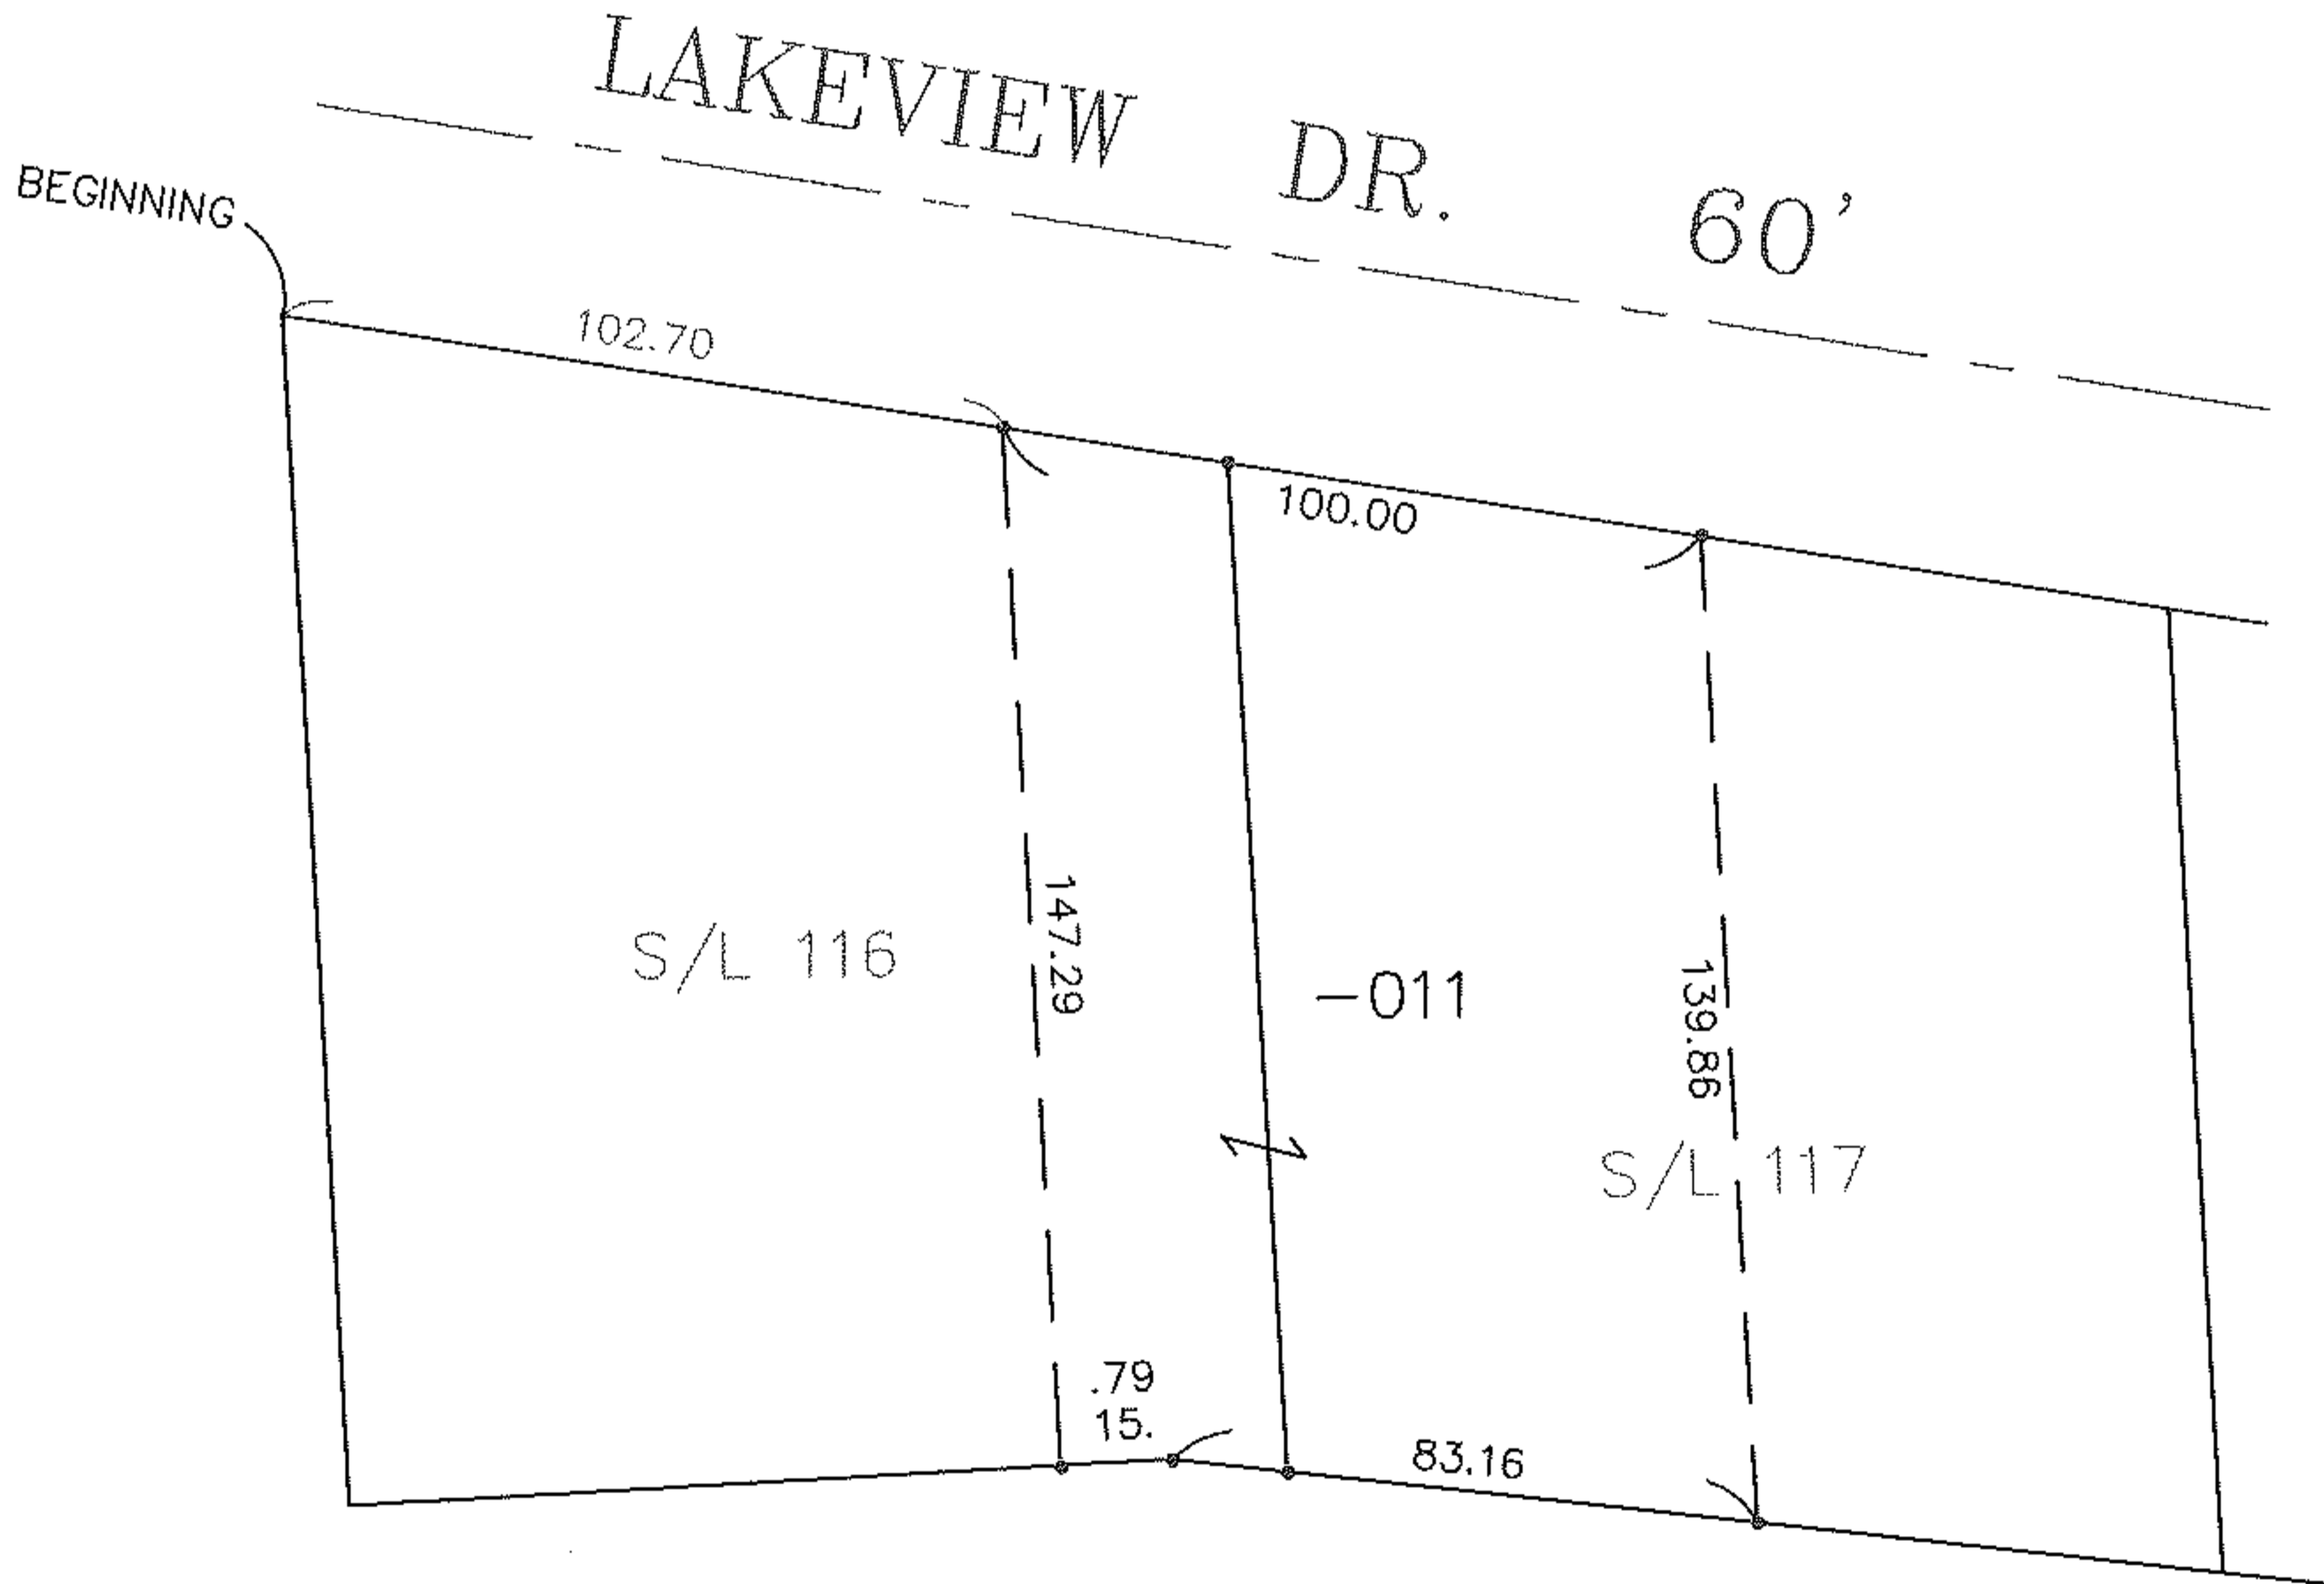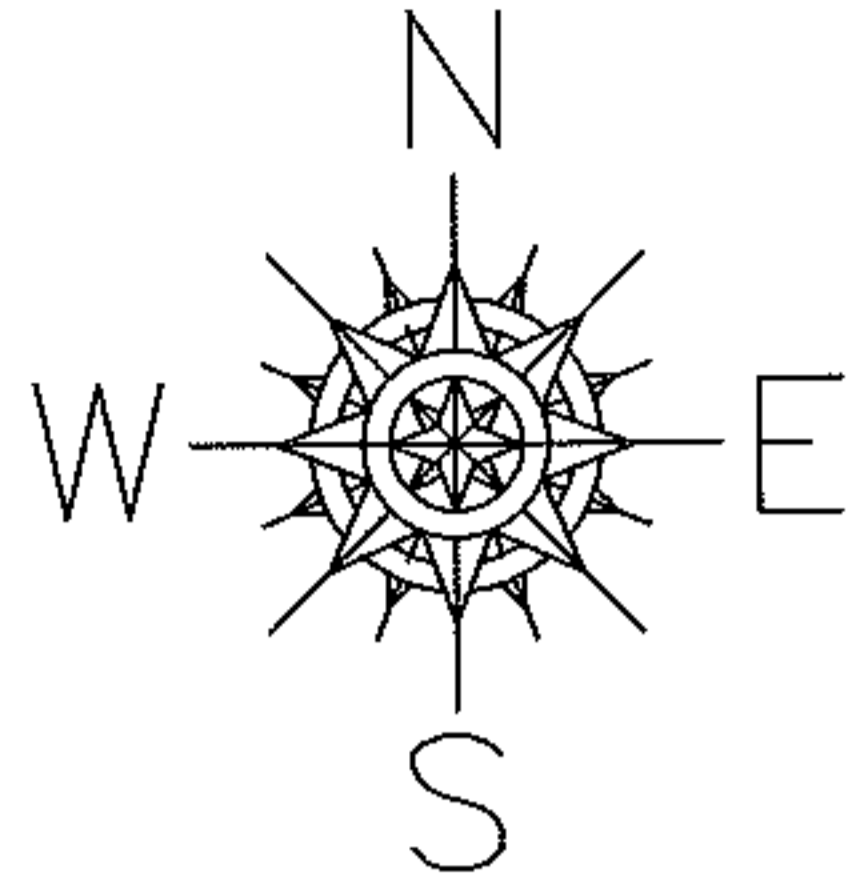

SPLITS/DEEDS PROCESSED

LORAIN COUNTY TAX MAP DEPARTMENT
226 MIDDLE AVE. ELYRIA, OHIO

SURVEYED BY: XXXXXXXXXXXX
CLOSURE: 1:310
MAP PAGE(S): 10-00-015-D
APPROVED BY: TJS DATE: 8/11/09
SCALE: 1"=50' PRIOR INST.: DV XXXX/XXX