




RASTER

PARENT PARCEL: 04-00-003-103-004,-005

CHILD PARCEL: 04-00-003-103-039,-040

STARTING POINT: INTERSECTION OF C/L OF FRENCH CREEK RD. AND C/L OF BROOKVIEW DR.

NO. 01872

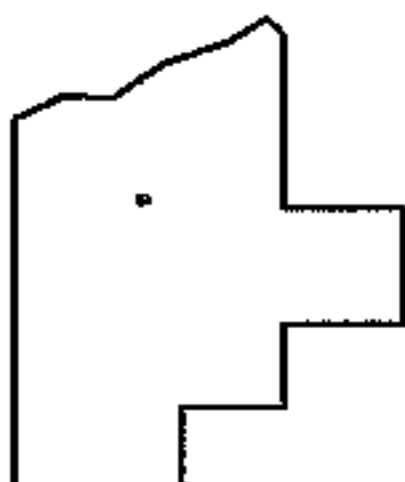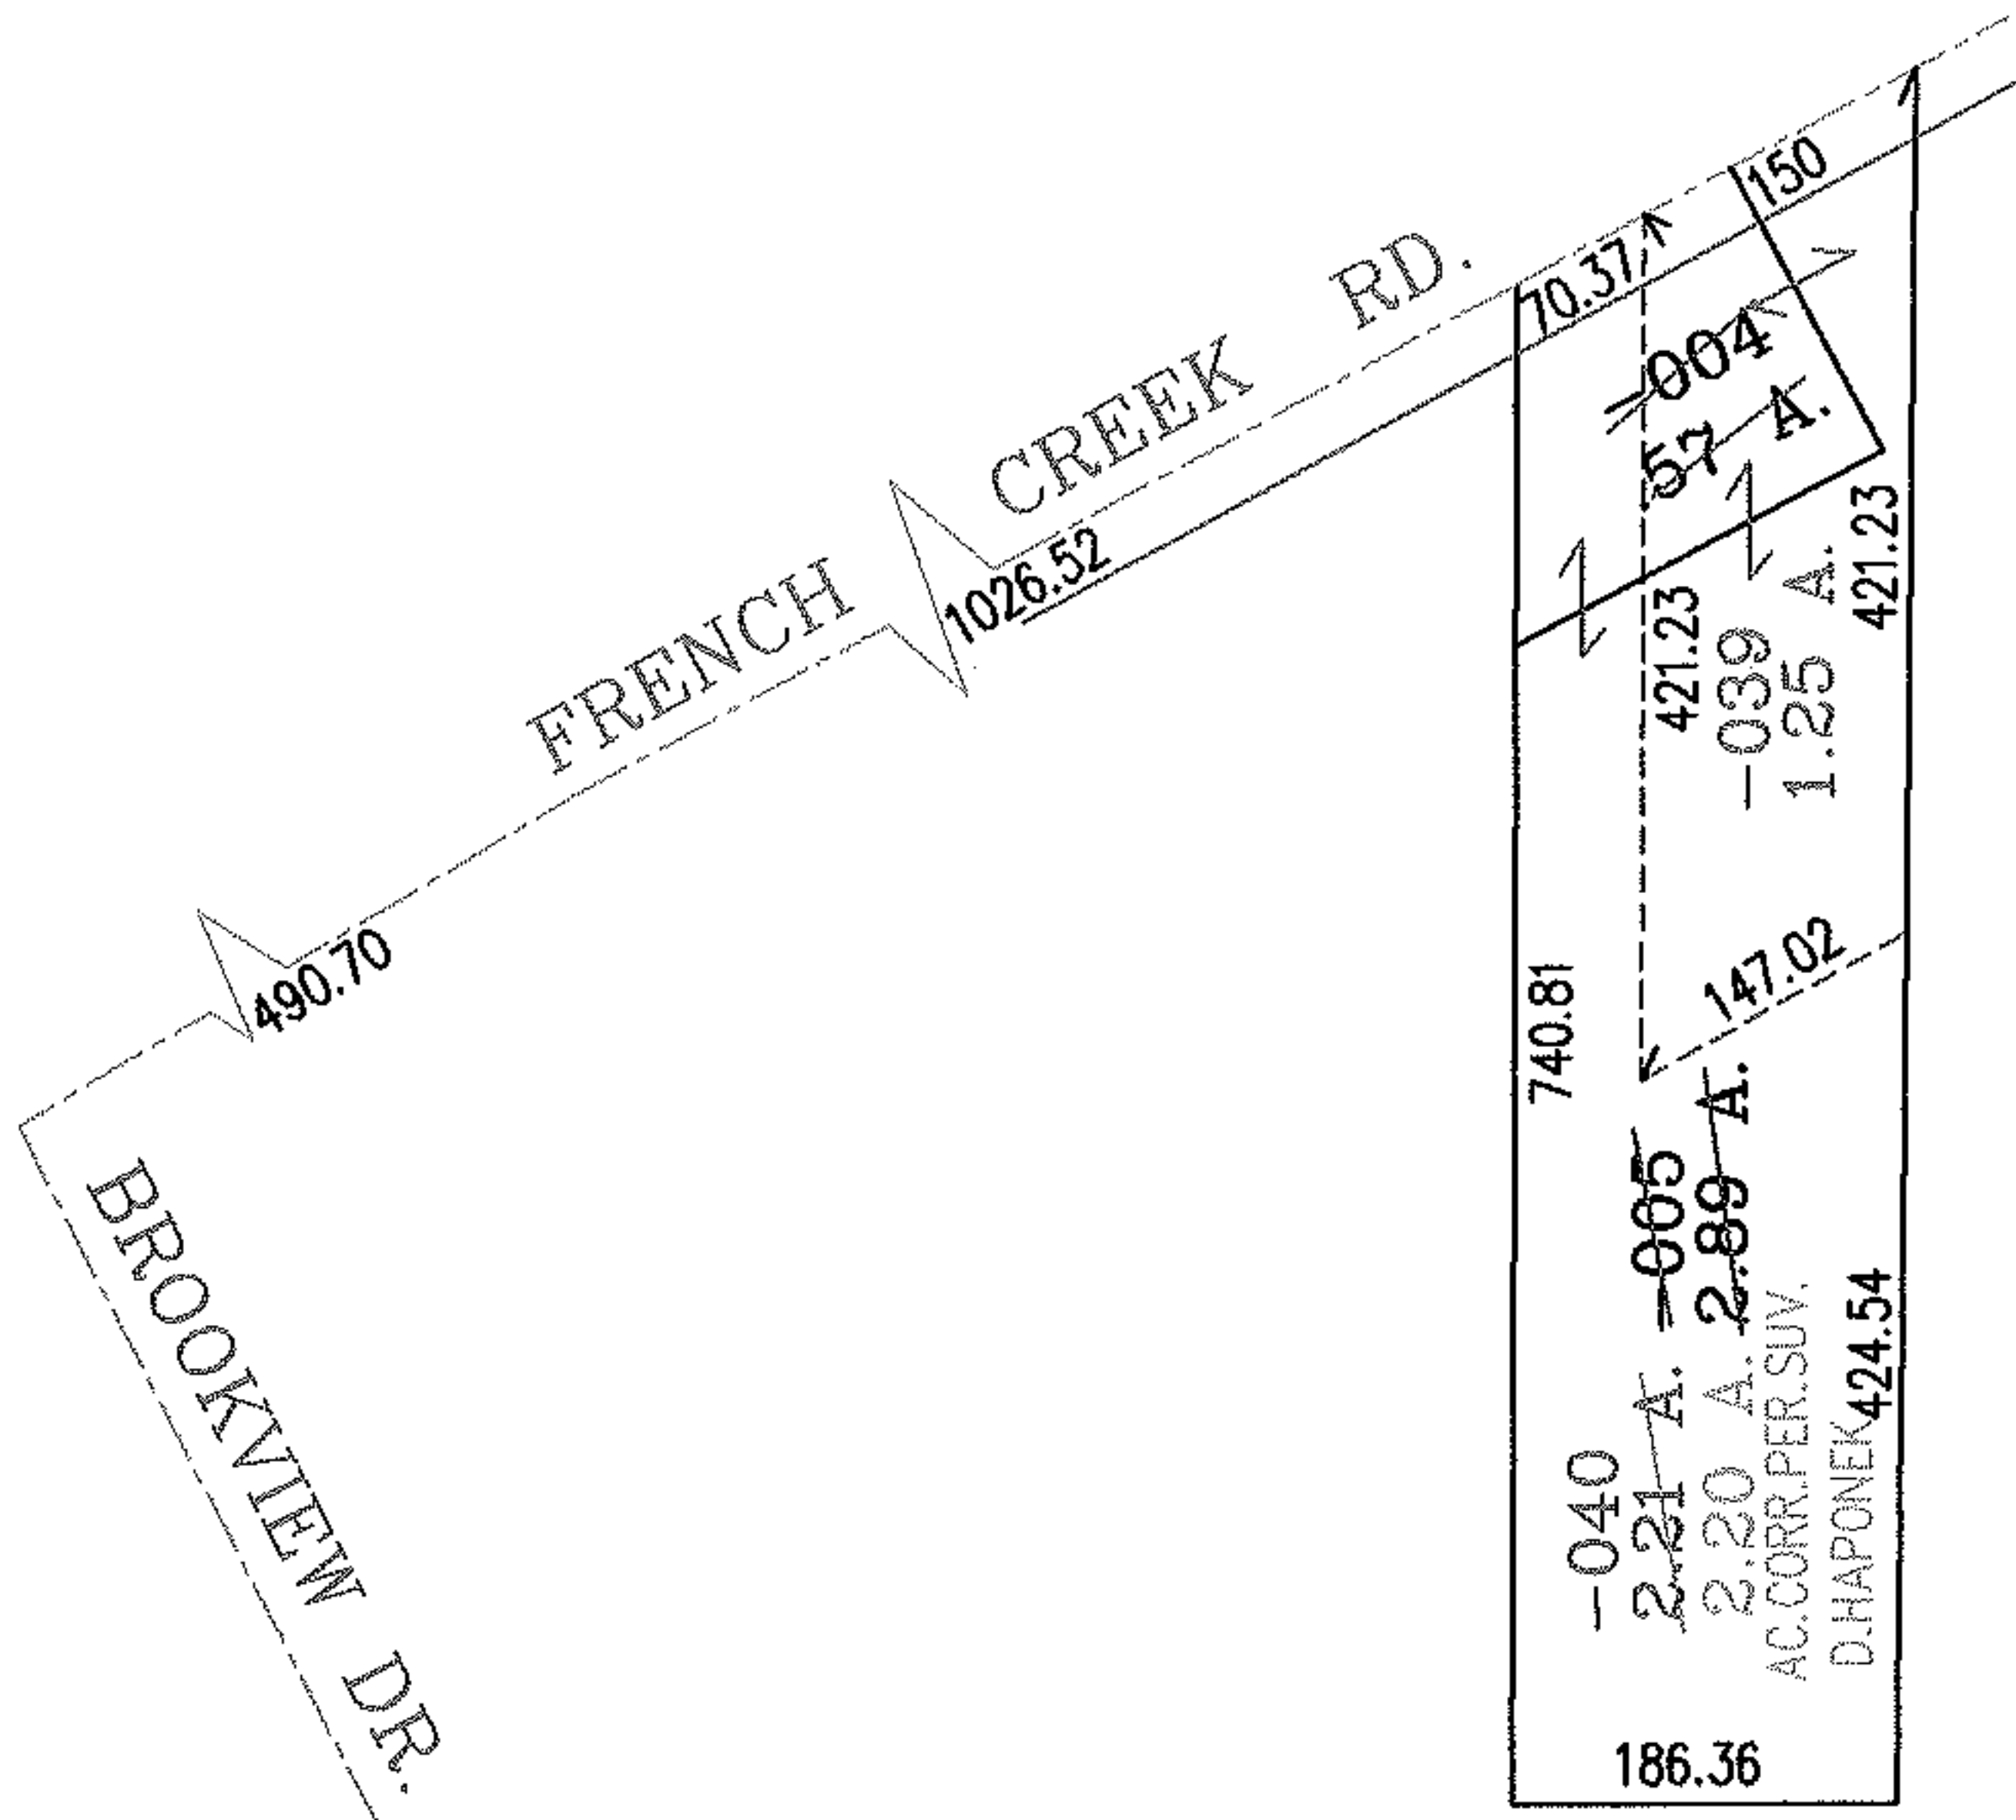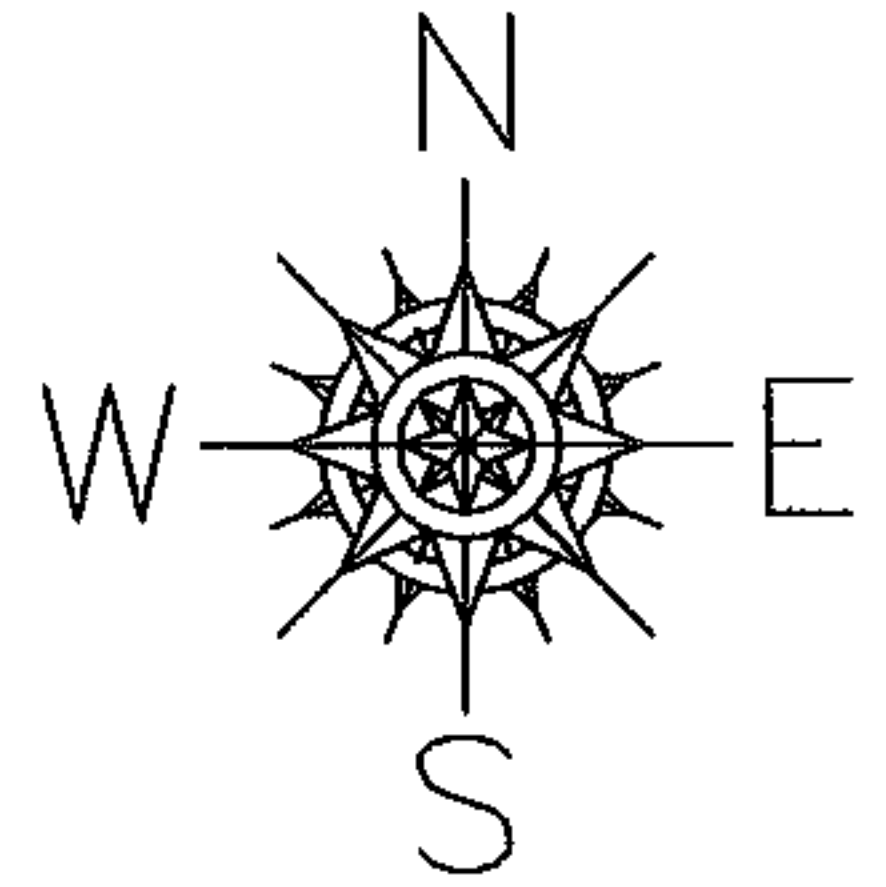

SPLITS/DEEDS PROCESSED

LORAIN COUNTY TAX MAP DEPARTMENT
226 MIDDLE AVE. ELYRIA, OHIO

SURVEYED BY: DANE A. HAPONEK

CLOSURE: .00:10.000

MAP PAGE(S): 4-00-003-H

APPROVED BY: RRM DATE: 3-1-05

SCALE: 1" = 200 PRIOR INSTRUMENT: 20040993539