




RASTER

PARENT PARCEL: 07-00-024-102-046

CHILD PARCEL: 07-00-024-102-056, -057

STARTING POINT: CENTERLINE OF ISLAND RD. & BUTTERNUT RIDGE RD.

NO. 01877

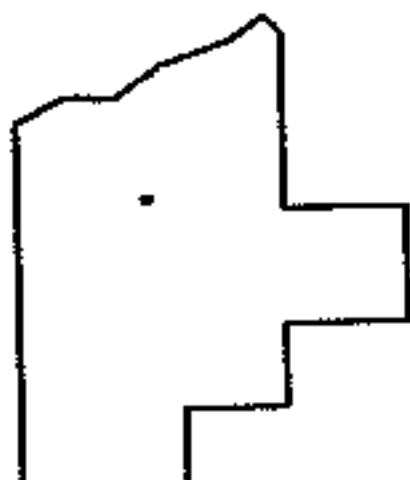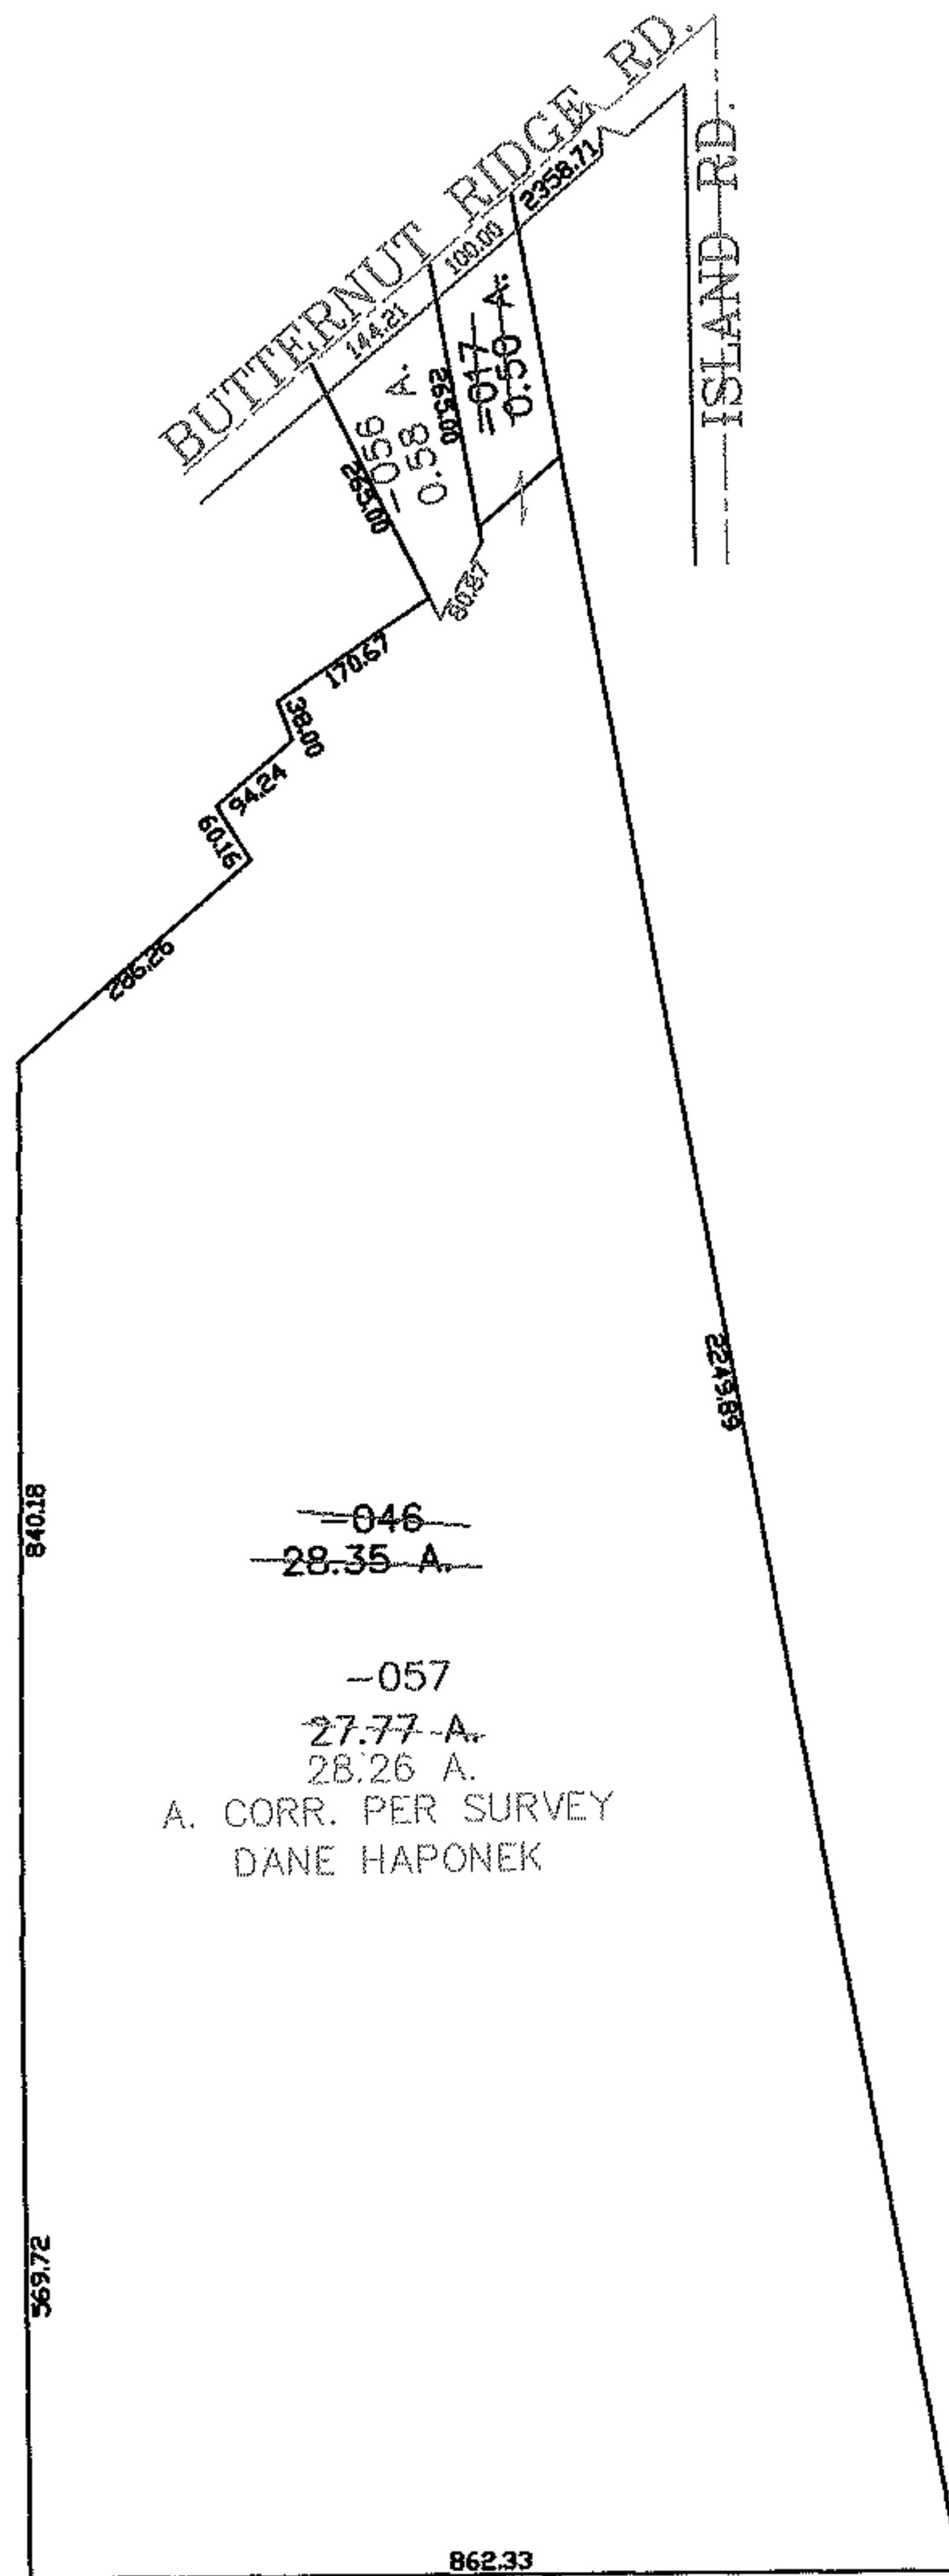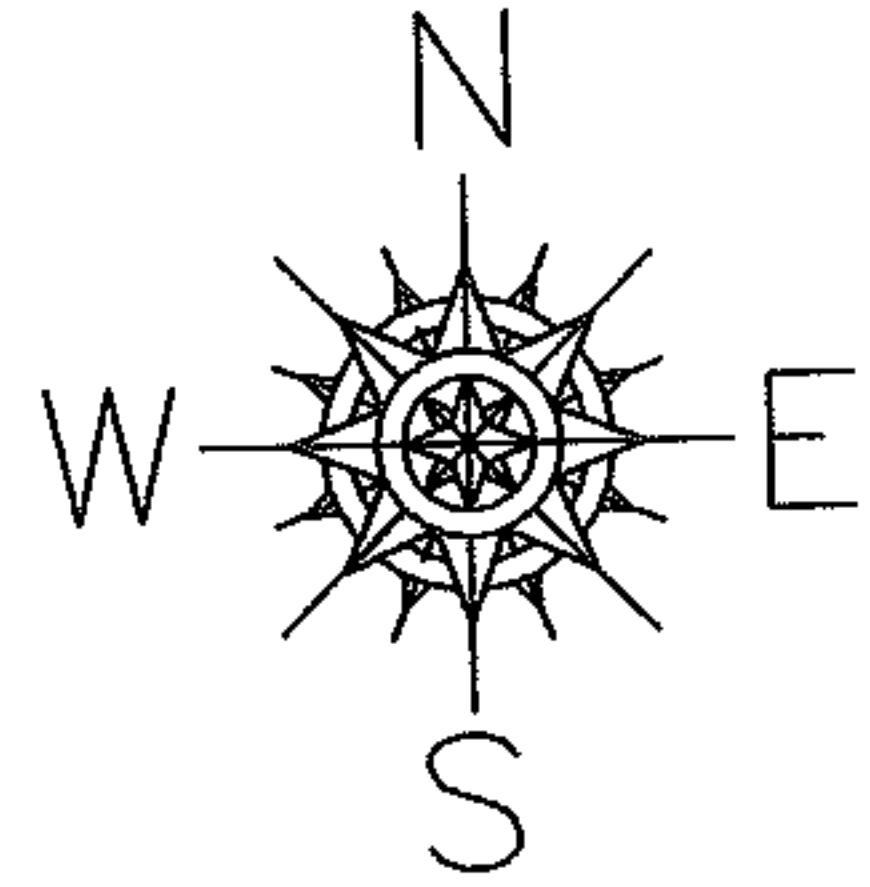

**SPLITS/DEEDS PROCESSED**

LORAIN COUNTY TAX MAP DEPARTMENT  
226 MIDDLE AVE. ELYRIA, OHIO

SURVEYED BY: DANE HAPONEK

CLOSURE: 0.00 ; 10.000

MAP PAGE(S): 07-00-024-D

APPROVED BY: JAH DATE: 3-14-05

SCALE: 1" = 300 PRIOR INSTRUMENT: 2005050101