
PARENT PARCEL: 06-24-070-104-005

CHILD PARCEL: __-SAME--

STARTING POINT: S/L 27 IN RESUB ELY & BOYTON'S 2ND ADDITION

09-01878-C

DEPTH CORR PER PLAT AND MAP NO MAP CORRECTION

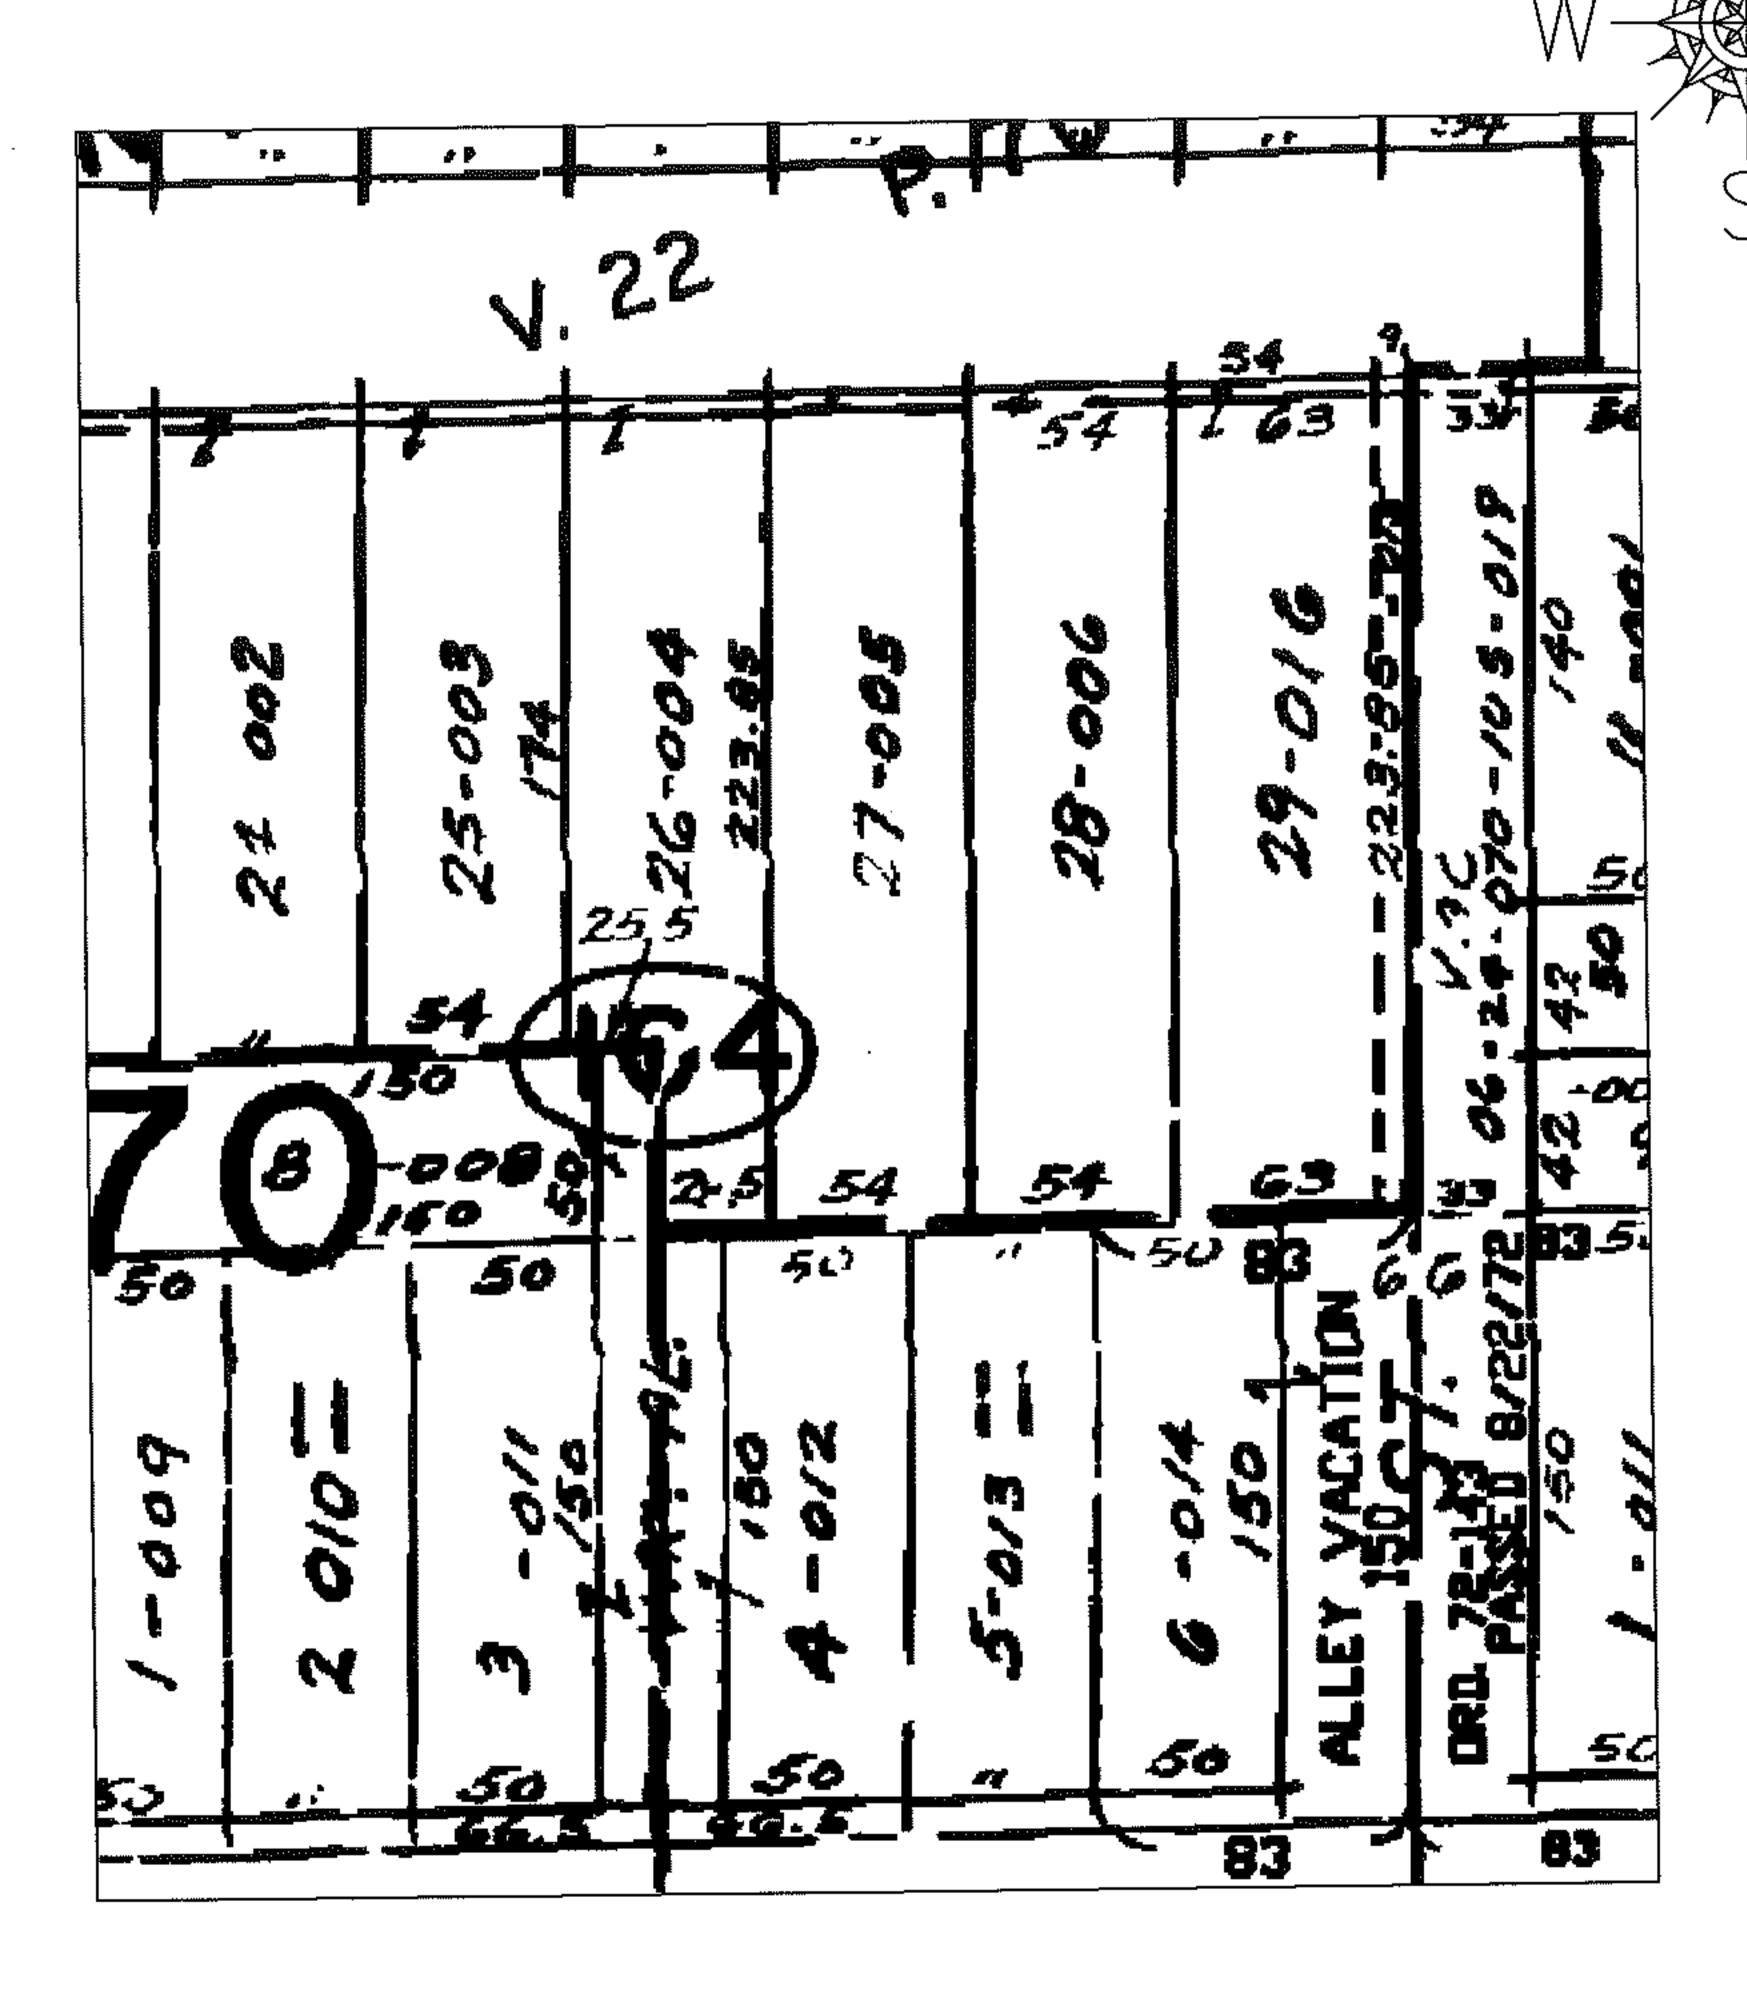

SPLITS/DEEDS PROCESSED

LORAIN COUNTY TAX MAP DEPARTMENT 226 MIDDLE AVE. ELYRIA, OHIO

SURVEYED BY: N/A

CLOSURE: N/A

MAP PAGE(S): 06-081

APPROVED BY: <u>DRH</u> DATE: <u>8/31/2009</u>

SCALE: NOT TO SCALE PRIOR INST.: 20010793262