

RASTER



PARENT PARCEL: 06-24-027-102-025

09-01880-C

CHILD PARCEL: --SAME--

STARTING POINT: S/L 241 & 242 IN CRISP & PETTIBONE'S FAIRVIEW ALLOTMENT

DEPTH CORR.
PER DEEDS & PLAT

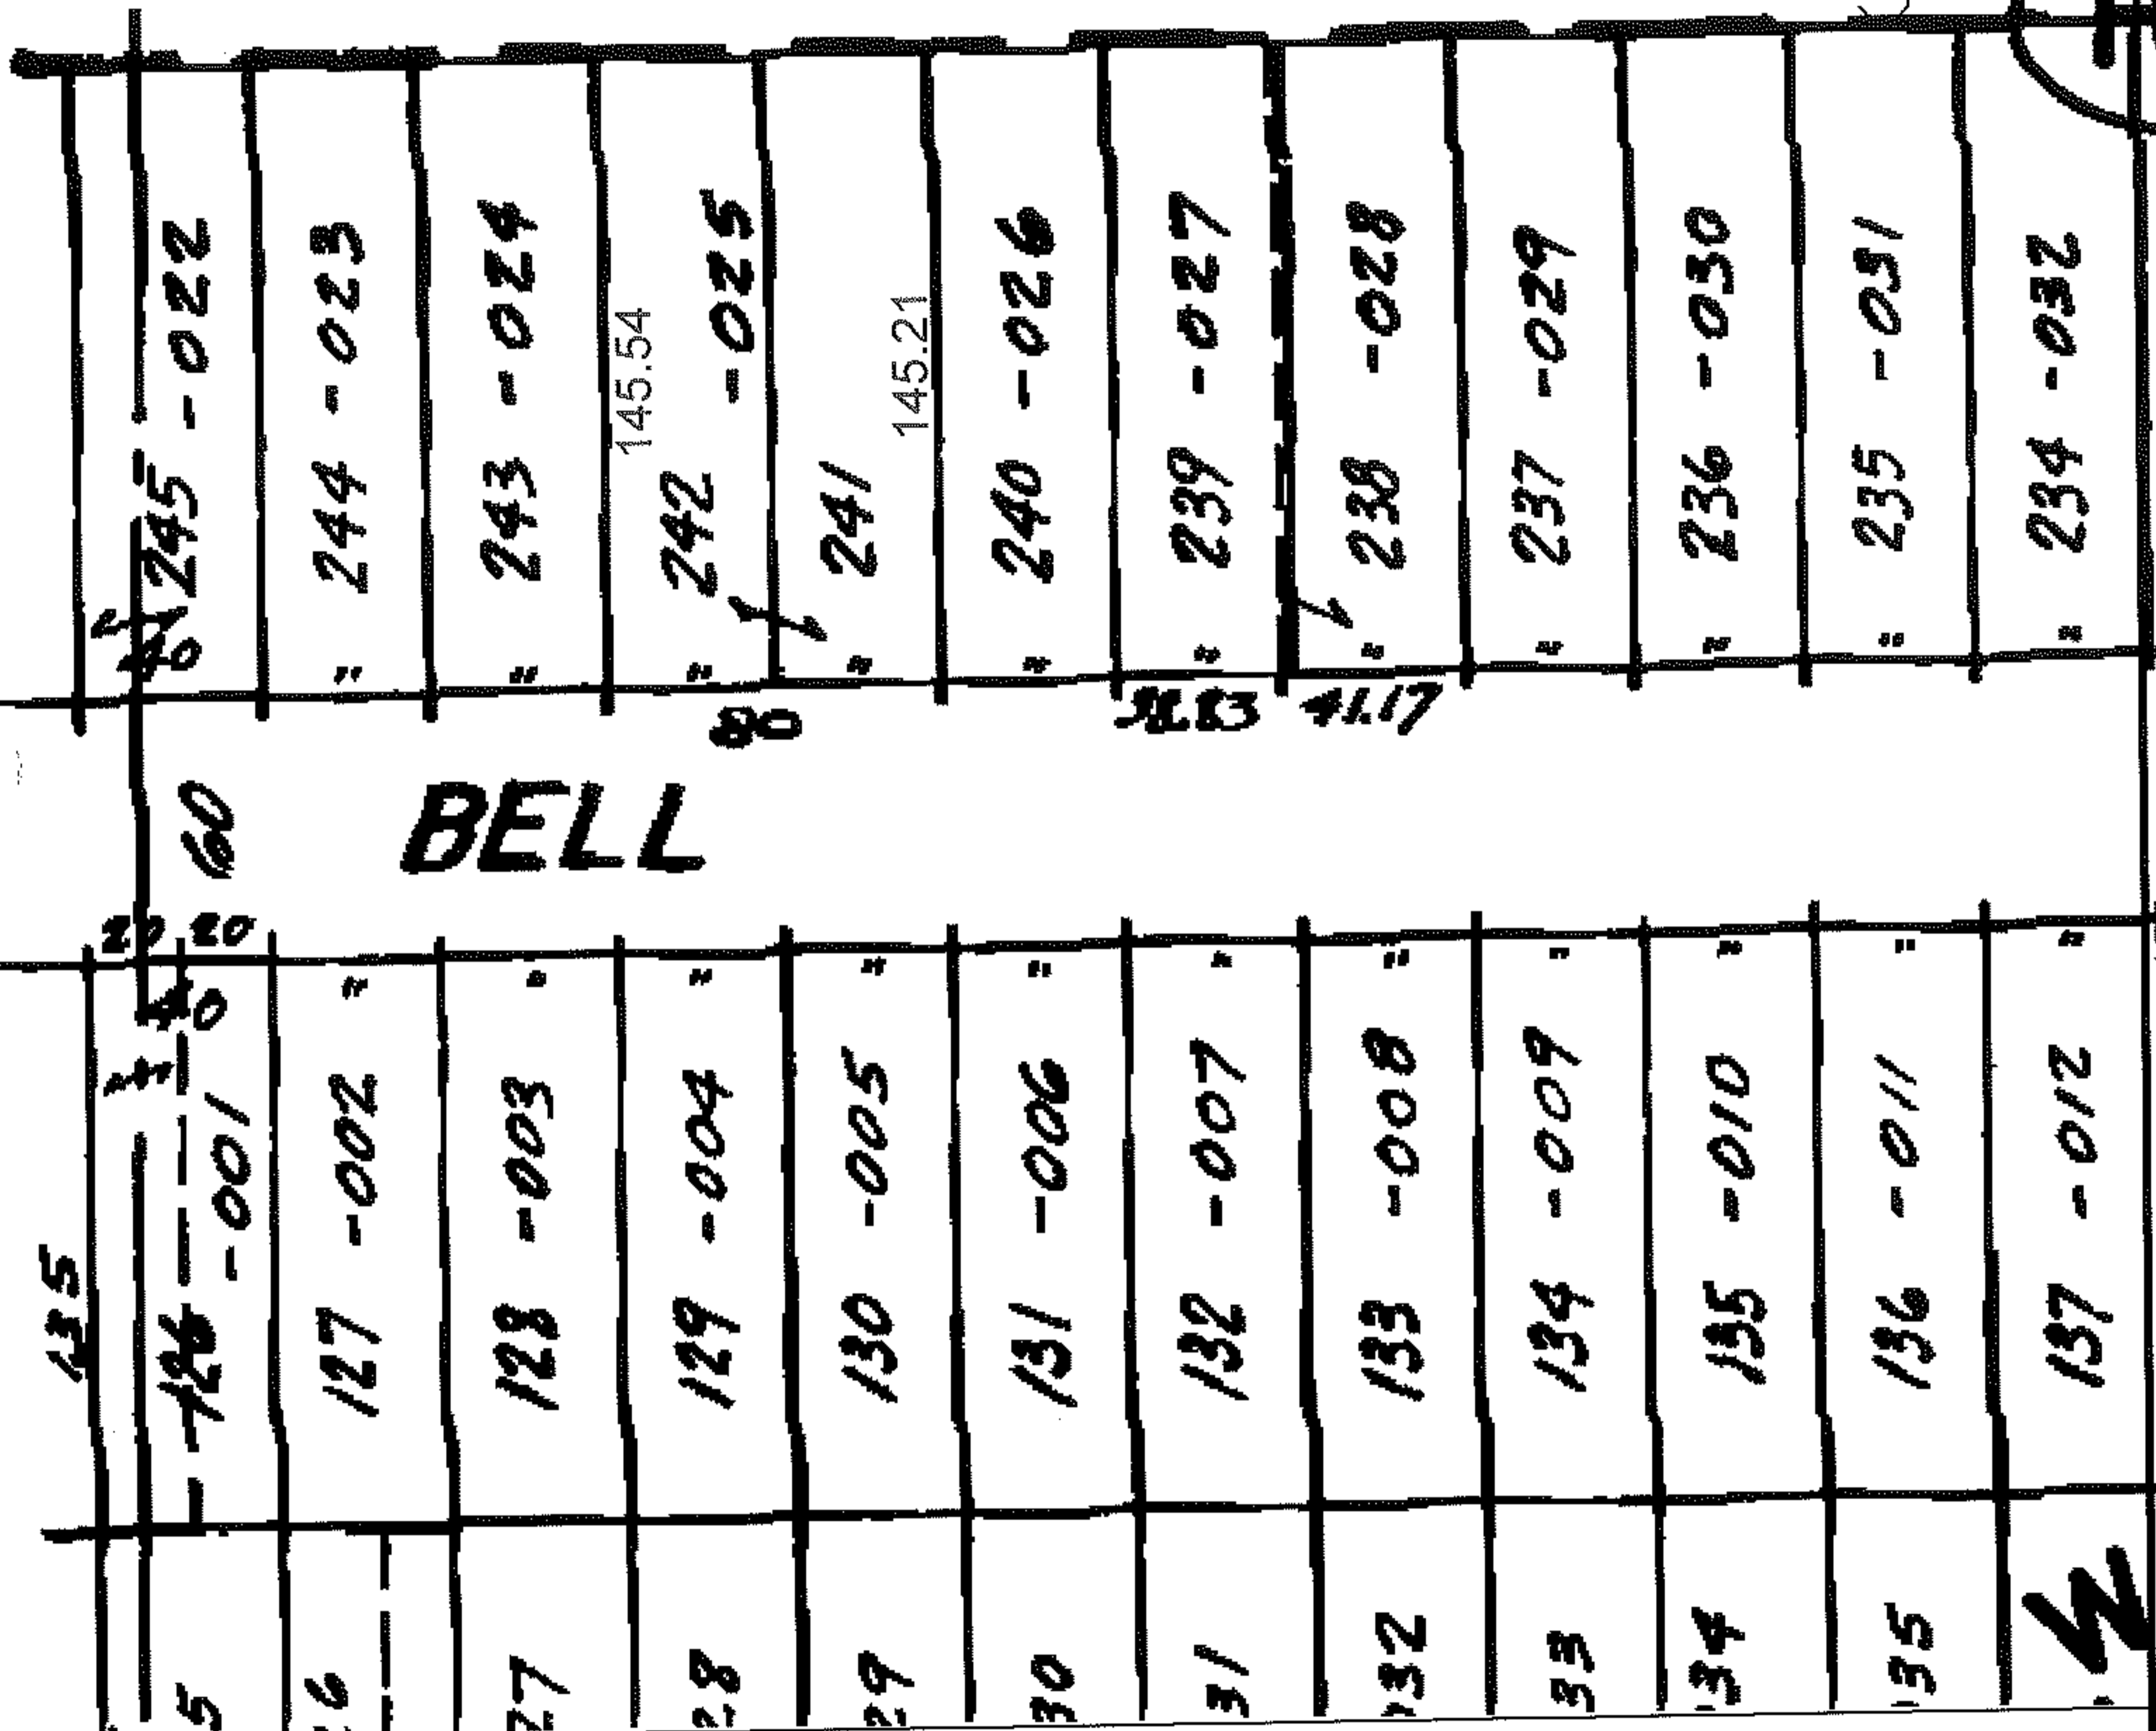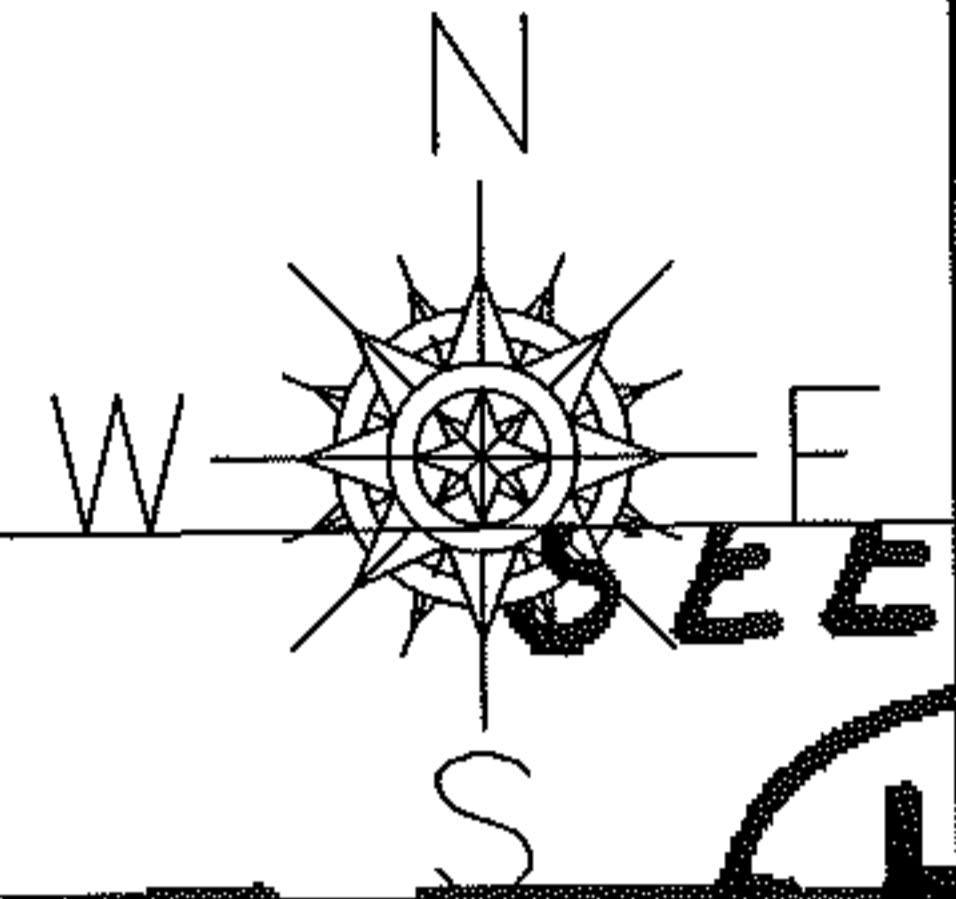

BELL

SPLITS/DEEDS PROCESSED

LORAIN COUNTY TAX MAP DEPARTMENT
226 MIDDLE AVE. ELYRIA, OHIO

SURVEYED BY: N/A
 CLOSURE: N/A
 MAP PAGE(S): 06-80
 APPROVED BY: DRH DATE: 9/1/2009
 SCALE: NOT TO SCALE PRIOR INST.: 20020803773.