



MASTER

PARENT PARCEL: 01-00-065-000-018, -017

CHILD PARCEL: 01-00-065-019 THRU -021

STARTING POINT: CENTERLINE OF SPERRY RD. & GOR ORPHANAGE RD.

NO. 01881

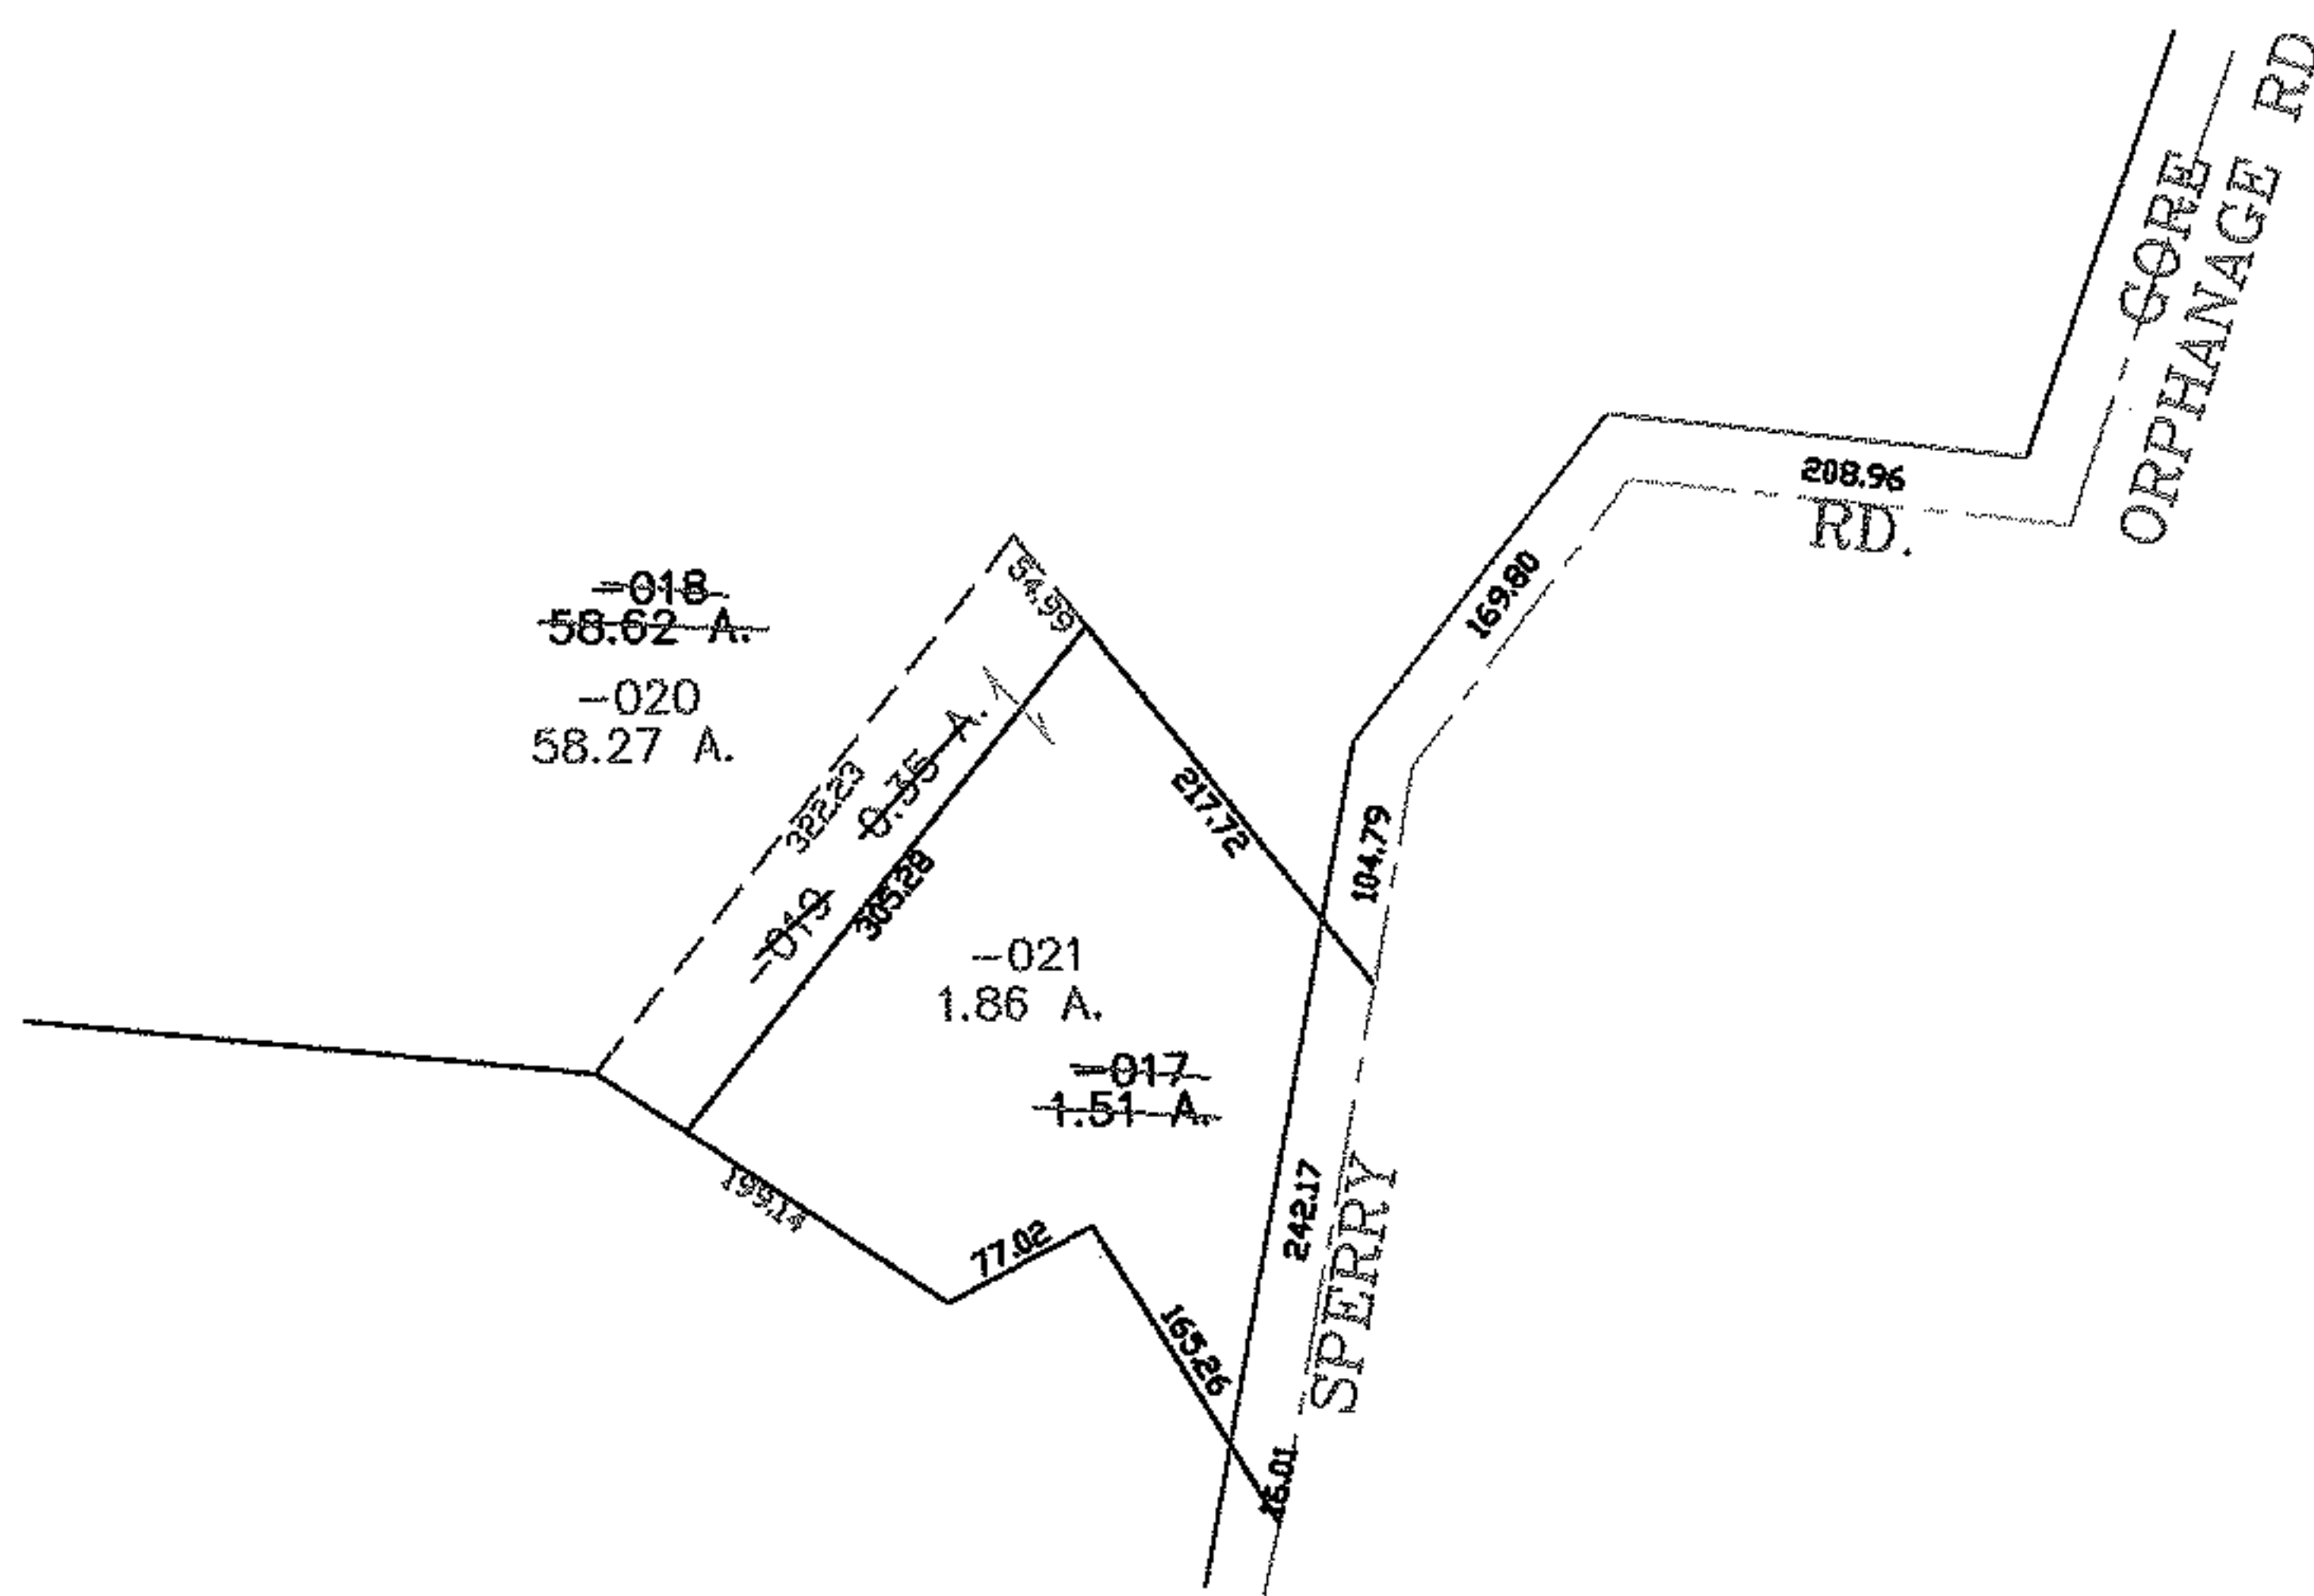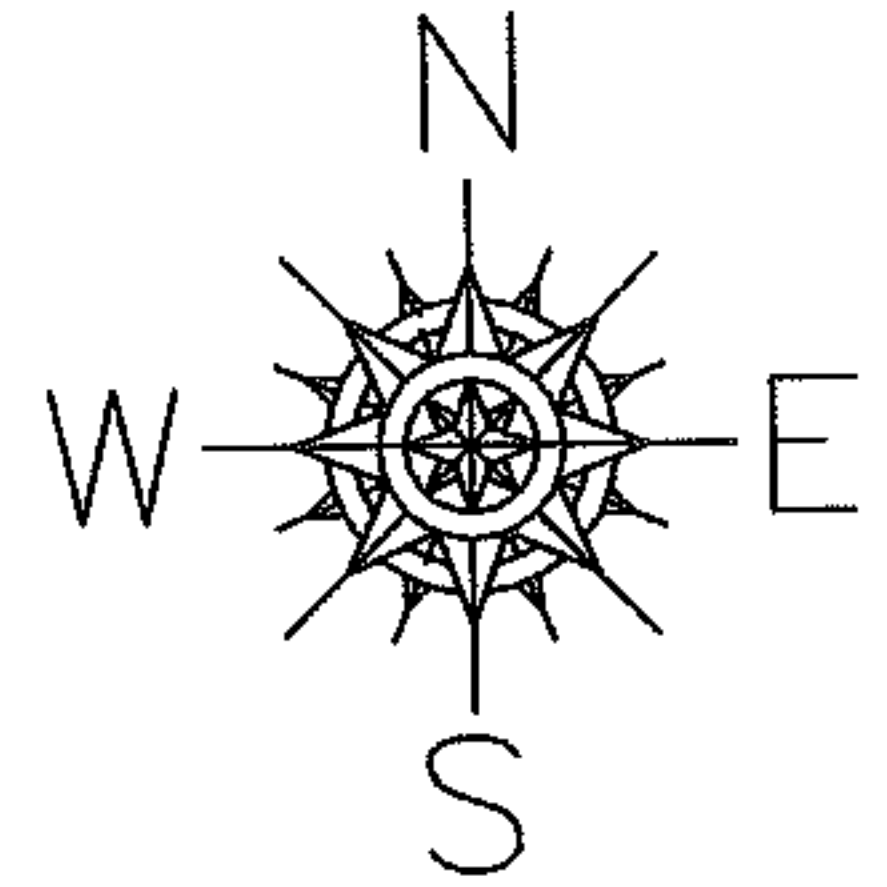

**SPLITS/DEEDS PROCESSED**  
LORAIN COUNTY TAX MAP DEPARTMENT  
226 MIDDLE AVE. ELYRIA, OHIO

SURVEYED BY: M.G. HURA  
CLOSURE: 0.00 ; 10.000  
MAP PAGE(S): 01-00-065-B  
APPROVED BY: JAH DATE: 3-16-05  
SCALE: 1"= 200 PRIOR INSTRUMENT: 20020841003