


RASTER

PARENT PARCEL: --ADD TO DUP--

09-01883-X

LD PARCEL: 01-00-006-102-054

STARTING POINT: SE CORNER OF O.L. 6

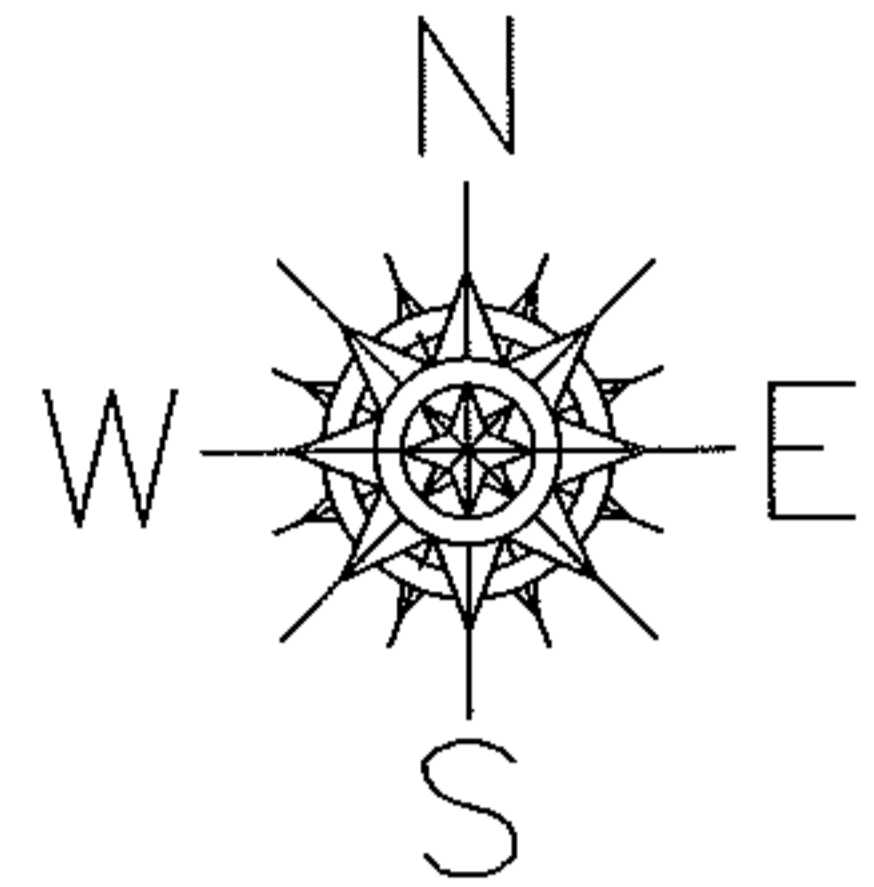

LIBERTY AVE

6.00

104.28

60.00

425.70

321.42

-054
0.50 A.

ADD TO DUP.
PER DEEDS
AND SURVEY
T. SIMON


66.00

-045
~~59.62 A.~~
59.05 A.

2539.67

990.79

O.L. 6 O.L. 7
O.L. 11 O.L. 12

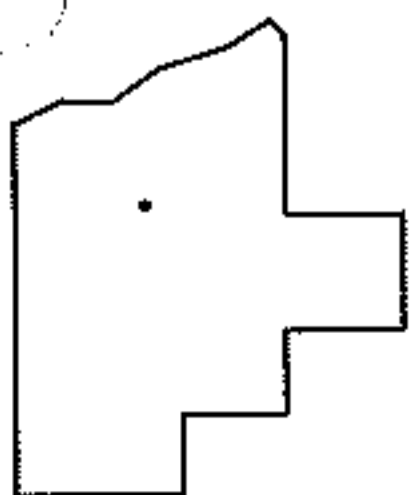

SPLITS/DEEDS PROCESSED

LORAIN COUNTY TAX MAP DEPARTMENT
226 MIDDLE AVE. ELYRIA, OHIO

SURVEYED BY: THOMAS A. SIMON

CLOSURE: 1:10,000

MAP PAGE(S): 01-C

APPROVED BY: DRH DATE: 9/11/2009

SCALE: 1"= 100 PRIOR INST.: DVJ / 117