

RASTER


PARENT PARCEL: 09-00-087-103-008

CHILD PARCEL: 09-00-087-103-014, -015

STARTING POINT: INT CL EAST LORAIN ST AND OBERLIN RD

09-01884-D

UNCOMBINATION

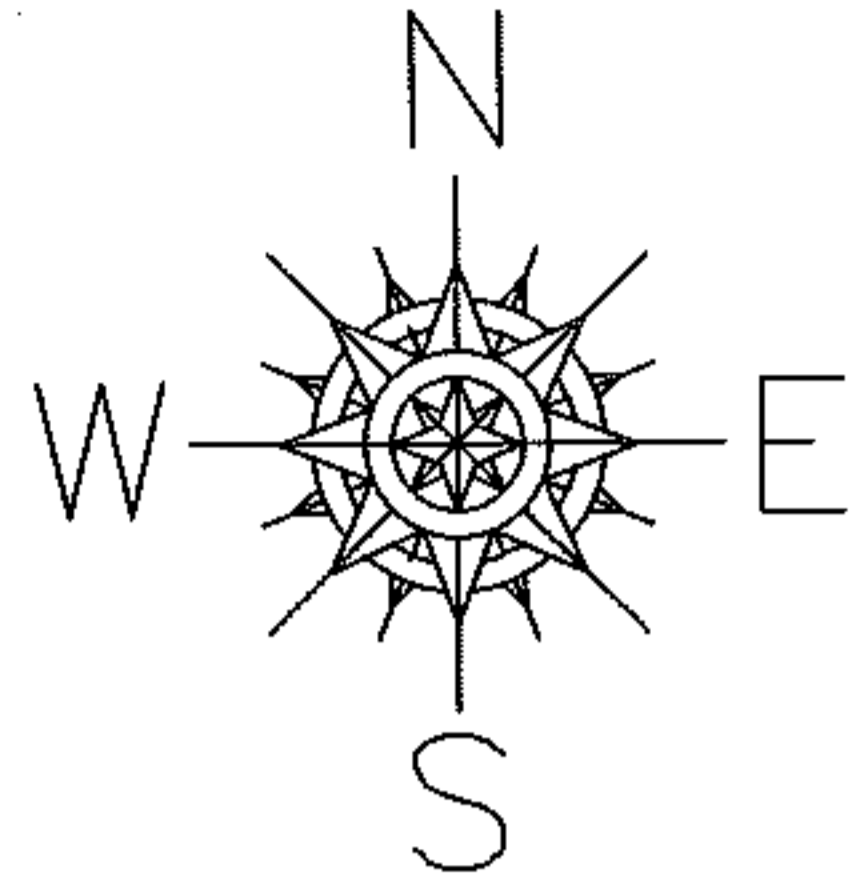

EAST LORAIN ST.

233.70

478.30

932.42

-014
5.00 A.

931.81

~~-008~~
~~15.00 A.~~

-015
10.00 A.
10.22 A.


930.55

OBERLIN RD

233.70

478.30

EAST COLLEGE ST.

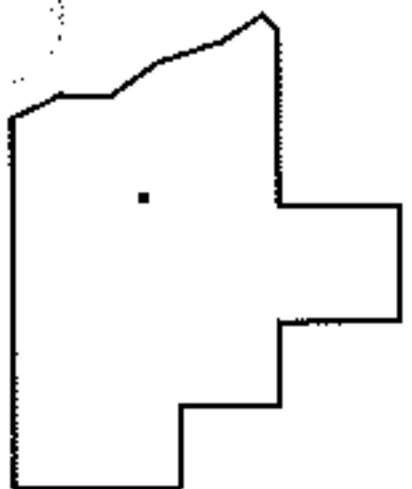

SPLITS/DEEDS PROCESSED

LORAIN COUNTY TAX MAP DEPARTMENT
226 MIDDLE AVE. ELYRIA, OHIO

SURVEYED BY: LORAIN COUNTY ENGINEER

CLOSURE: 1:10,000

MAP PAGE(S): 09-00-087-B

APPROVED BY: DRH DATE: 9/11/2009

SCALE: 1"= 200 PRIOR INST.: OR 80/64