
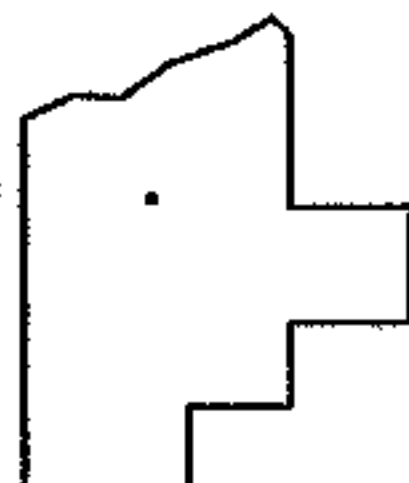
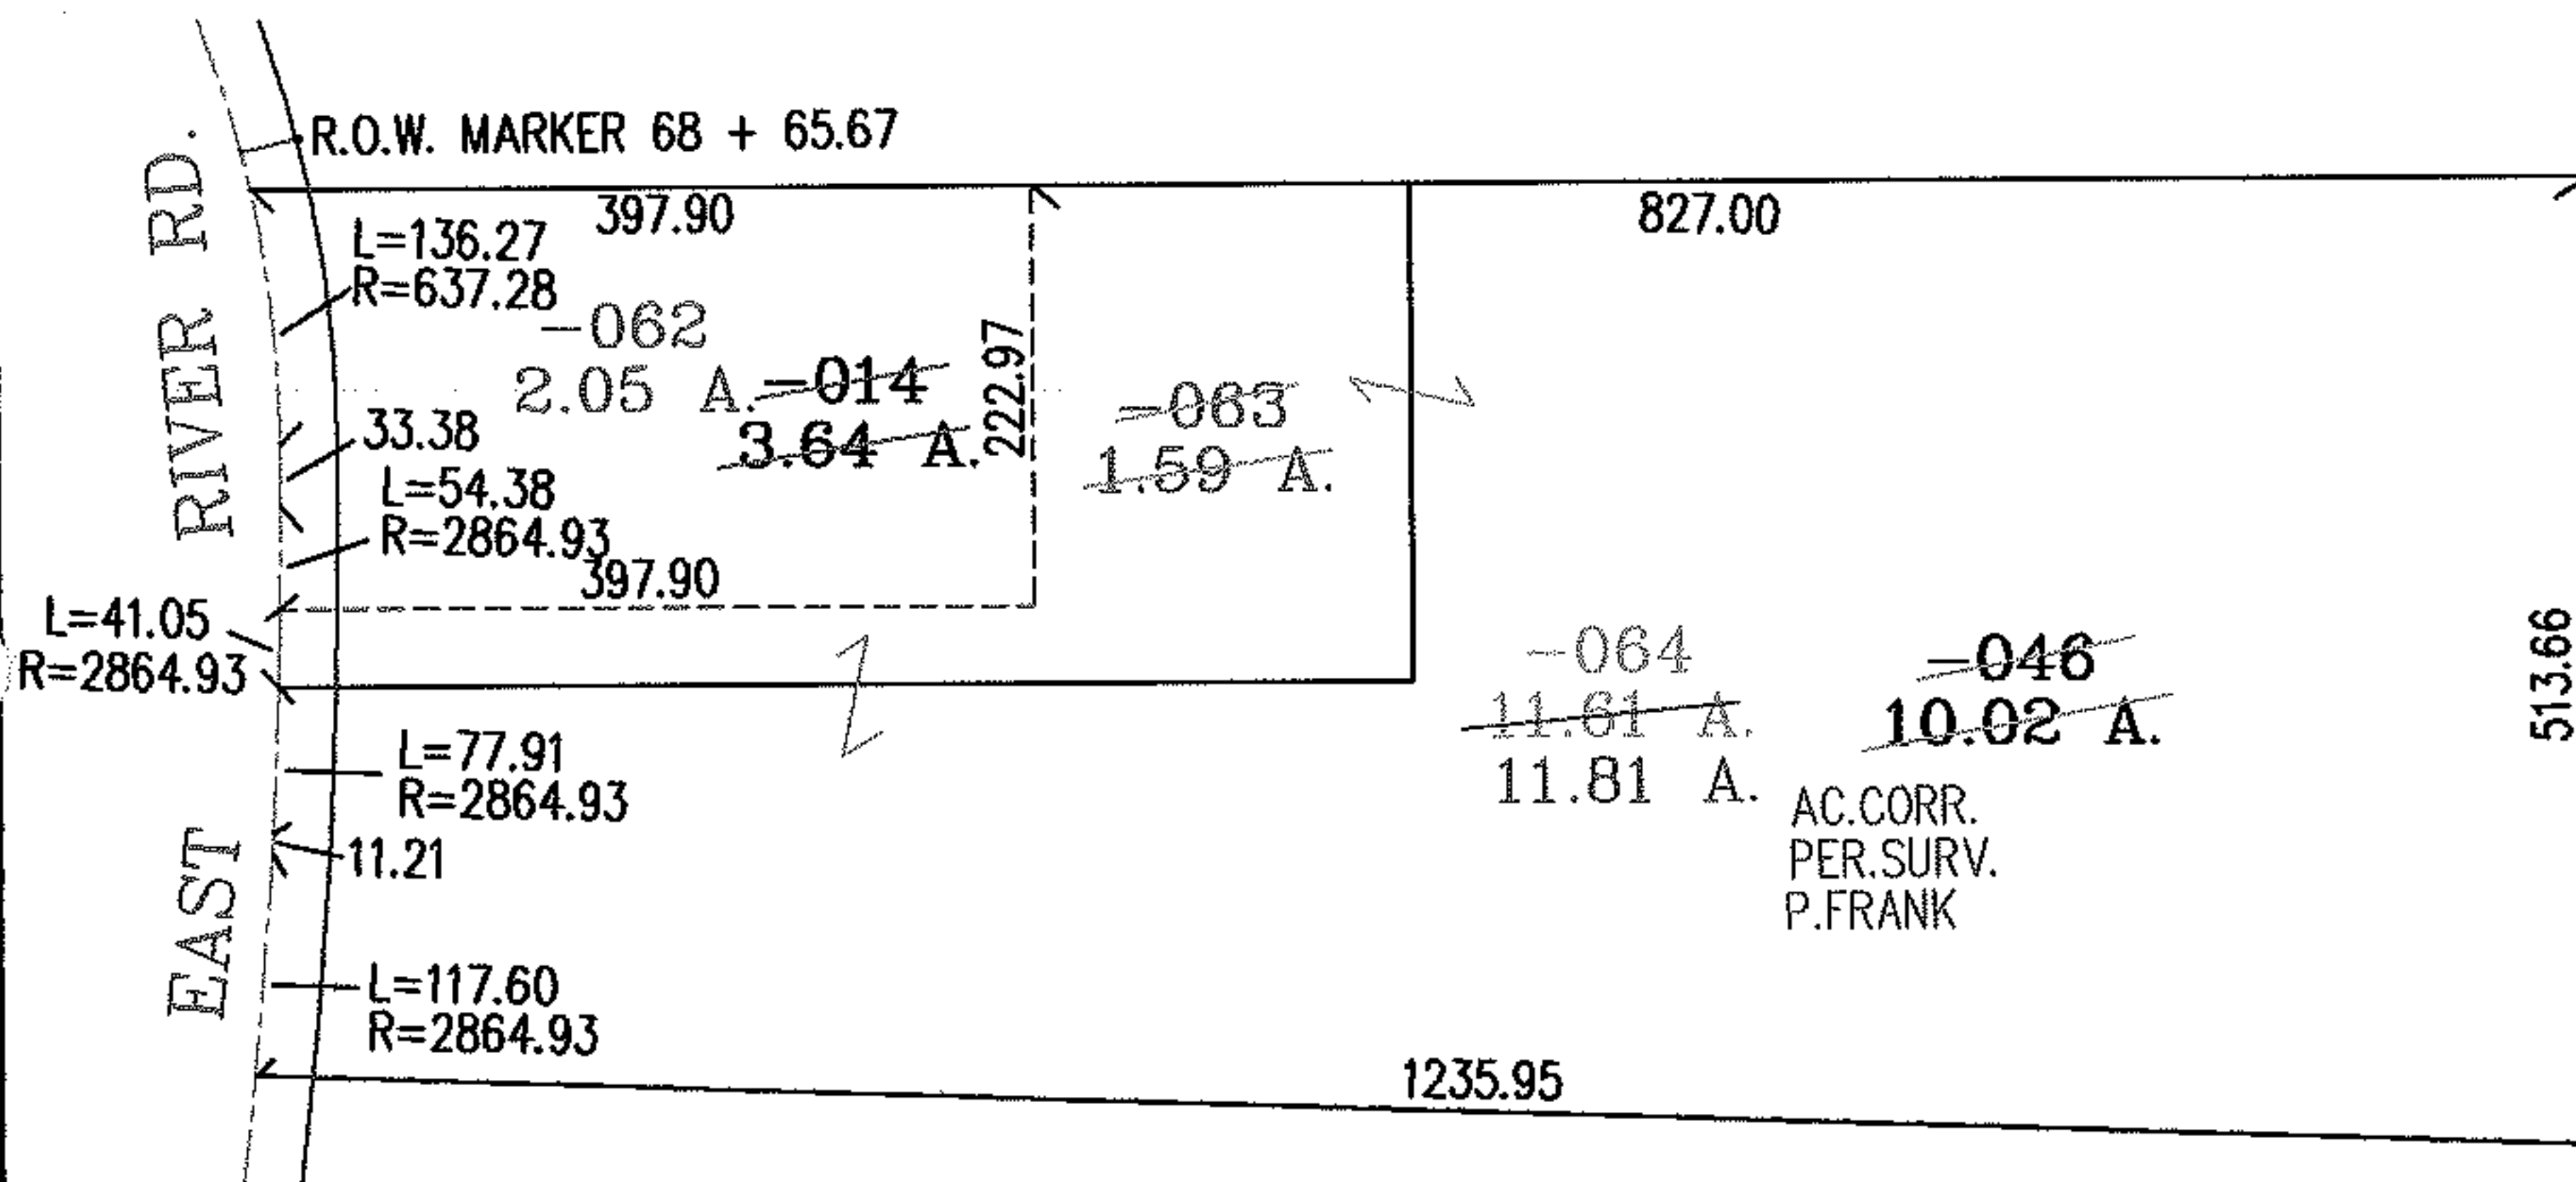


PARENT PARCEL: 12-00-033-000-014,-046

CHILD PARCEL: 12-00-033-000-062 THRU -064

STARTING POINT: EAST RIVER RD. RIGHT OF WAY MONUMENTS STATION 68+65.67

NO. 01885

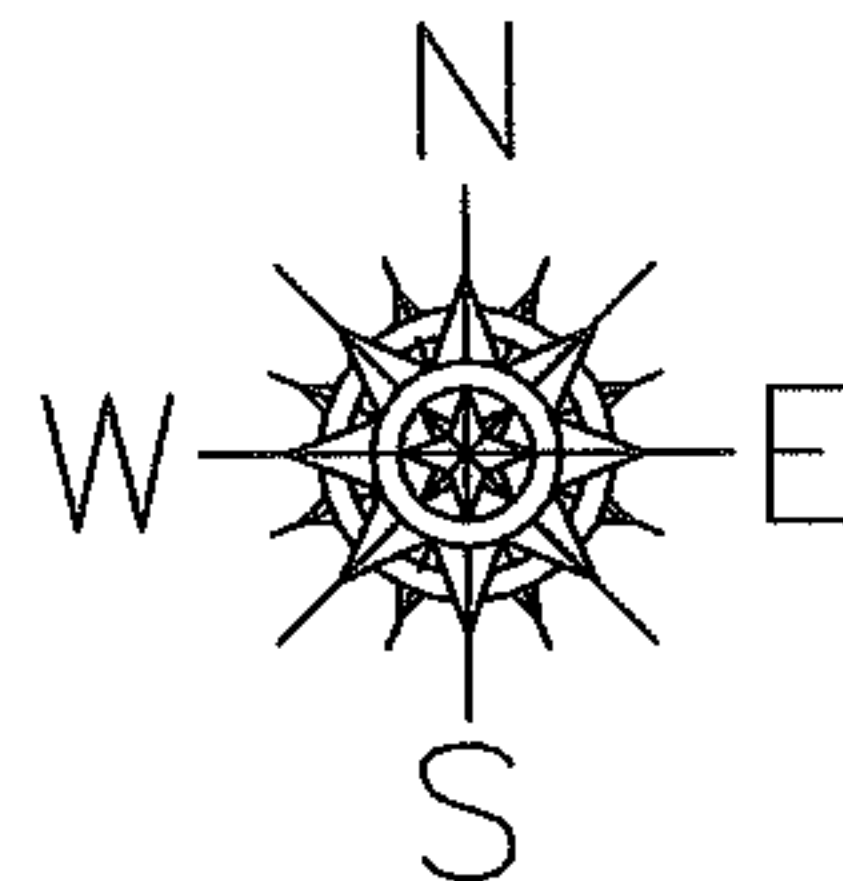

SPLITS/DEEDS PROCESSED
 LORAIN COUNTY TAX MAP DEPARTMENT
 226 MIDDLE AVE. ELYRIA, OHIO

SURVEYED BY: PAUL A. FRANK
 CLOSURE: .00:10.000
 MAP PAGE(S): 12-00-033-B
 APPROVED BY: RRM DATE: 5-18-05
 SCALE: 1" = 200' PRIOR INSTRUMENT: 20030955489