

RADFR




PARENT PARCEL: 10-00-006-113-025

09-01893-C

CHILD PARCEL: --SAME--

STARTING POINT: NE CORNER OF S/L 12 YUNKER COURT EXTENSION

FRONTAGE & DEPTH CORR PER DEED 82.89 X 160

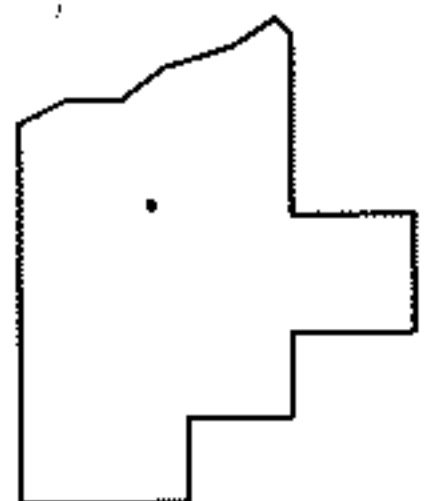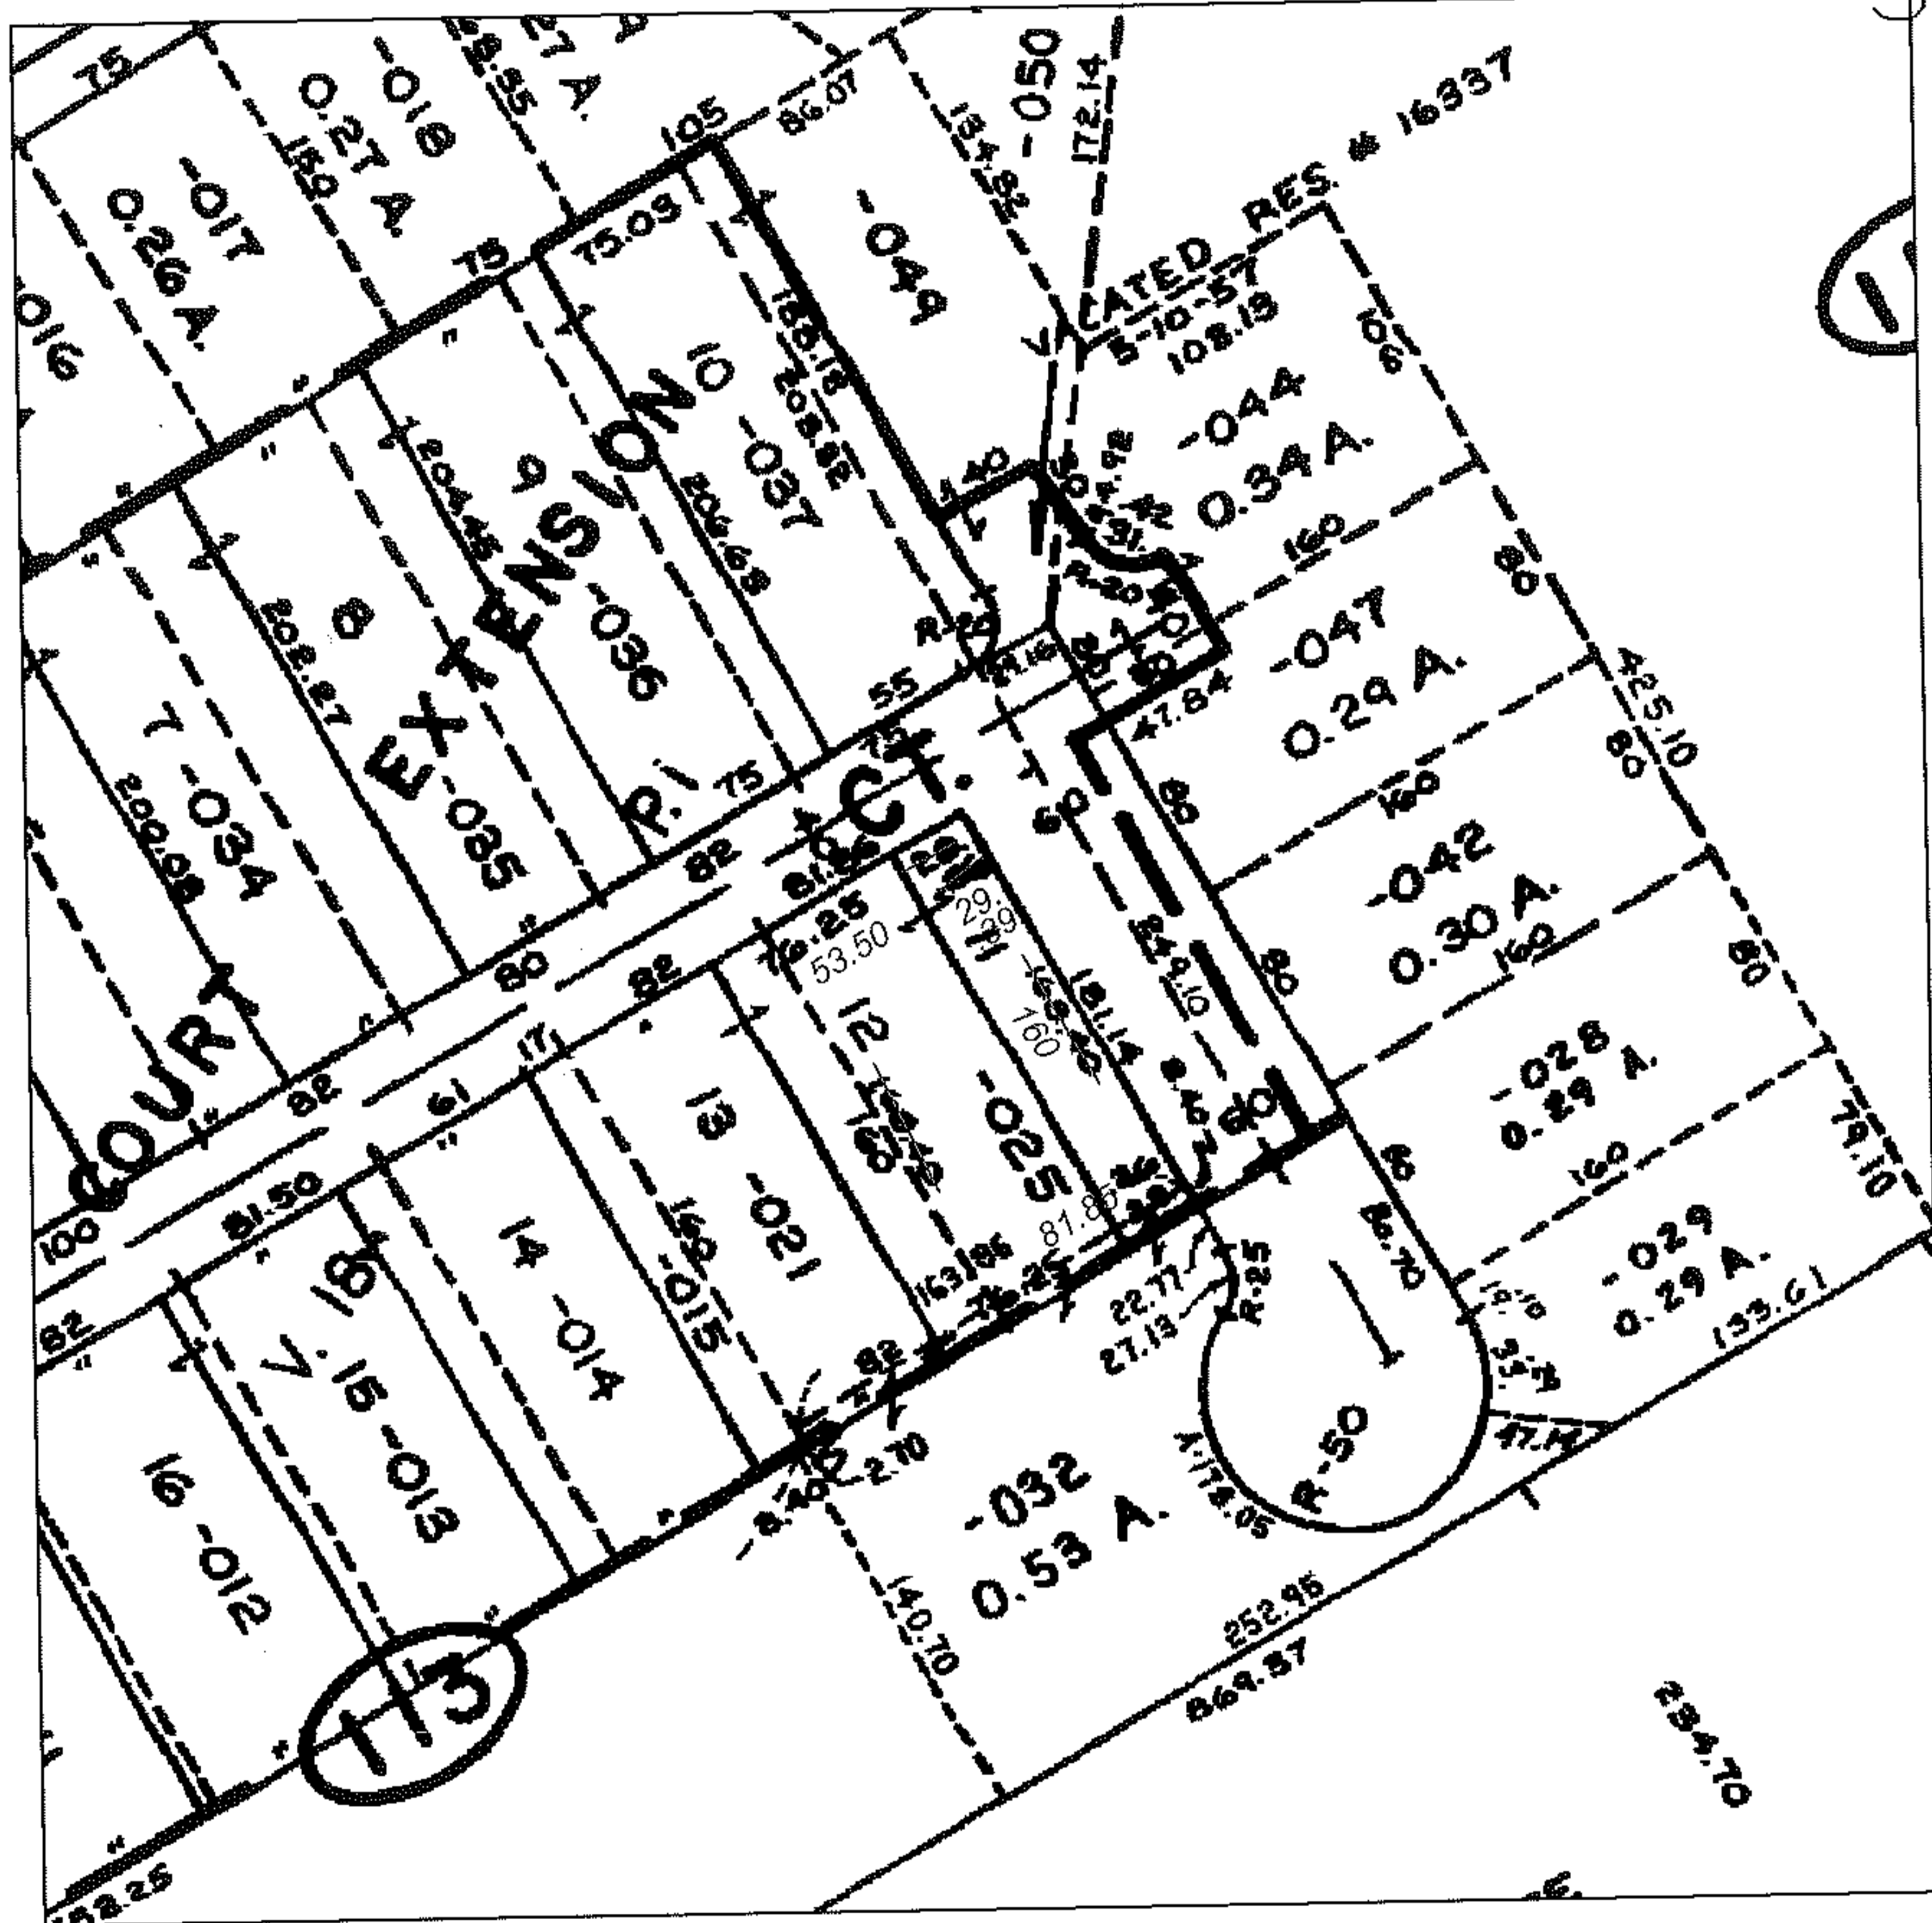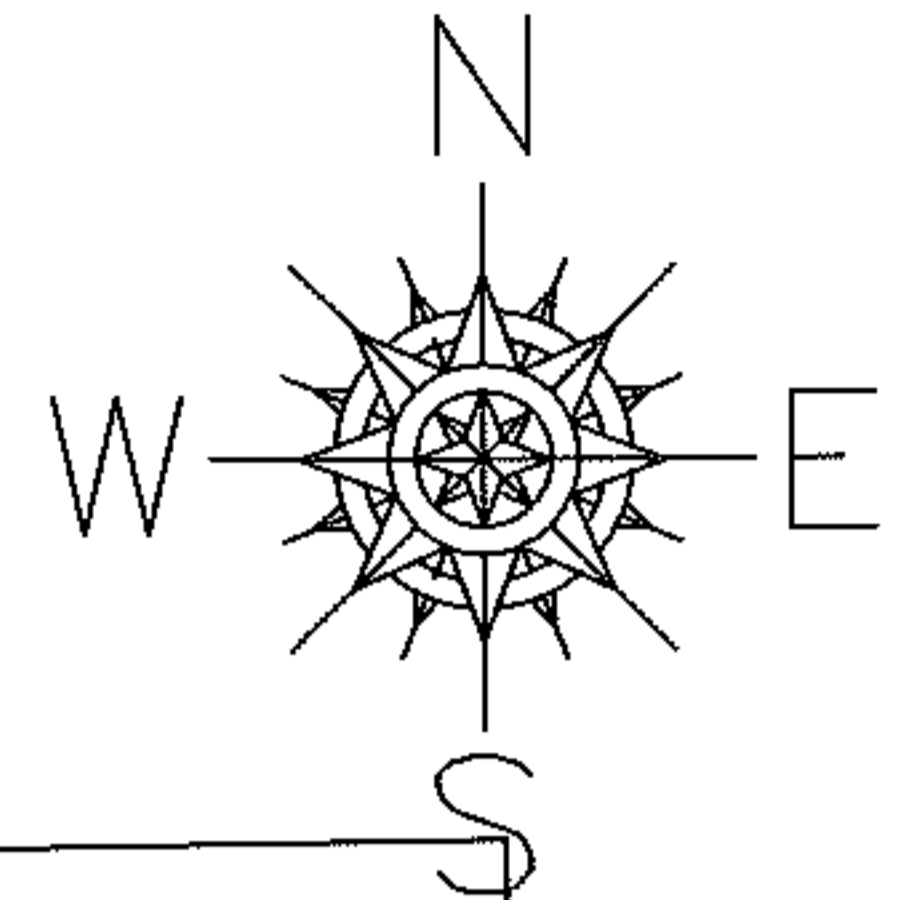

SPLITS/DEEDS PROCESSED

LORAIN COUNTY TAX MAP DEPARTMENT
226 MIDDLE AVE. ELYRIA, OHIO

SURVEYED BY: N/A

CLOSURE: N/A

MAP PAGE(S): 10-00-006-D

APPROVED BY: DRH DATE: 9/28/2009

SCALE: NOT TO SCALE PRIOR INST.: 20060119915