


RASTER

PARENT PARCEL: 04-00-002-105-013 & -014
CHILD PARCEL: XX-XX-XXX-XXX-XXX
STARTING POINT: XXXXXX

09-01894-C

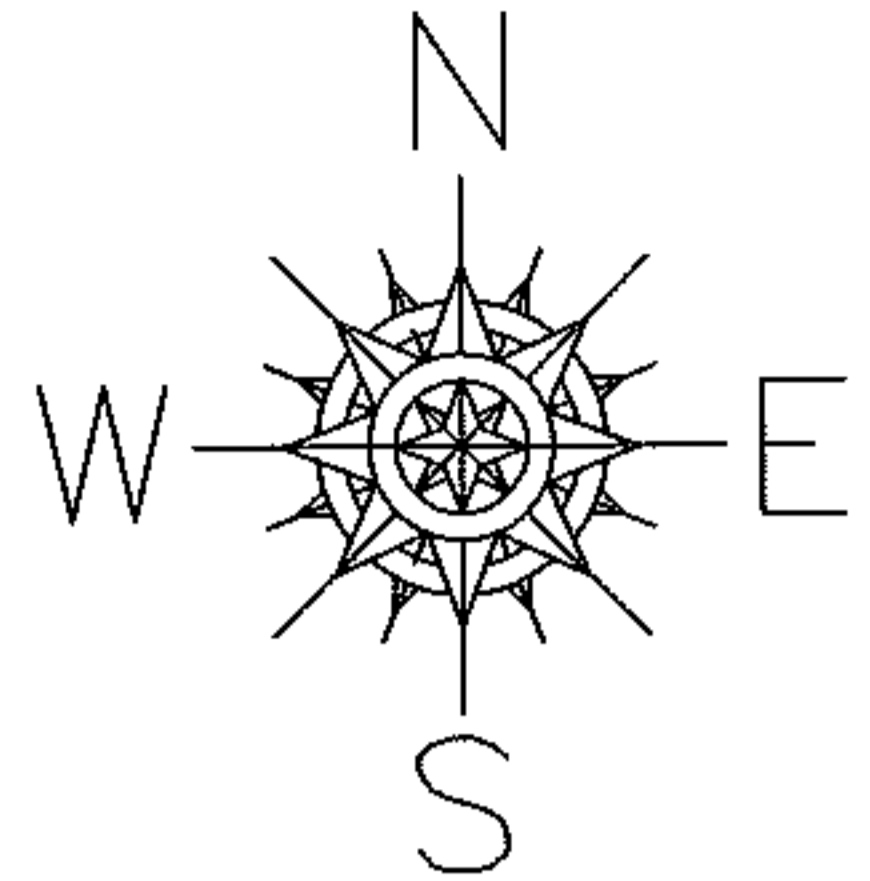

ARLINGTON PLACE SUB. NO. 3
VOL. 95 PG. 42-45

NAME CORRECTION ON PLAT

BLOCK "M" 04-00-002-105-013 ~~OSTER CONST. CO.~~
4.80 A. OSTER CONST. CO. &
ARLINGTON PLACE HOMEOWNERS ASSOC.


BLOCK "N" 04-00-002-105-014 ~~OSTER CONST. CO.~~
0.25 A. ARLINGTON PLACE HOMEOWNERS ASSOC.

DROP FROM DUPLICATE

04-00-002-101-167
1.86 A.

04-00-002-101-168
0.53 A.

SHOULD HAVE GONE INTO PLAT

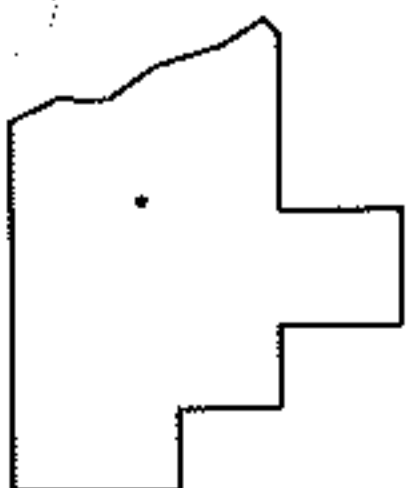

SPLITS/DEEDS PROCESSED
LORAIN COUNTY TAX MAP DEPARTMENT
226 MIDDLE AVE. ELYRIA, OHIO

SURVEYED BY: XXXXXXXXXXXX
CLOSURE: XXXXXX
MAP PAGE(S): 4-00-002-E
APPROVED BY: TJS DATE: 09/28/09
SCALE: 1"= 100 PRIOR INST.: DV XXXX/XXX