
PARENT PARCEL: 03-00-033-115-021


CHILD PARCEL: ___-SAME--

09-01895-D

RTING POINT: INT W LINE OF COVE BEACH ALLOTMENT AND WALKER RD

PARCEL GOES TO RIGHT OF WAY AND NOT C.L.
PER DEEDS
MAP CORRECTION ONLY

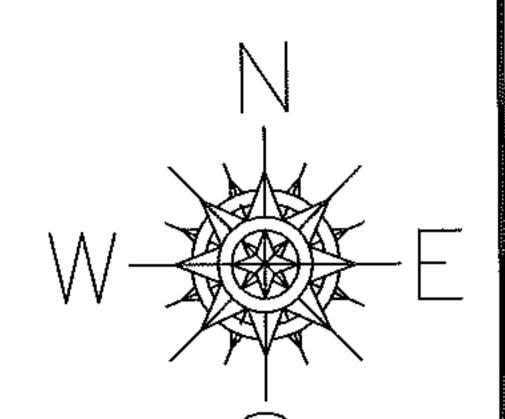

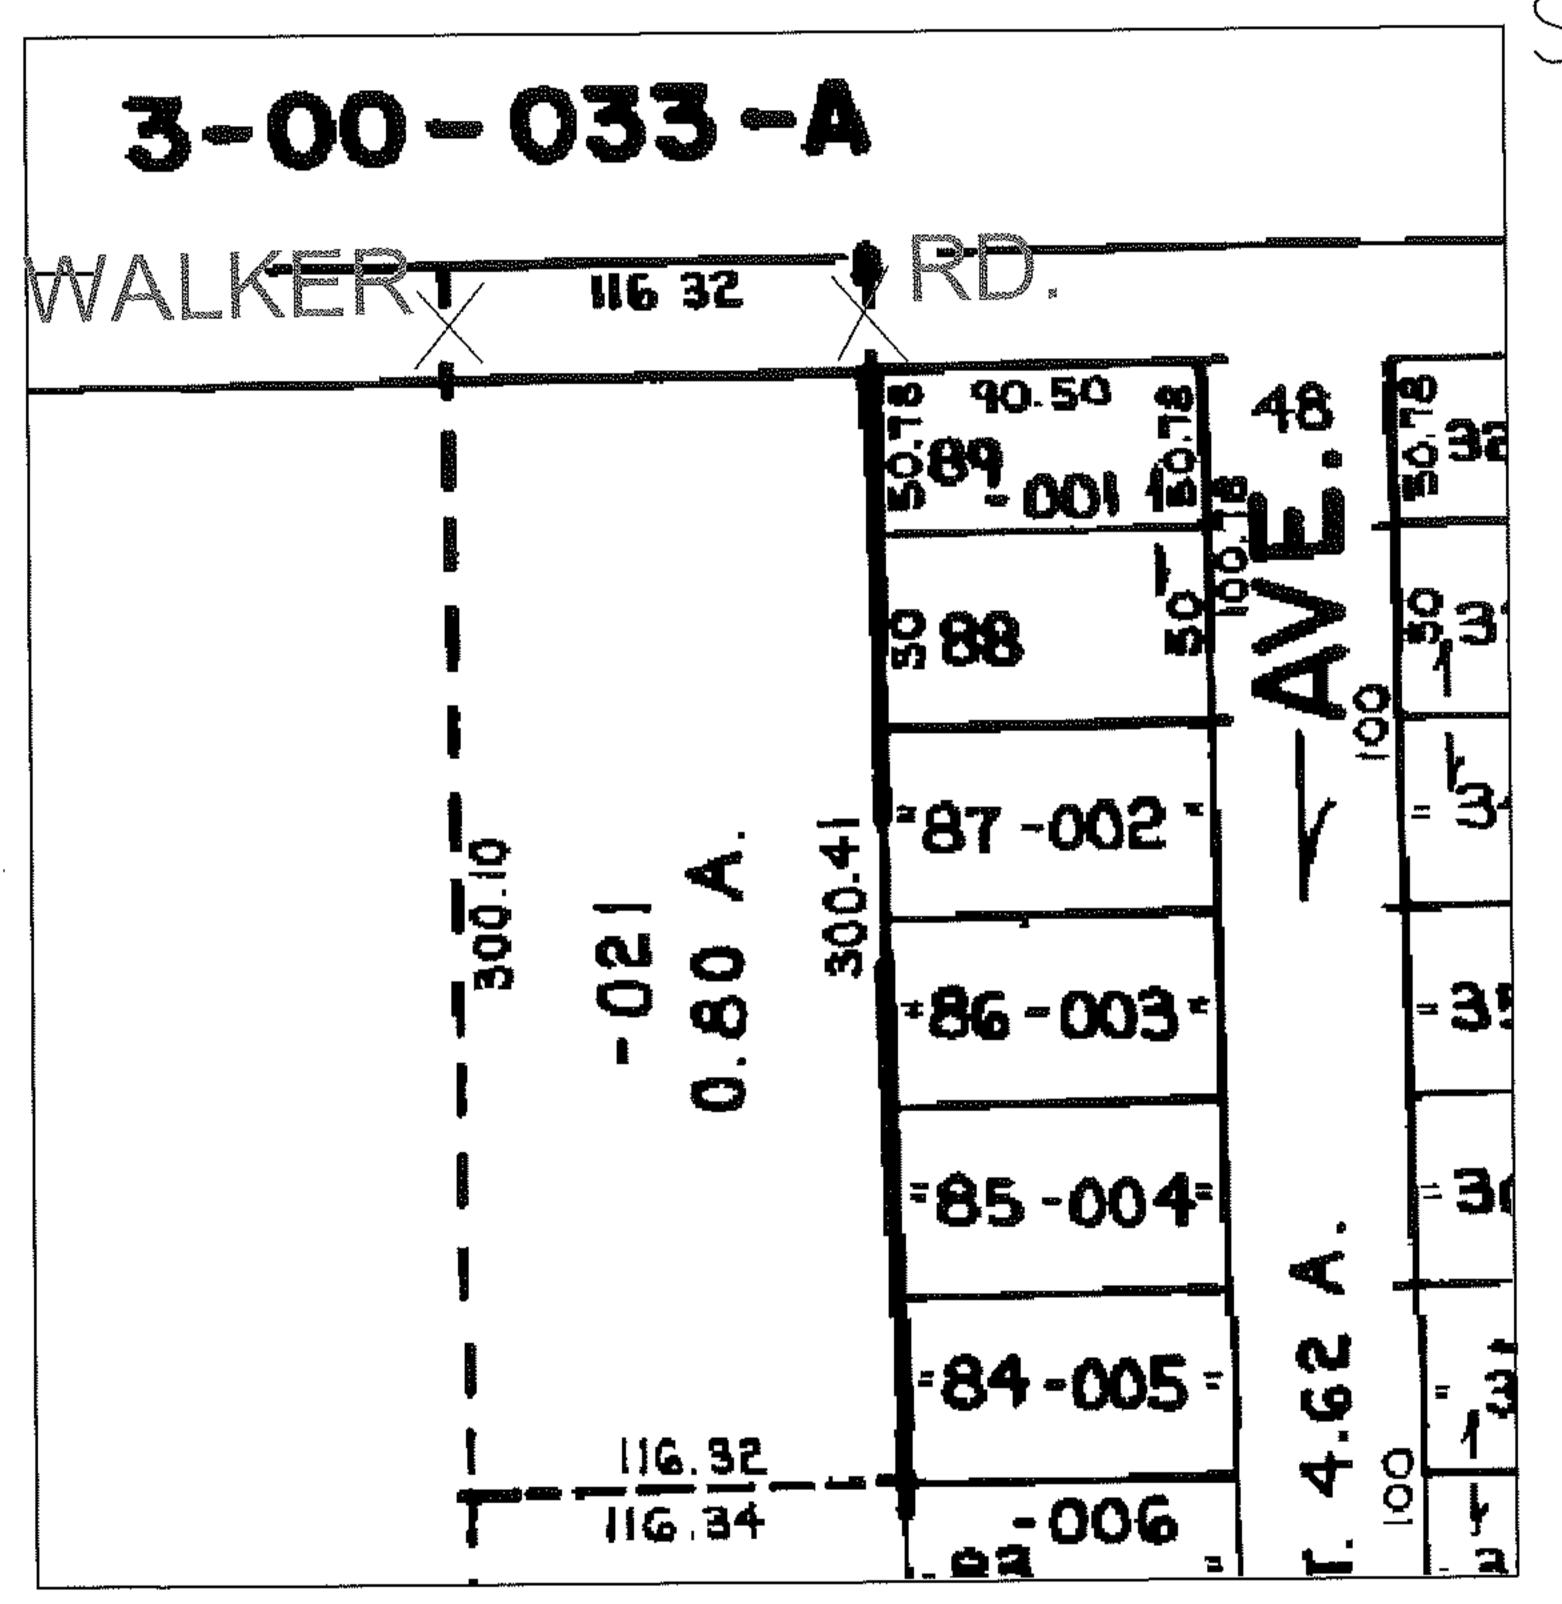

SPLITS/DEEDS PROCESSED

LORAIN COUNTY TAX MAP DEPARTMENT 226 MIDDLE AVE. ELYRIA, OHIO

SURVEYED BY: N/A

CLOSURE: N/A

MAP PAGE(S): <u>03-00-033-B</u>

APPROVED BY: <u>DRH</u> DATE: <u>9/30/2009</u>

SCALE: NOT TO SCALE PRIOR INST.: or 821/537