


RASTER

PARENT PARCEL: 06-25-001-000-079

CHILD PARCEL: 06-25-001-000-231, -232



STARTING POINT: CENTERLINE OF MICHAEL PKWY & SUGAR LANE

NO. 01897

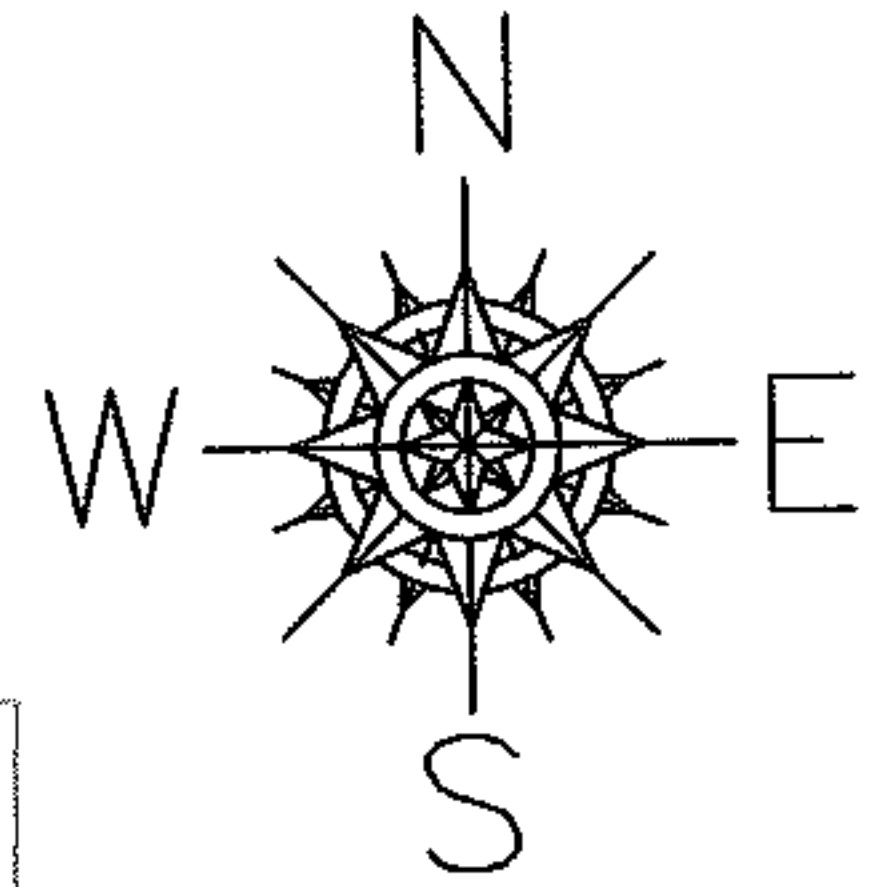

MICHAEL PKWY

SUGAR LANE

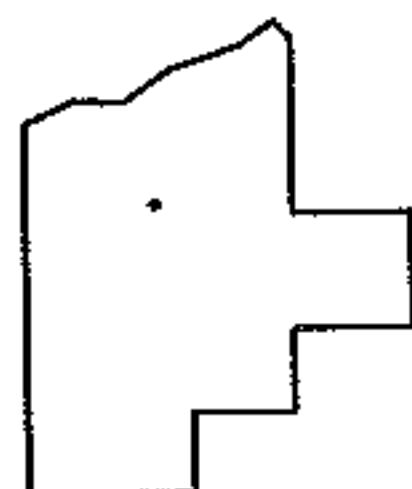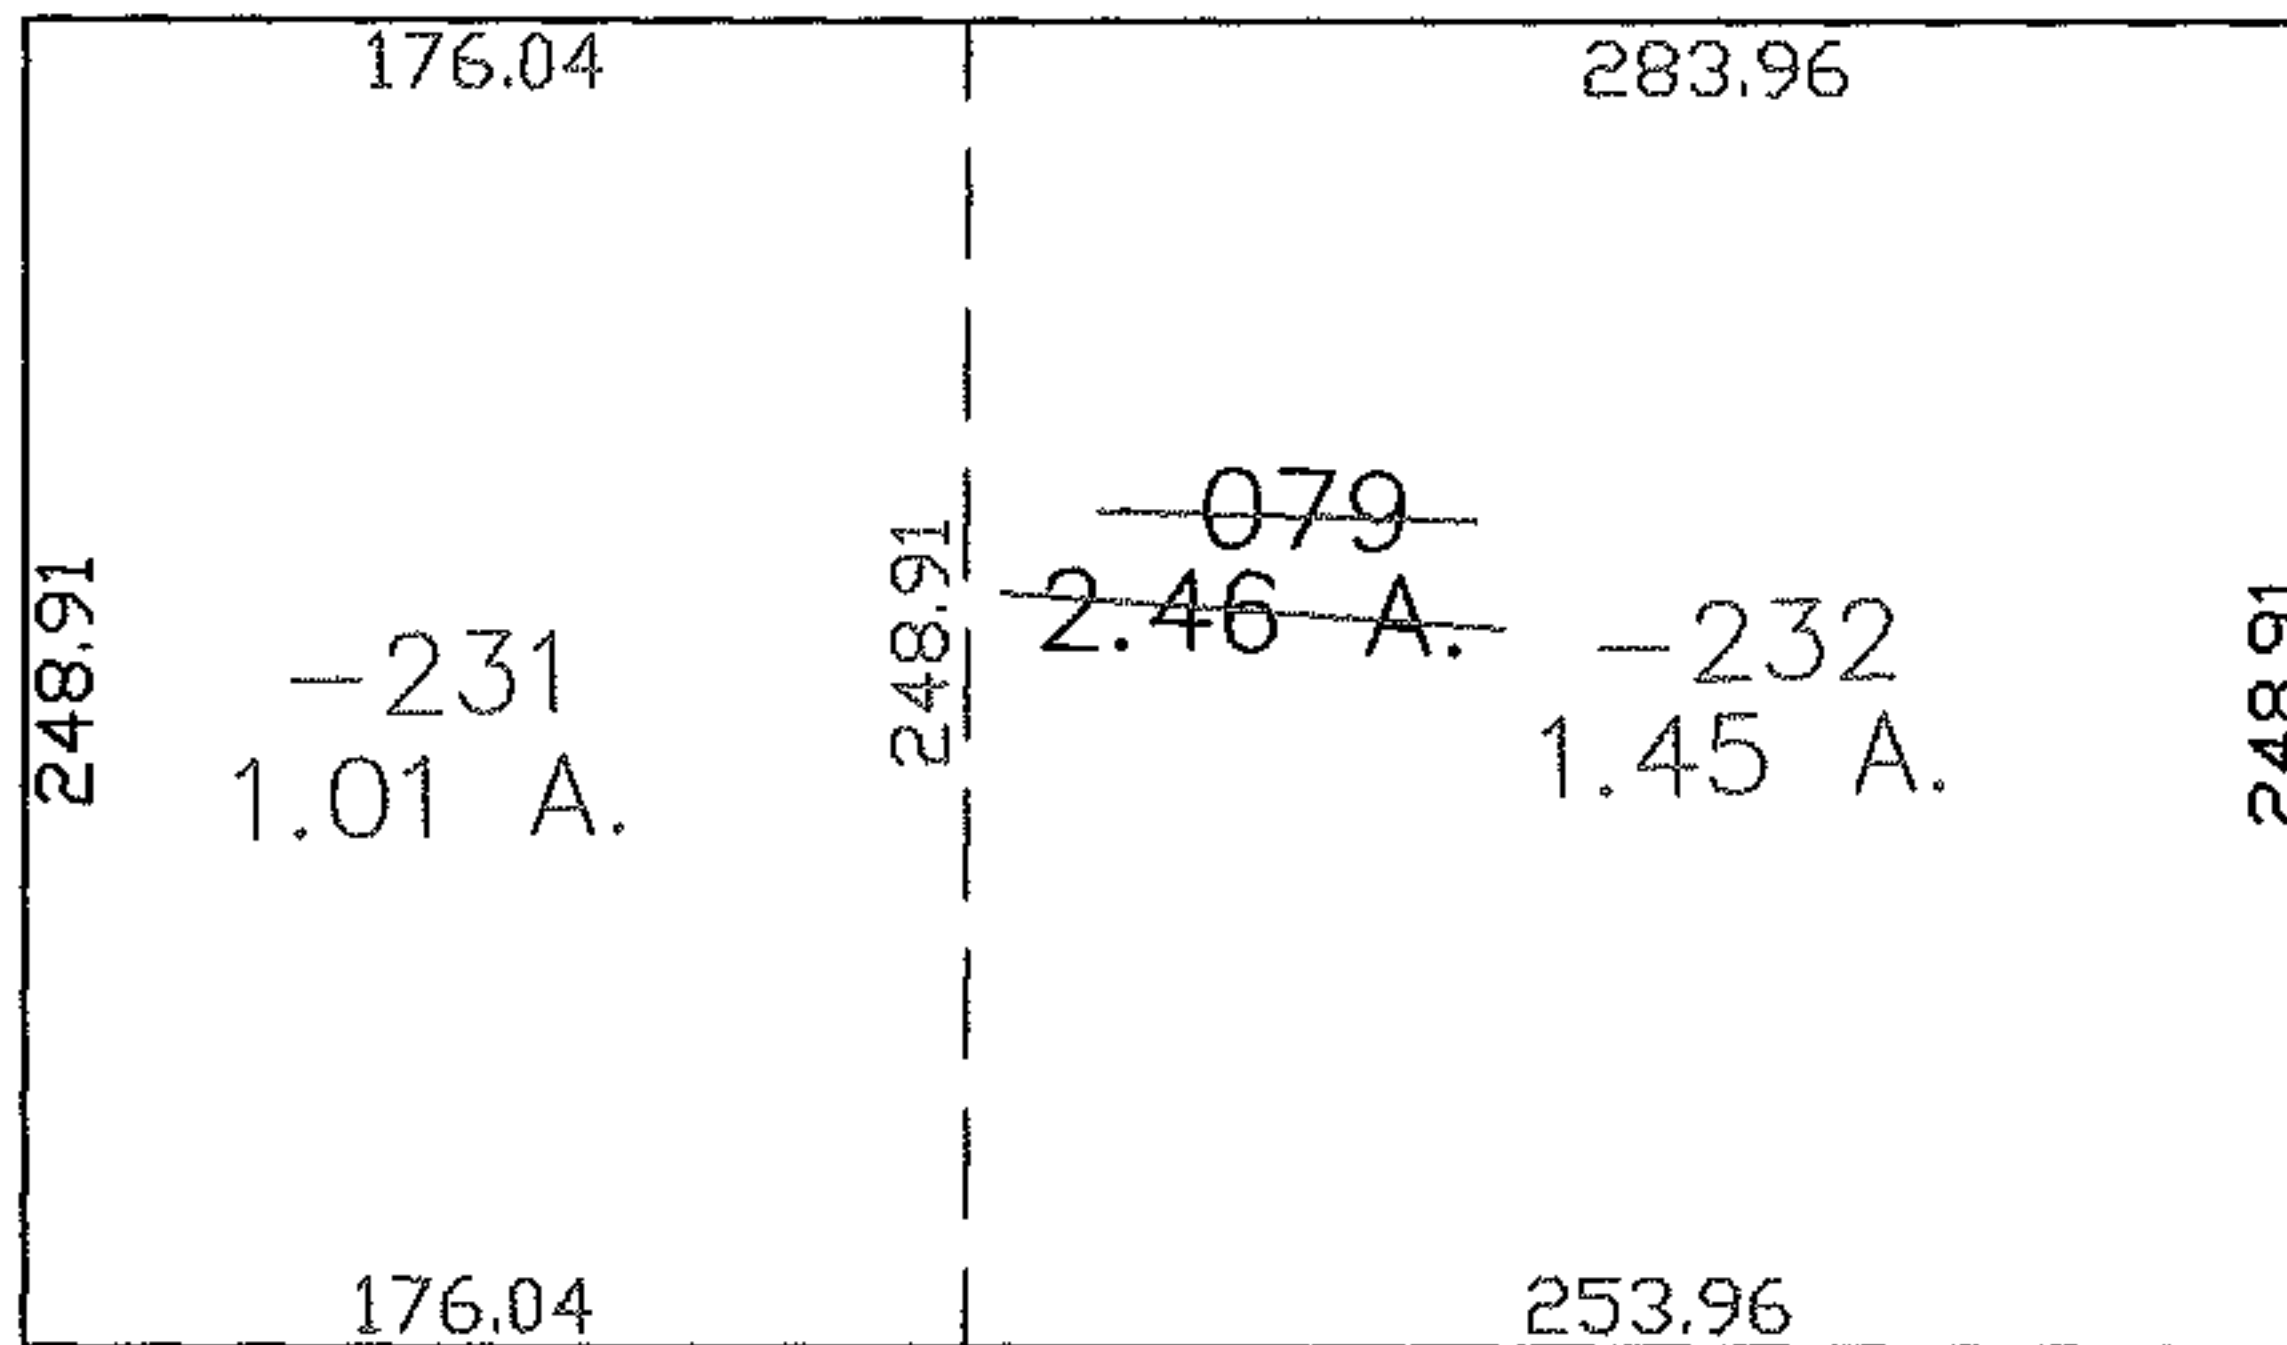

SPLITS/DEEDS PROCESSED
 LORAIN COUNTY TAX MAP DEPARTMENT
 226 MIDDLE AVE. ELYRIA, OHIO

SURVEYED BY: THOMAS A. SIMON
 CLOSURE: 0.00 : 10.000
 MAP PAGE(S): 6-143
 APPROVED BY: JAH DATE: 4-18-05
 SCALE: 1" = 100 PRIOR INSTRUMENT: 20050060536