
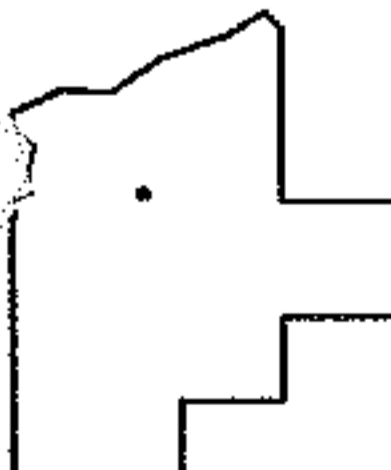
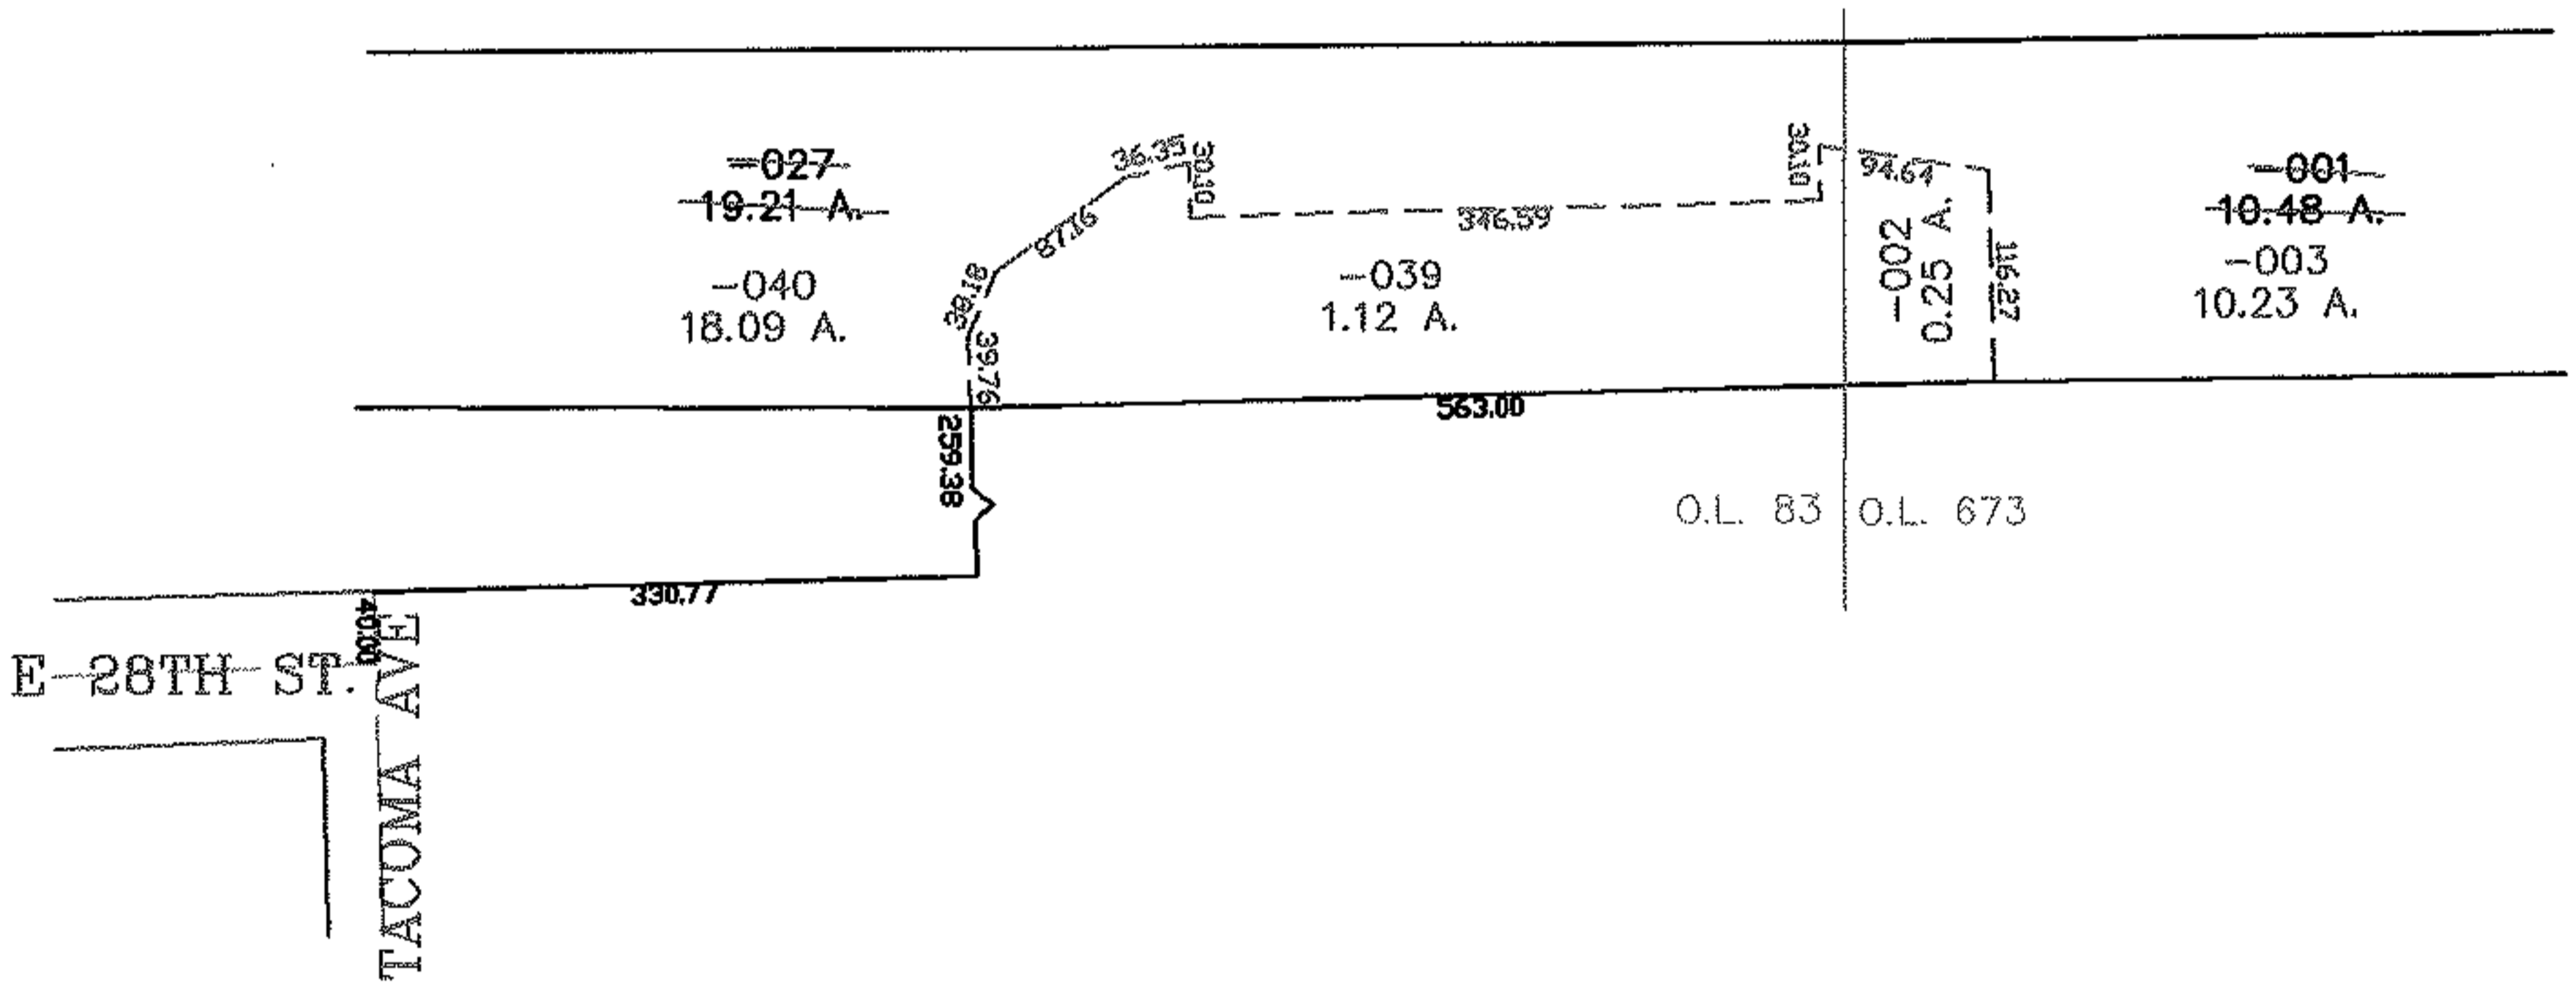


PARENT PARCEL: 03-00-083-101-027, 03-00-067-505-001  
CHILD PARCEL: 03-00-083-101-039, -040 03-00-067-505-002, -003  
STARTING POINT: CENTERLINE OF E 28TH ST. & TACOMA AVE.

NO. 01898

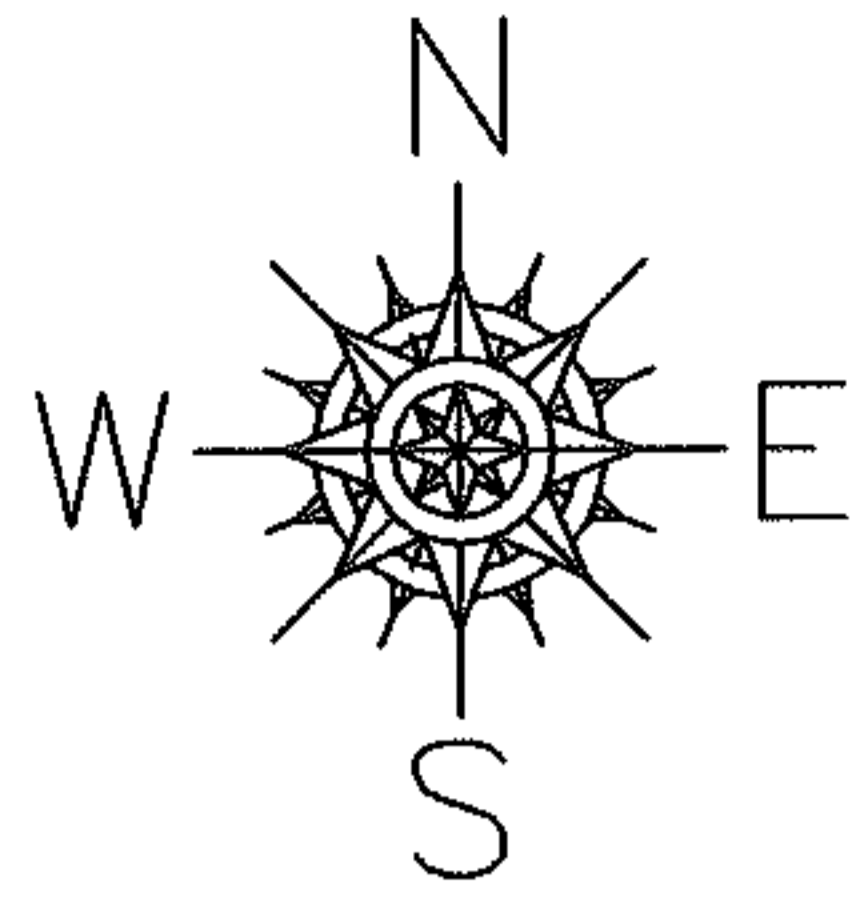

**SPLITS/DEEDS PROCESSED**  
LORAIN COUNTY TAX MAP DEPARTMENT  
226 MIDDLE AVE. ELYRIA, OHIO

SURVEYED BY: THOMAS SIMON  
CLOSURE: 0.00 : 10.000  
MAP PAGE(S): 03-00-083-B  
APPROVED BY: JAH DATE: 4-19-05  
SCALE: 1" = 200 PRIOR INSTRUMENT: OR 191/799