

PARENT PARCEL: 08-00-104-000-011,-012




CHILD PARCEL: 08-00-104-000-013 THRU -016

STARTING POINT: INTERSECTION OF C/L OF RUSSIA RD. AND C/L OF BAUMHART RD.

NO. 01899

BAUMHART RD.

RUSSIA RD.

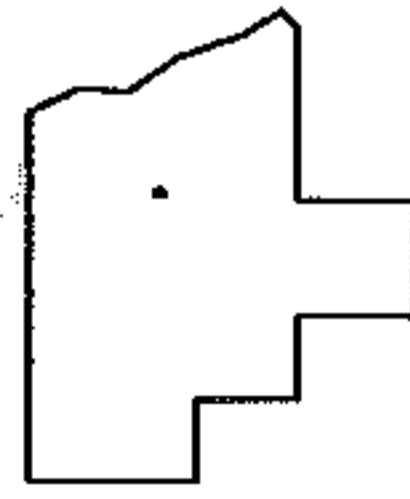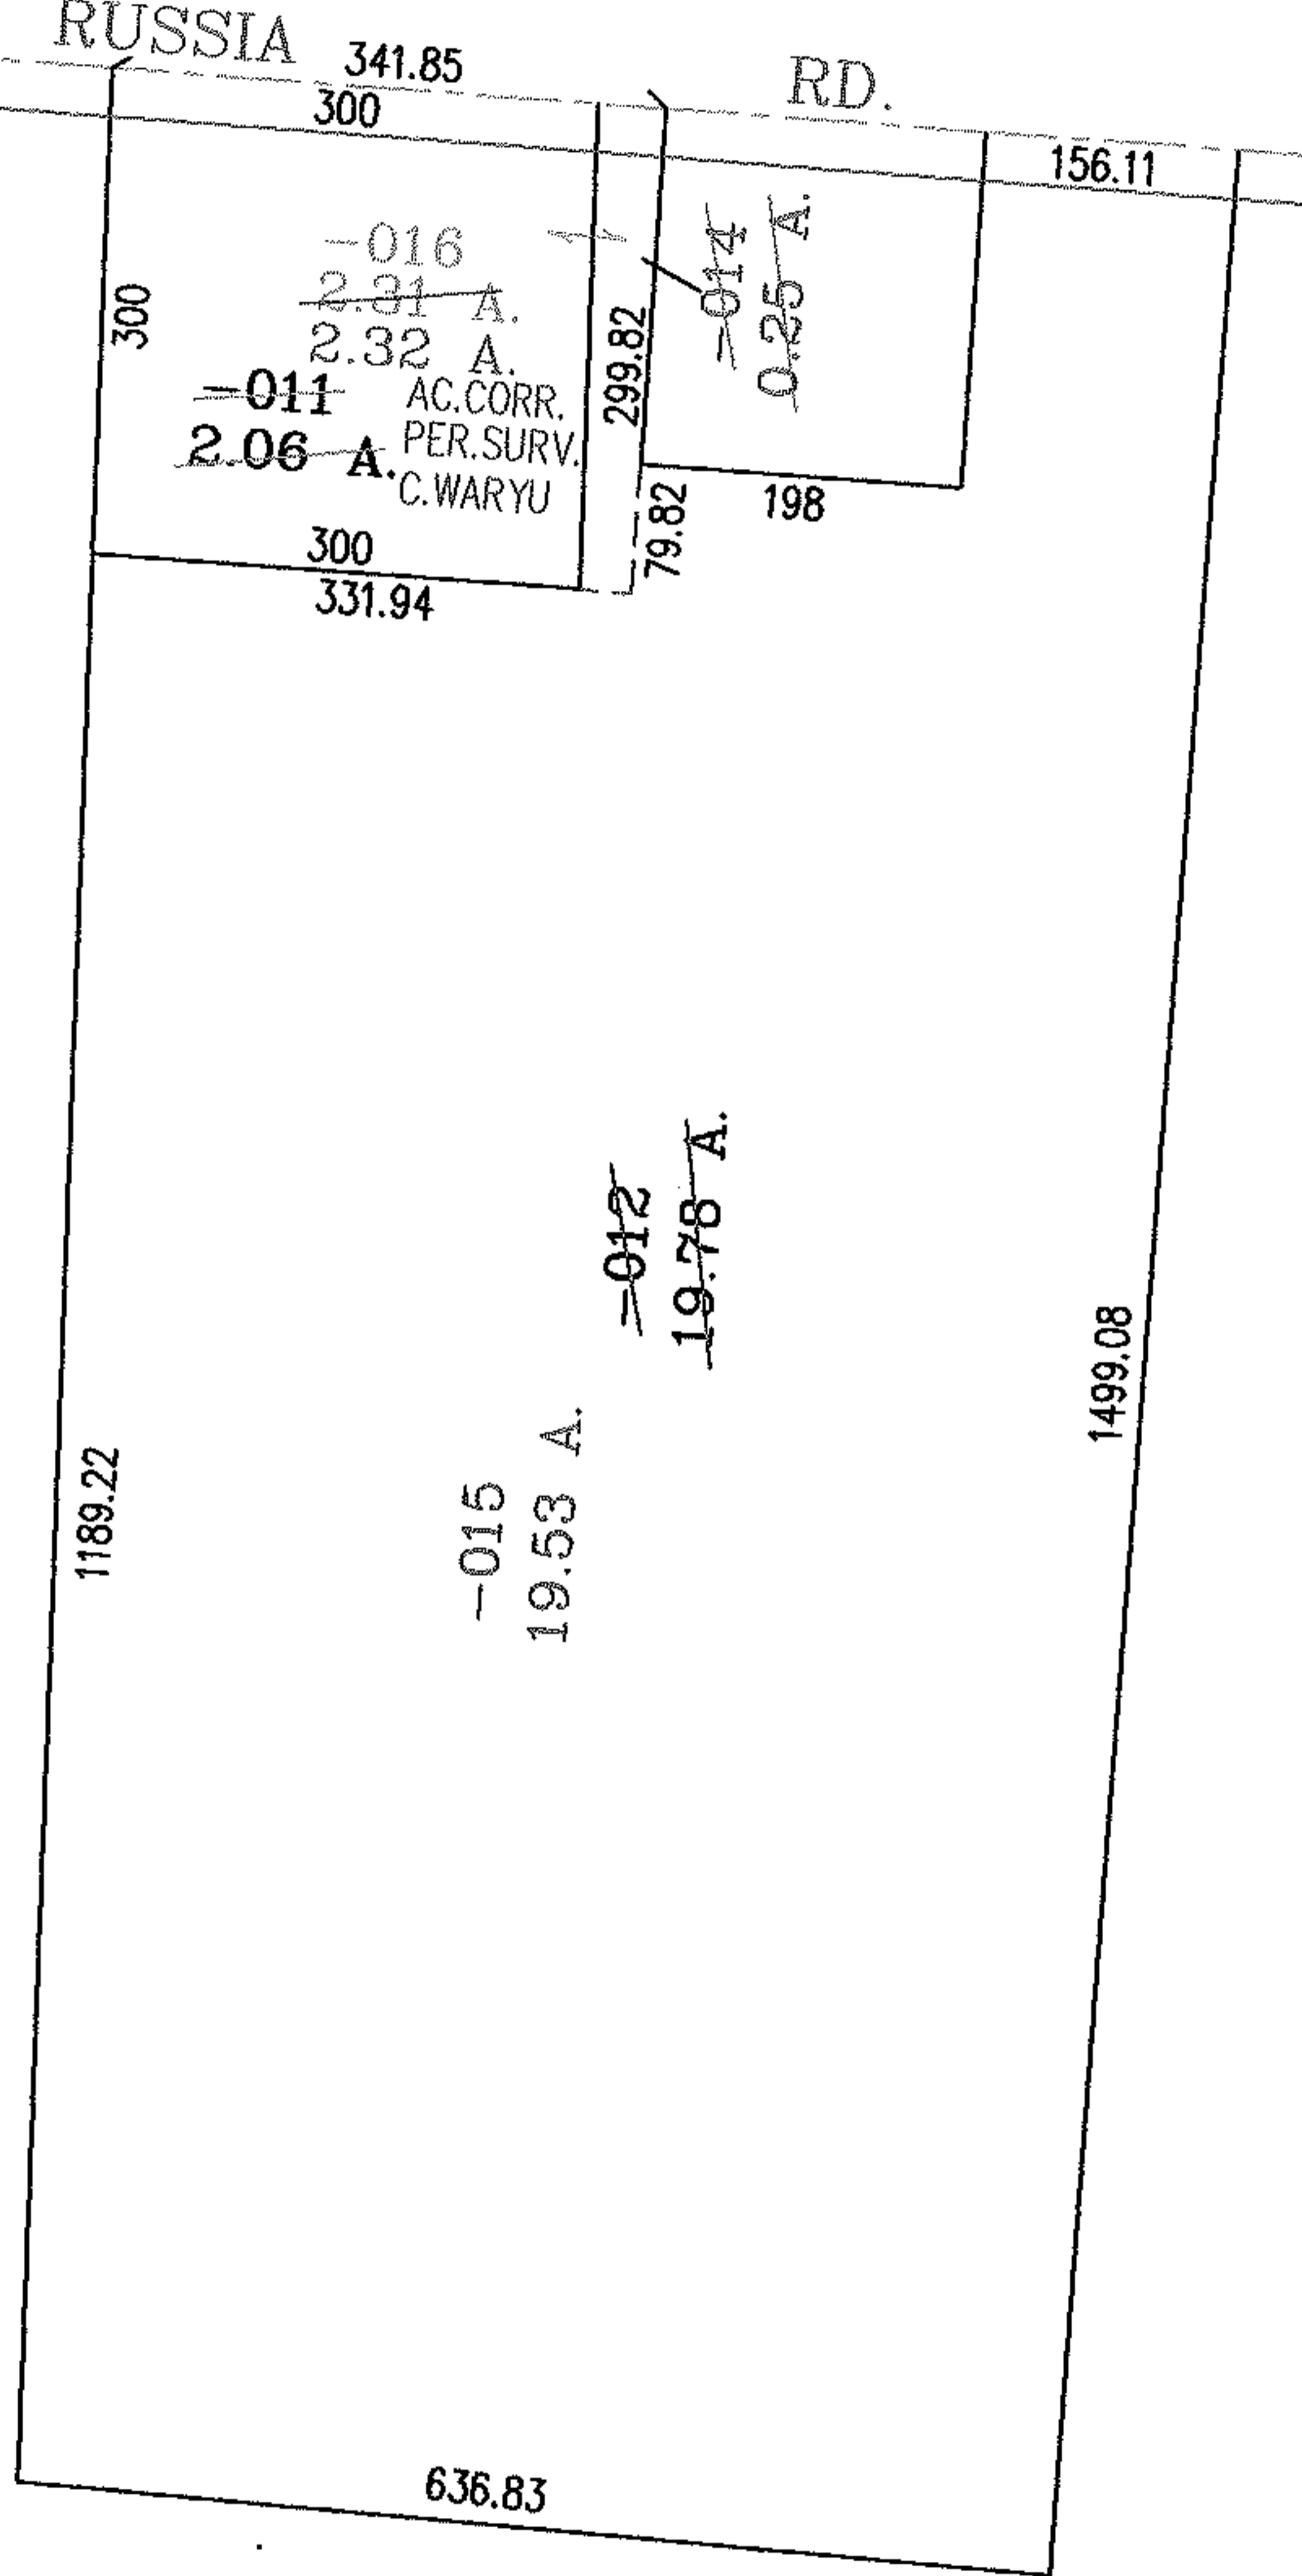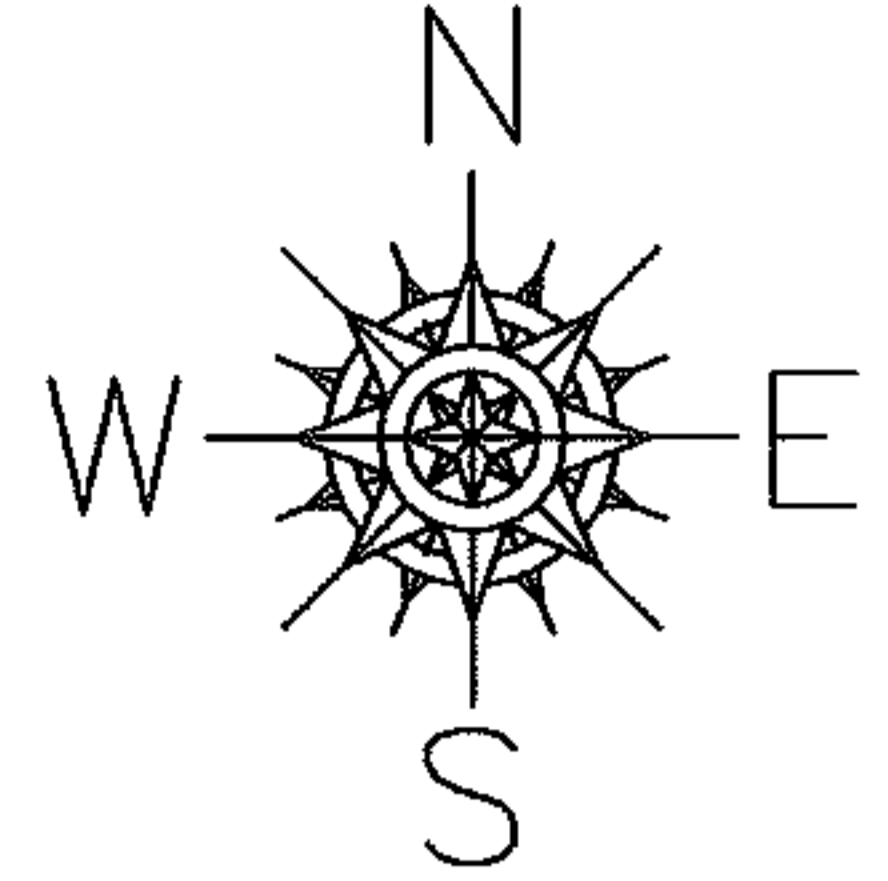

**SPLITS/DEEDS PROCESSED**  
LORAIN COUNTY TAX MAP DEPARTMENT  
226 MIDDLE AVE. ELYRIA, OHIO

SURVEYED BY: C. WARYU/ C. HIRZEL  
CLOSURE: .00:10.000  
MAP PAGE(S): 08-00-104-A  
APPROVED BY: RRM DATE: 5-27-05  
SCALE: 1"= 200 PRIOR INSTRUMENT: 20040020998