

RASTER



PARENT PARCEL: 14-00-146-000-001, 14-00-147-000-011

09-01900-C

CHILD PARCEL: -SAME--

STARTING POINT: INT CL MERRIAM RD AND PITTS RD


AC. CORR  
PER SURVEY  
TIMOTHY J. BRIGGS

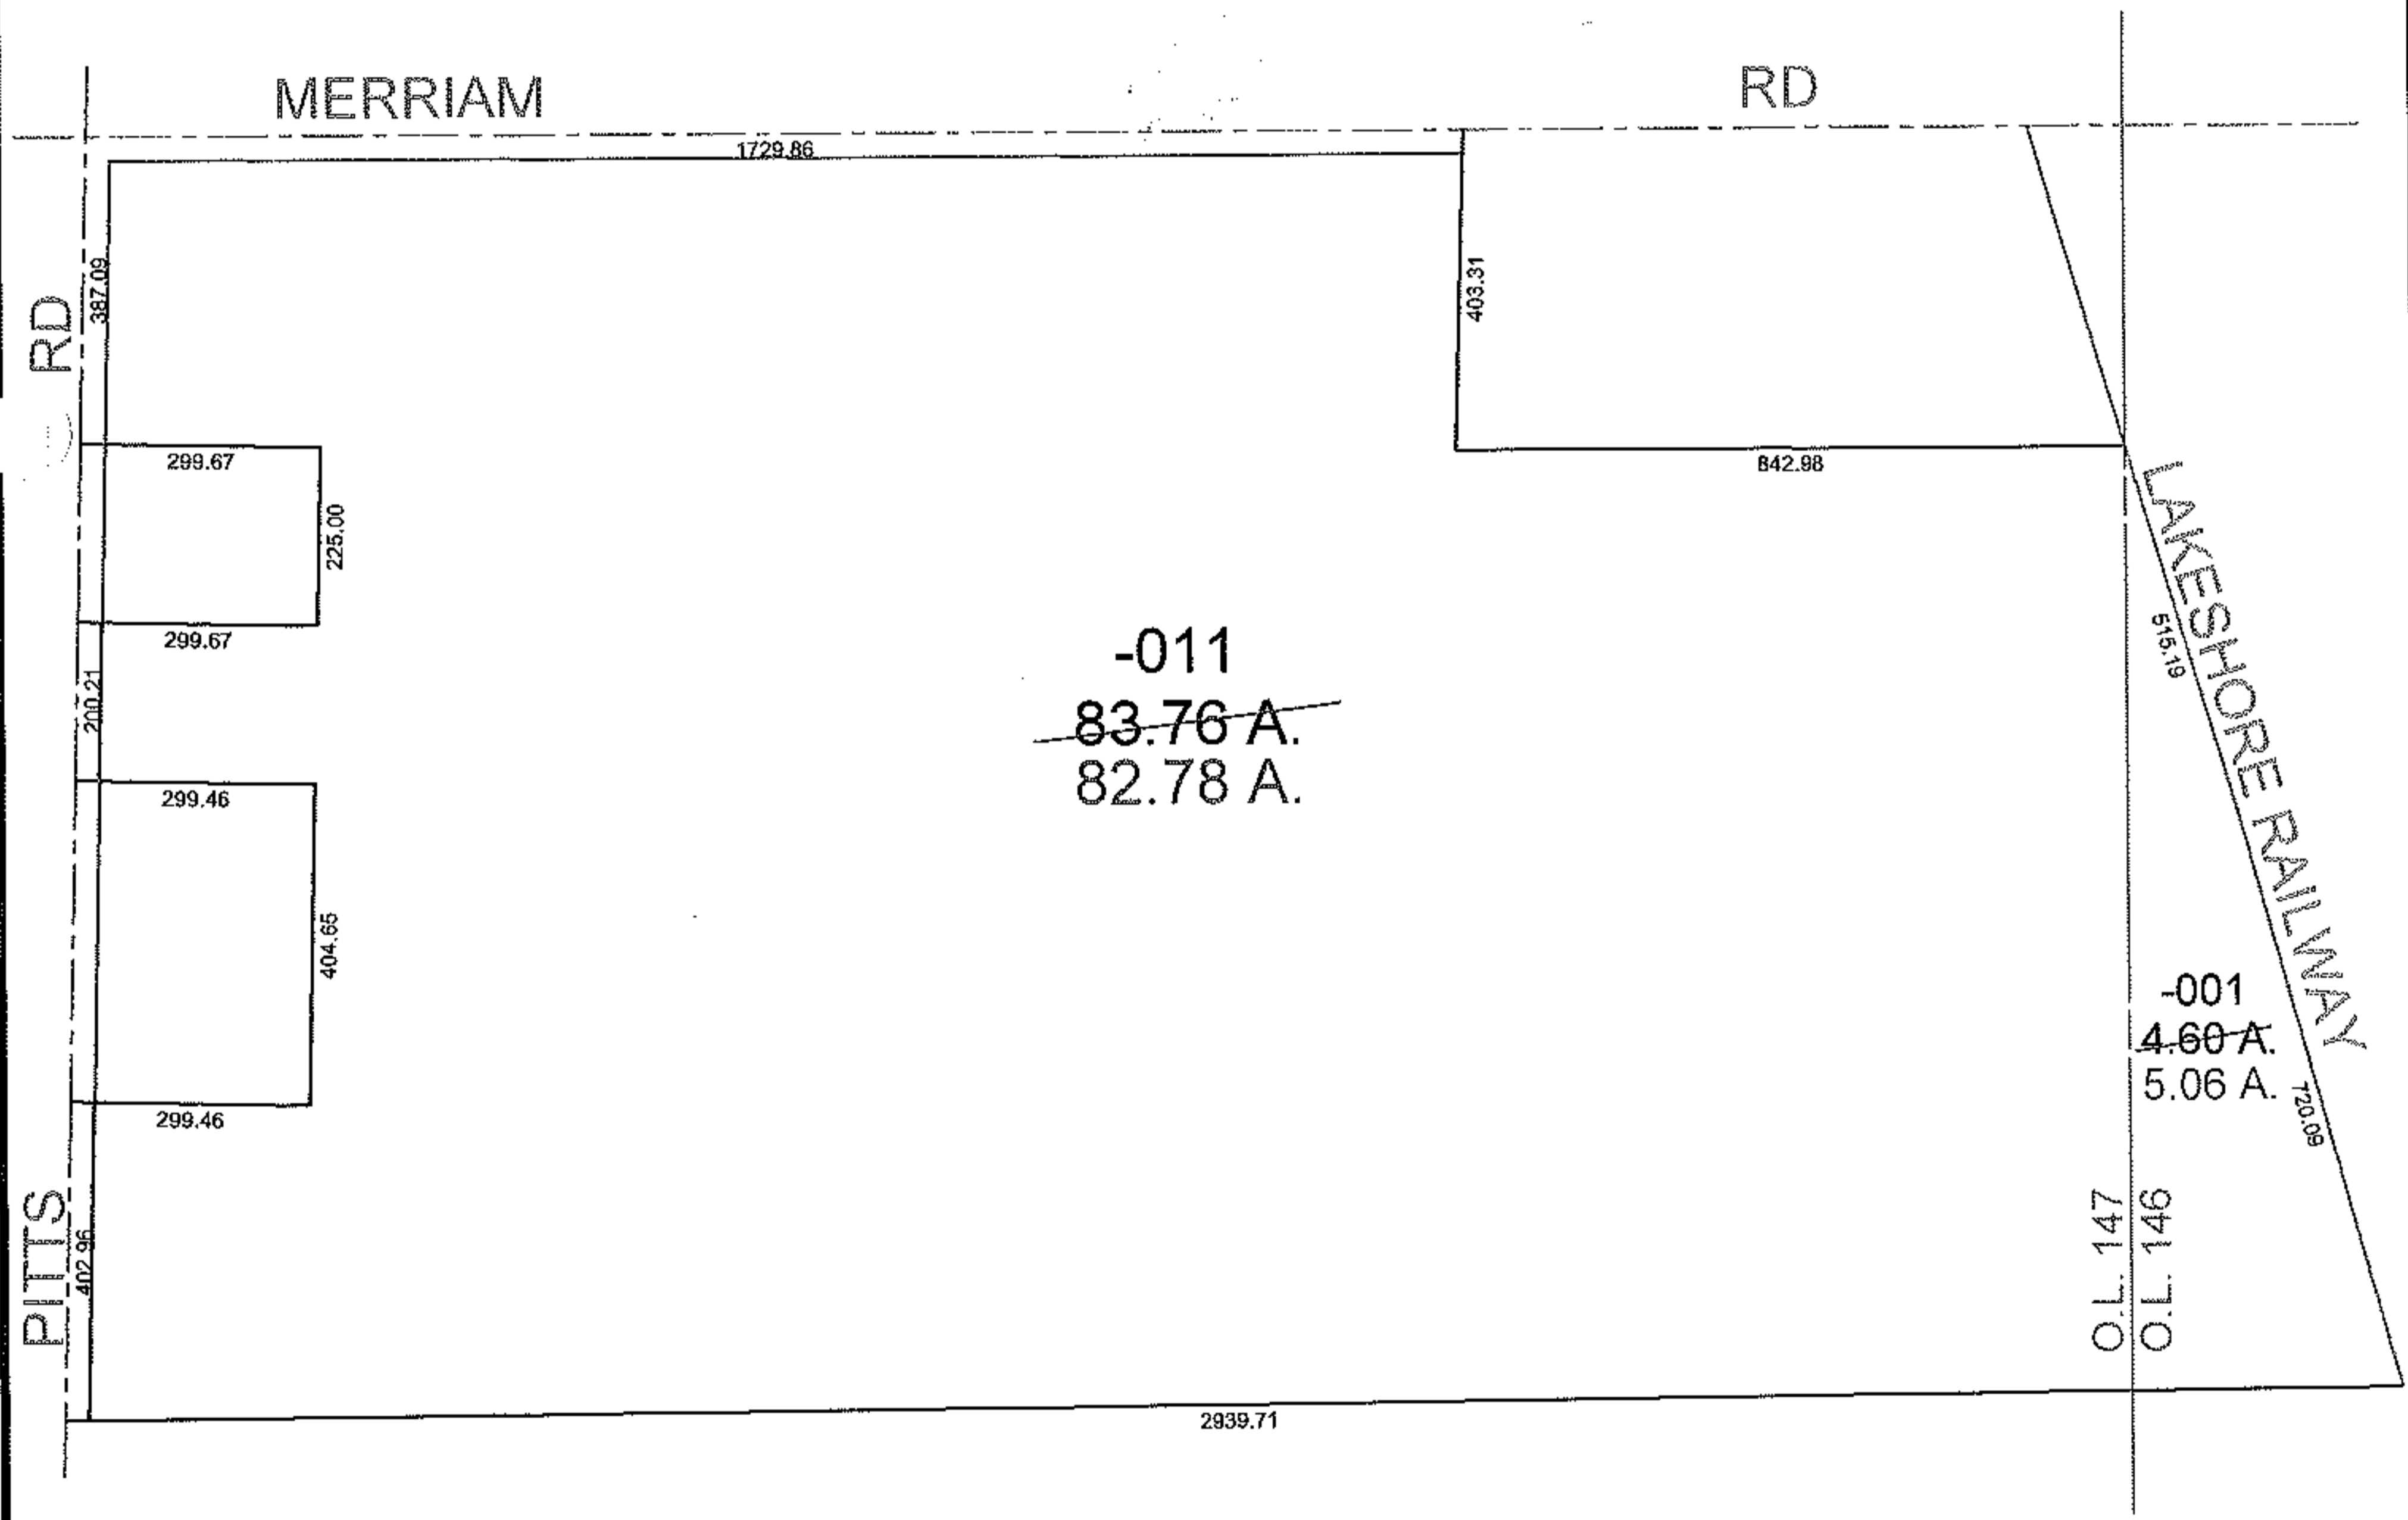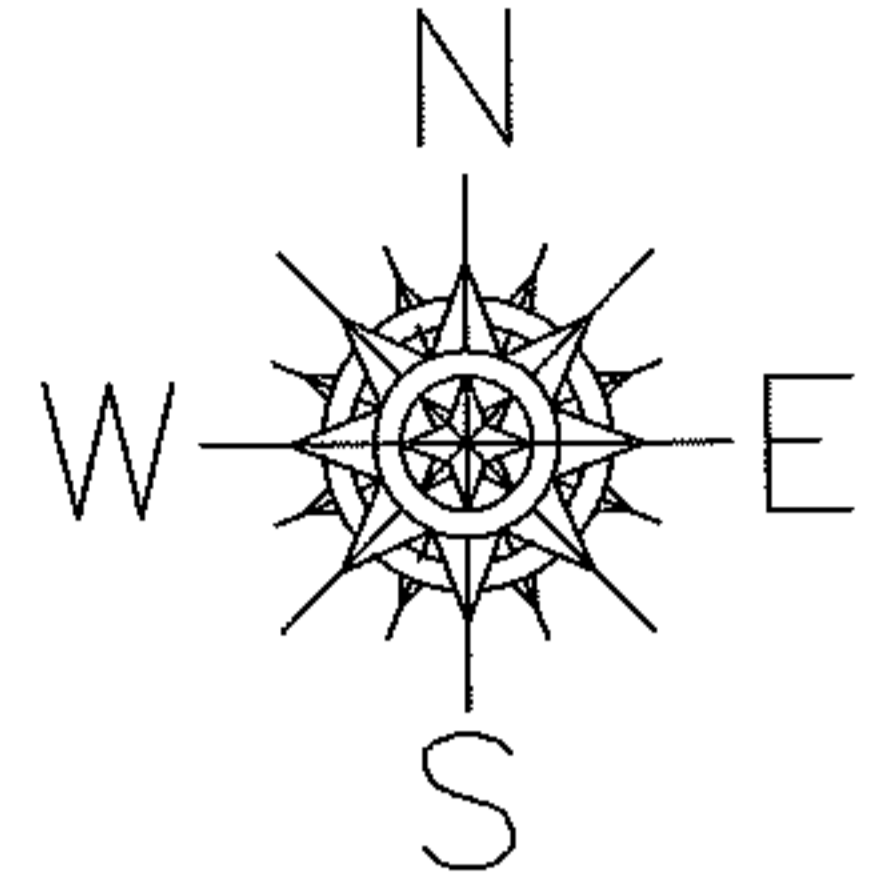

-011  
~~83.76 A.~~  
82.78 A.

-001  
~~4.60 A.~~  
5.06 A.

O.L. 147  
O.L. 146

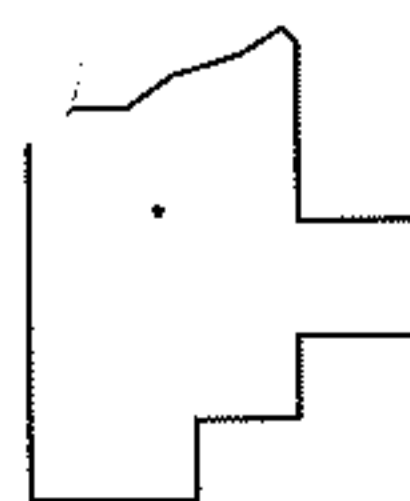

SPLITS/DEEDS PROCESSED  
LORAIN COUNTY TAX MAP DEPARTMENT  
226 MIDDLE AVE. ELYRIA, OHIO

SURVEYED BY: TIMOTHY J. BRIGGS  
CLOSURE: 1:10,000  
MAP PAGE(S): 14-F  
APPROVED BY: DRH DATE: 10/12/2009  
SCALE: 1" = 400' PRIOR INSTRUMENT: 521/273