




RASTER

PARENT PARCEL: 06-23-003-102-056, 06-23-005-103-009, -010

CHILD PARCEL: 06-23-003-102-064, -065 06-23-005-103-020

STARTING POINT: CENTERLINE OF DELLEFIELD RD. & MURRAY RIDGE RD.

NO. 01903

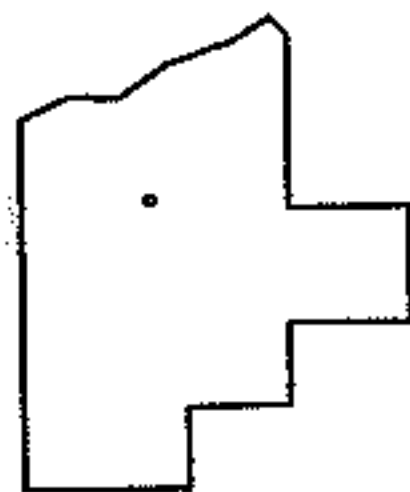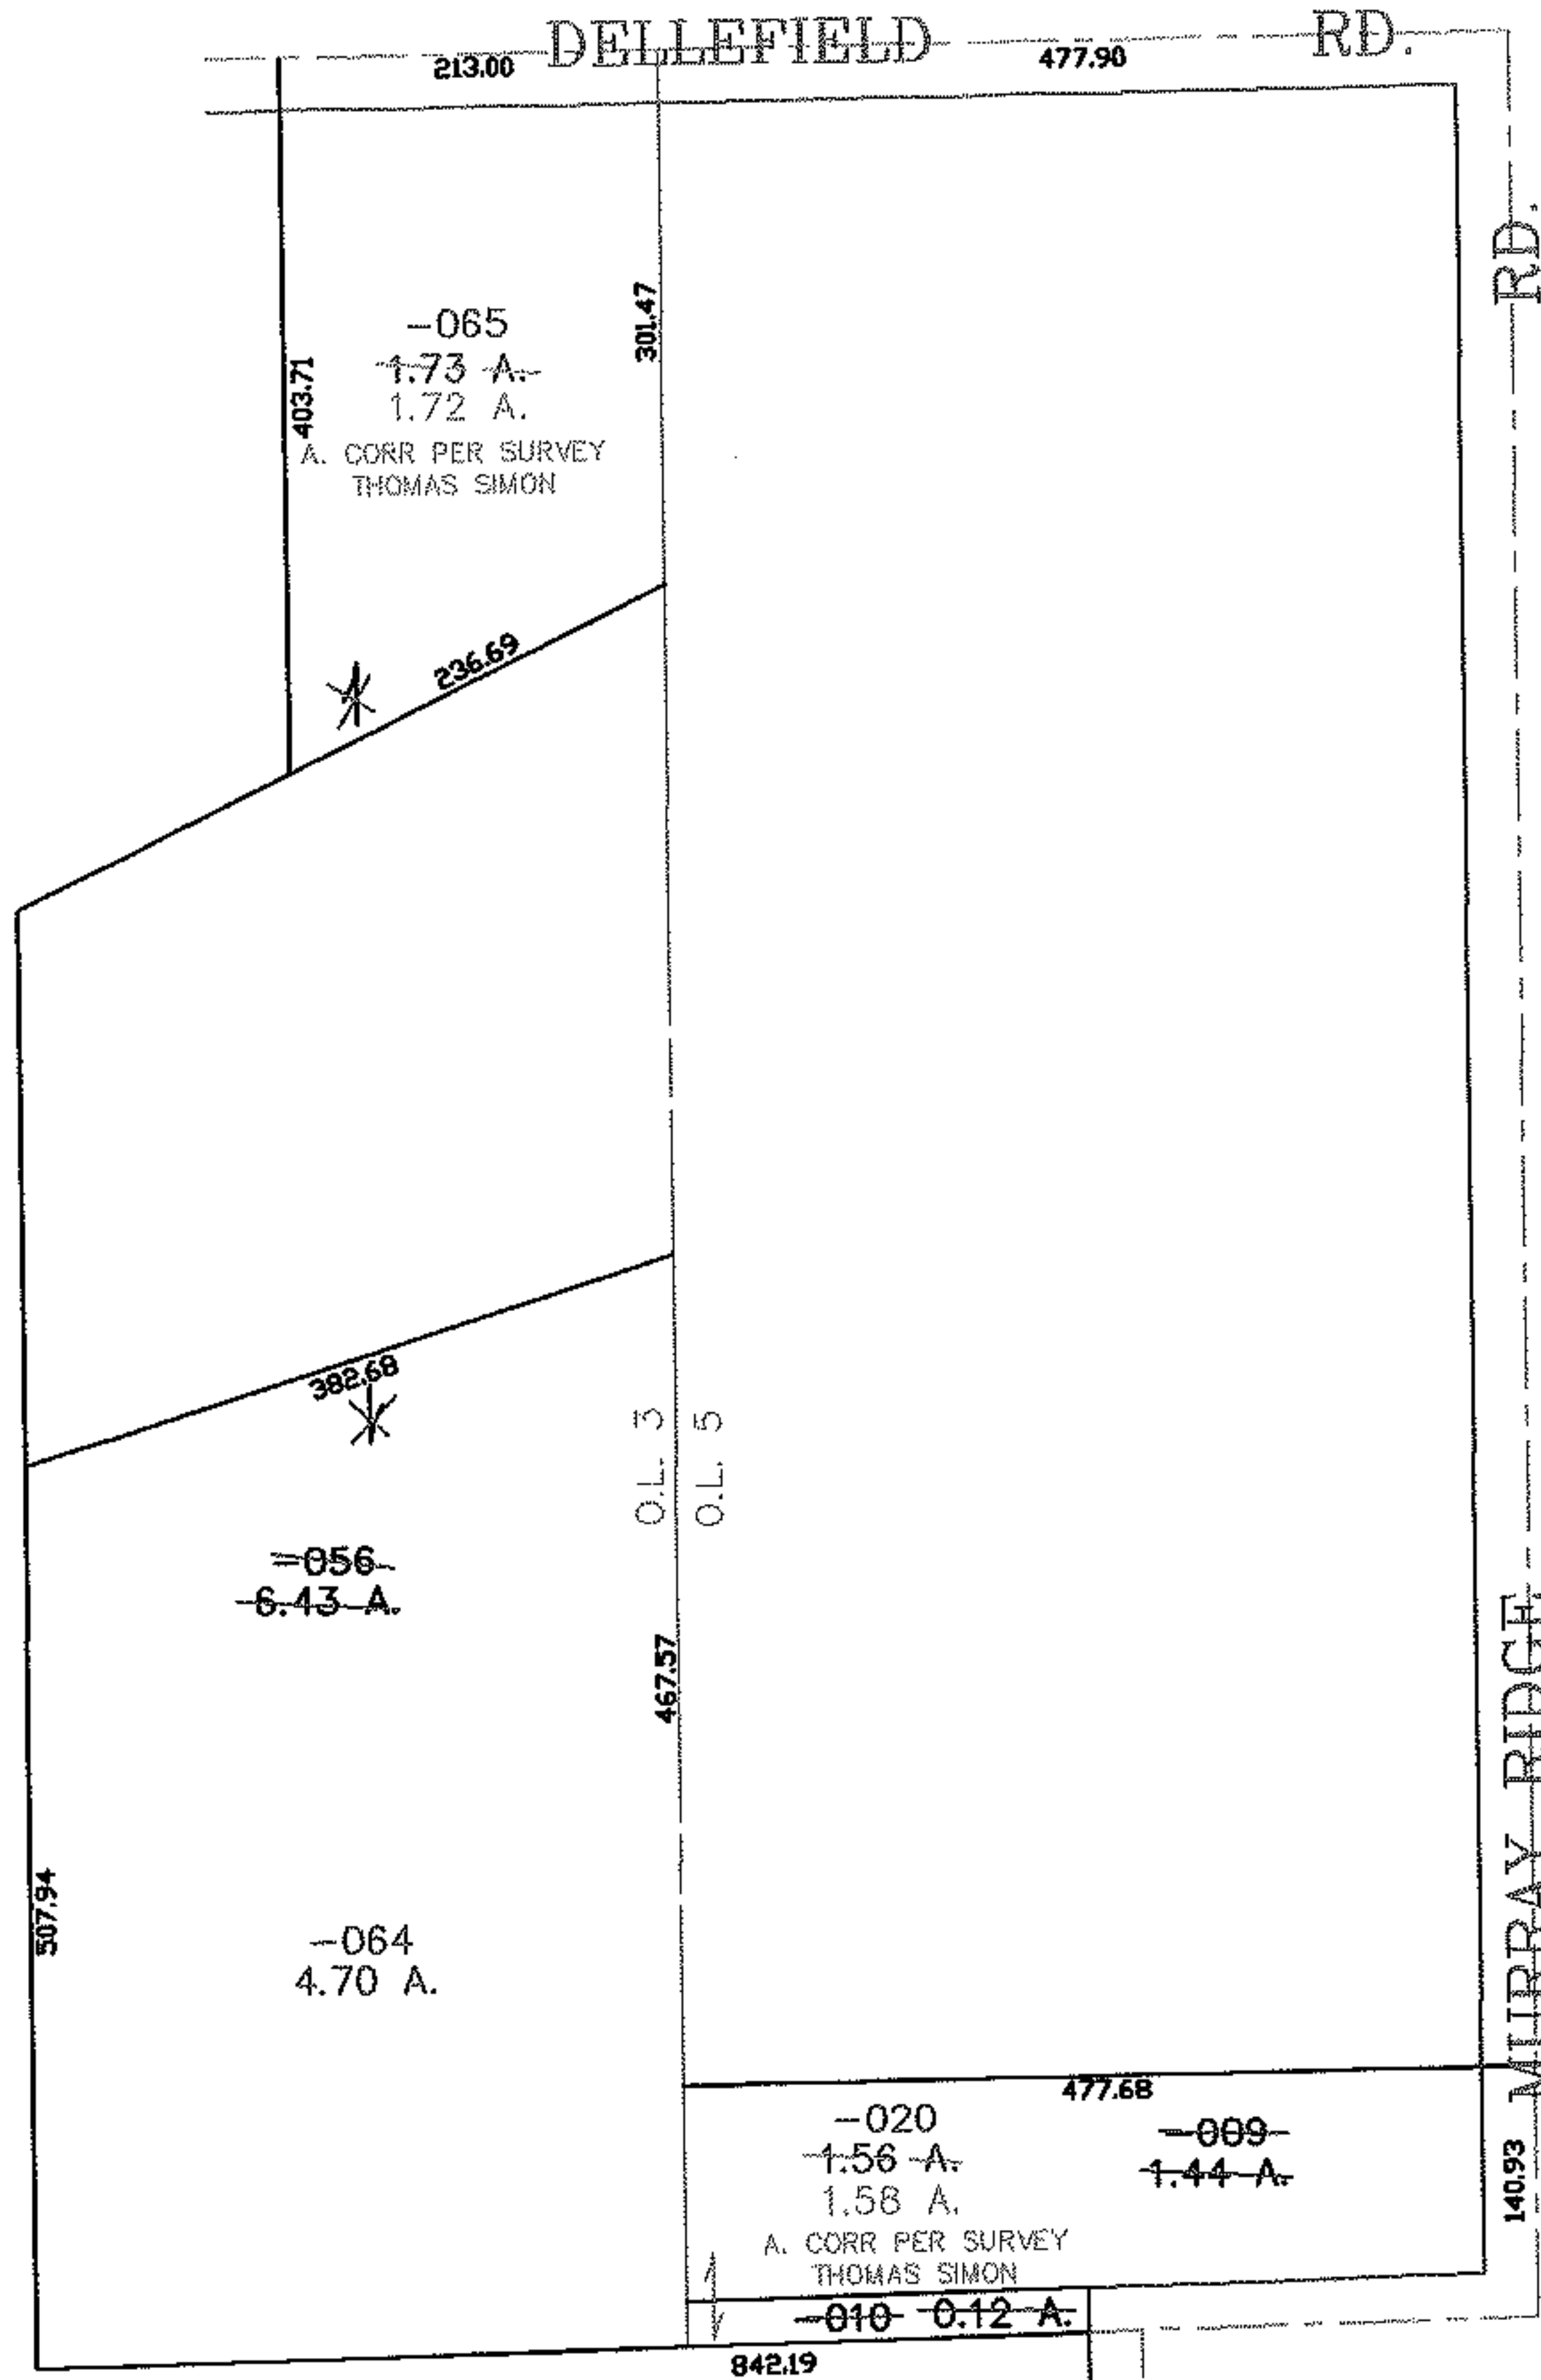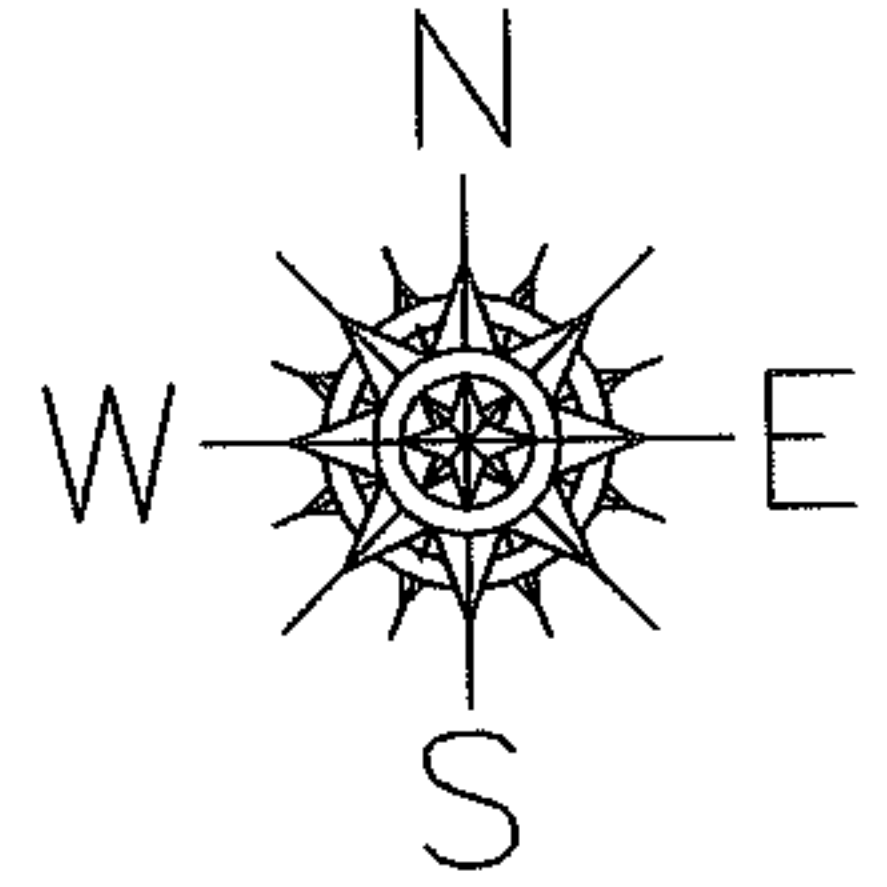

SPLITS/DEEDS PROCESSED
 LORAIN COUNTY TAX MAP DEPARTMENT
 226 MIDDLE AVE. ELYRIA, OHIO

SURVEYED BY: THOMAS SIMON
 CLOSURE: 0.00 : 10.000
 MAP PAGE(S): 6-21
 APPROVED BY: JAH DATE: 04-28-05
 SCALE: 1" = 200 PRIOR INSTRUMENT: DV 908/341