


RASTER

PARENT PARCEL: 03-00-057-112-008

CHILD PARCEL: 03-00-057-112-022

09-01904-C

STARTING POINT: A POINT ON SOUTH R.O.W. LINE OF COLORADO AVE. 361.14 FT FROM ITS INT OF WEST R.O.W. LINE OF ROOT RD.

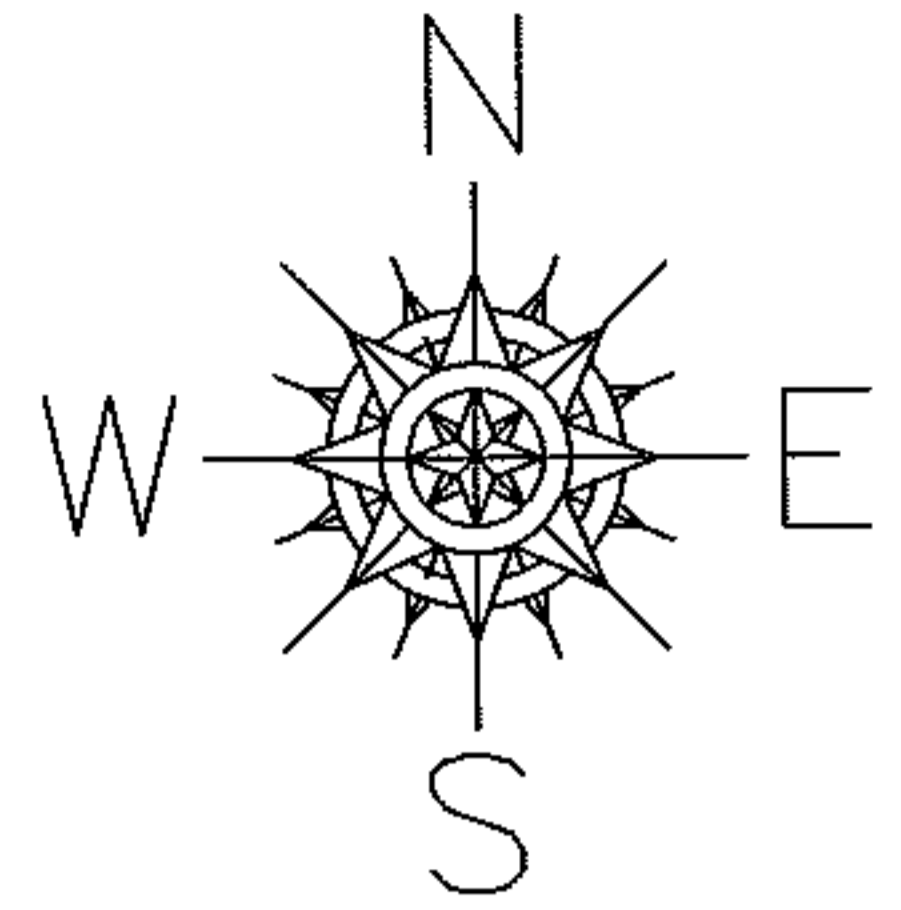

COLORADO AVE. (S.R. 611)

361.14

~~-008~~  
0.19 A.

L=568.50  
R=1116.28

39.44

COLORADO AVE. (S.R. 611)

L=84.39  
R=146.28

900

~~-005~~  
0.40 A.

L=48.62  
R=116.28

DROP FROM DUP.

03-00-057-112-008  
0.19 A.

ADD TO DUP.

03-00-057-112-022  
0.18 A.

SHOULD OF BEEN A REMAINDER  
OF SPLIT #09-02741

ROOT ROAD

189.80

109.80

40.00

900

~~-001~~  
0.47 A.

307.55

-024  
2.05 A.

69.94

COLORADO AVE. (S.R. 611)

158.60


175.35

34.36

238.40

24.00

290.00

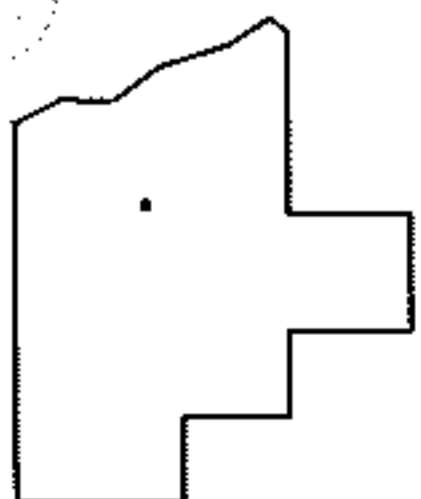

SPLITS/DEEDS PROCESSED

LORAIN COUNTY TAX MAP DEPARTMENT  
226 MIDDLE AVE. ELYRIA, OHIO

SURVEYED BY: \_\_\_\_\_  
CLOSURE: N/A  
MAP PAGE(S): 03-00-057-A  
APPROVED BY: RRM DATE: 10-16-09  
SCALE: 1" = 100 PRIOR INST.: DV 306/505