




PARENT PARCEL: 11-00-036-112-018

CHILD PARCEL: --SAME--

09-01905-C

STARTING POINT: INT CL EAST RD AND ALTON DR

FRONTAGE CORR PER DEEDS

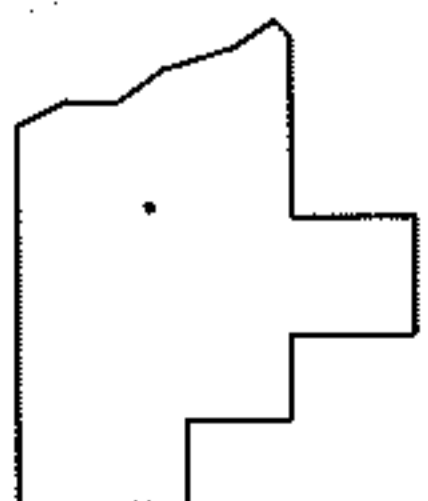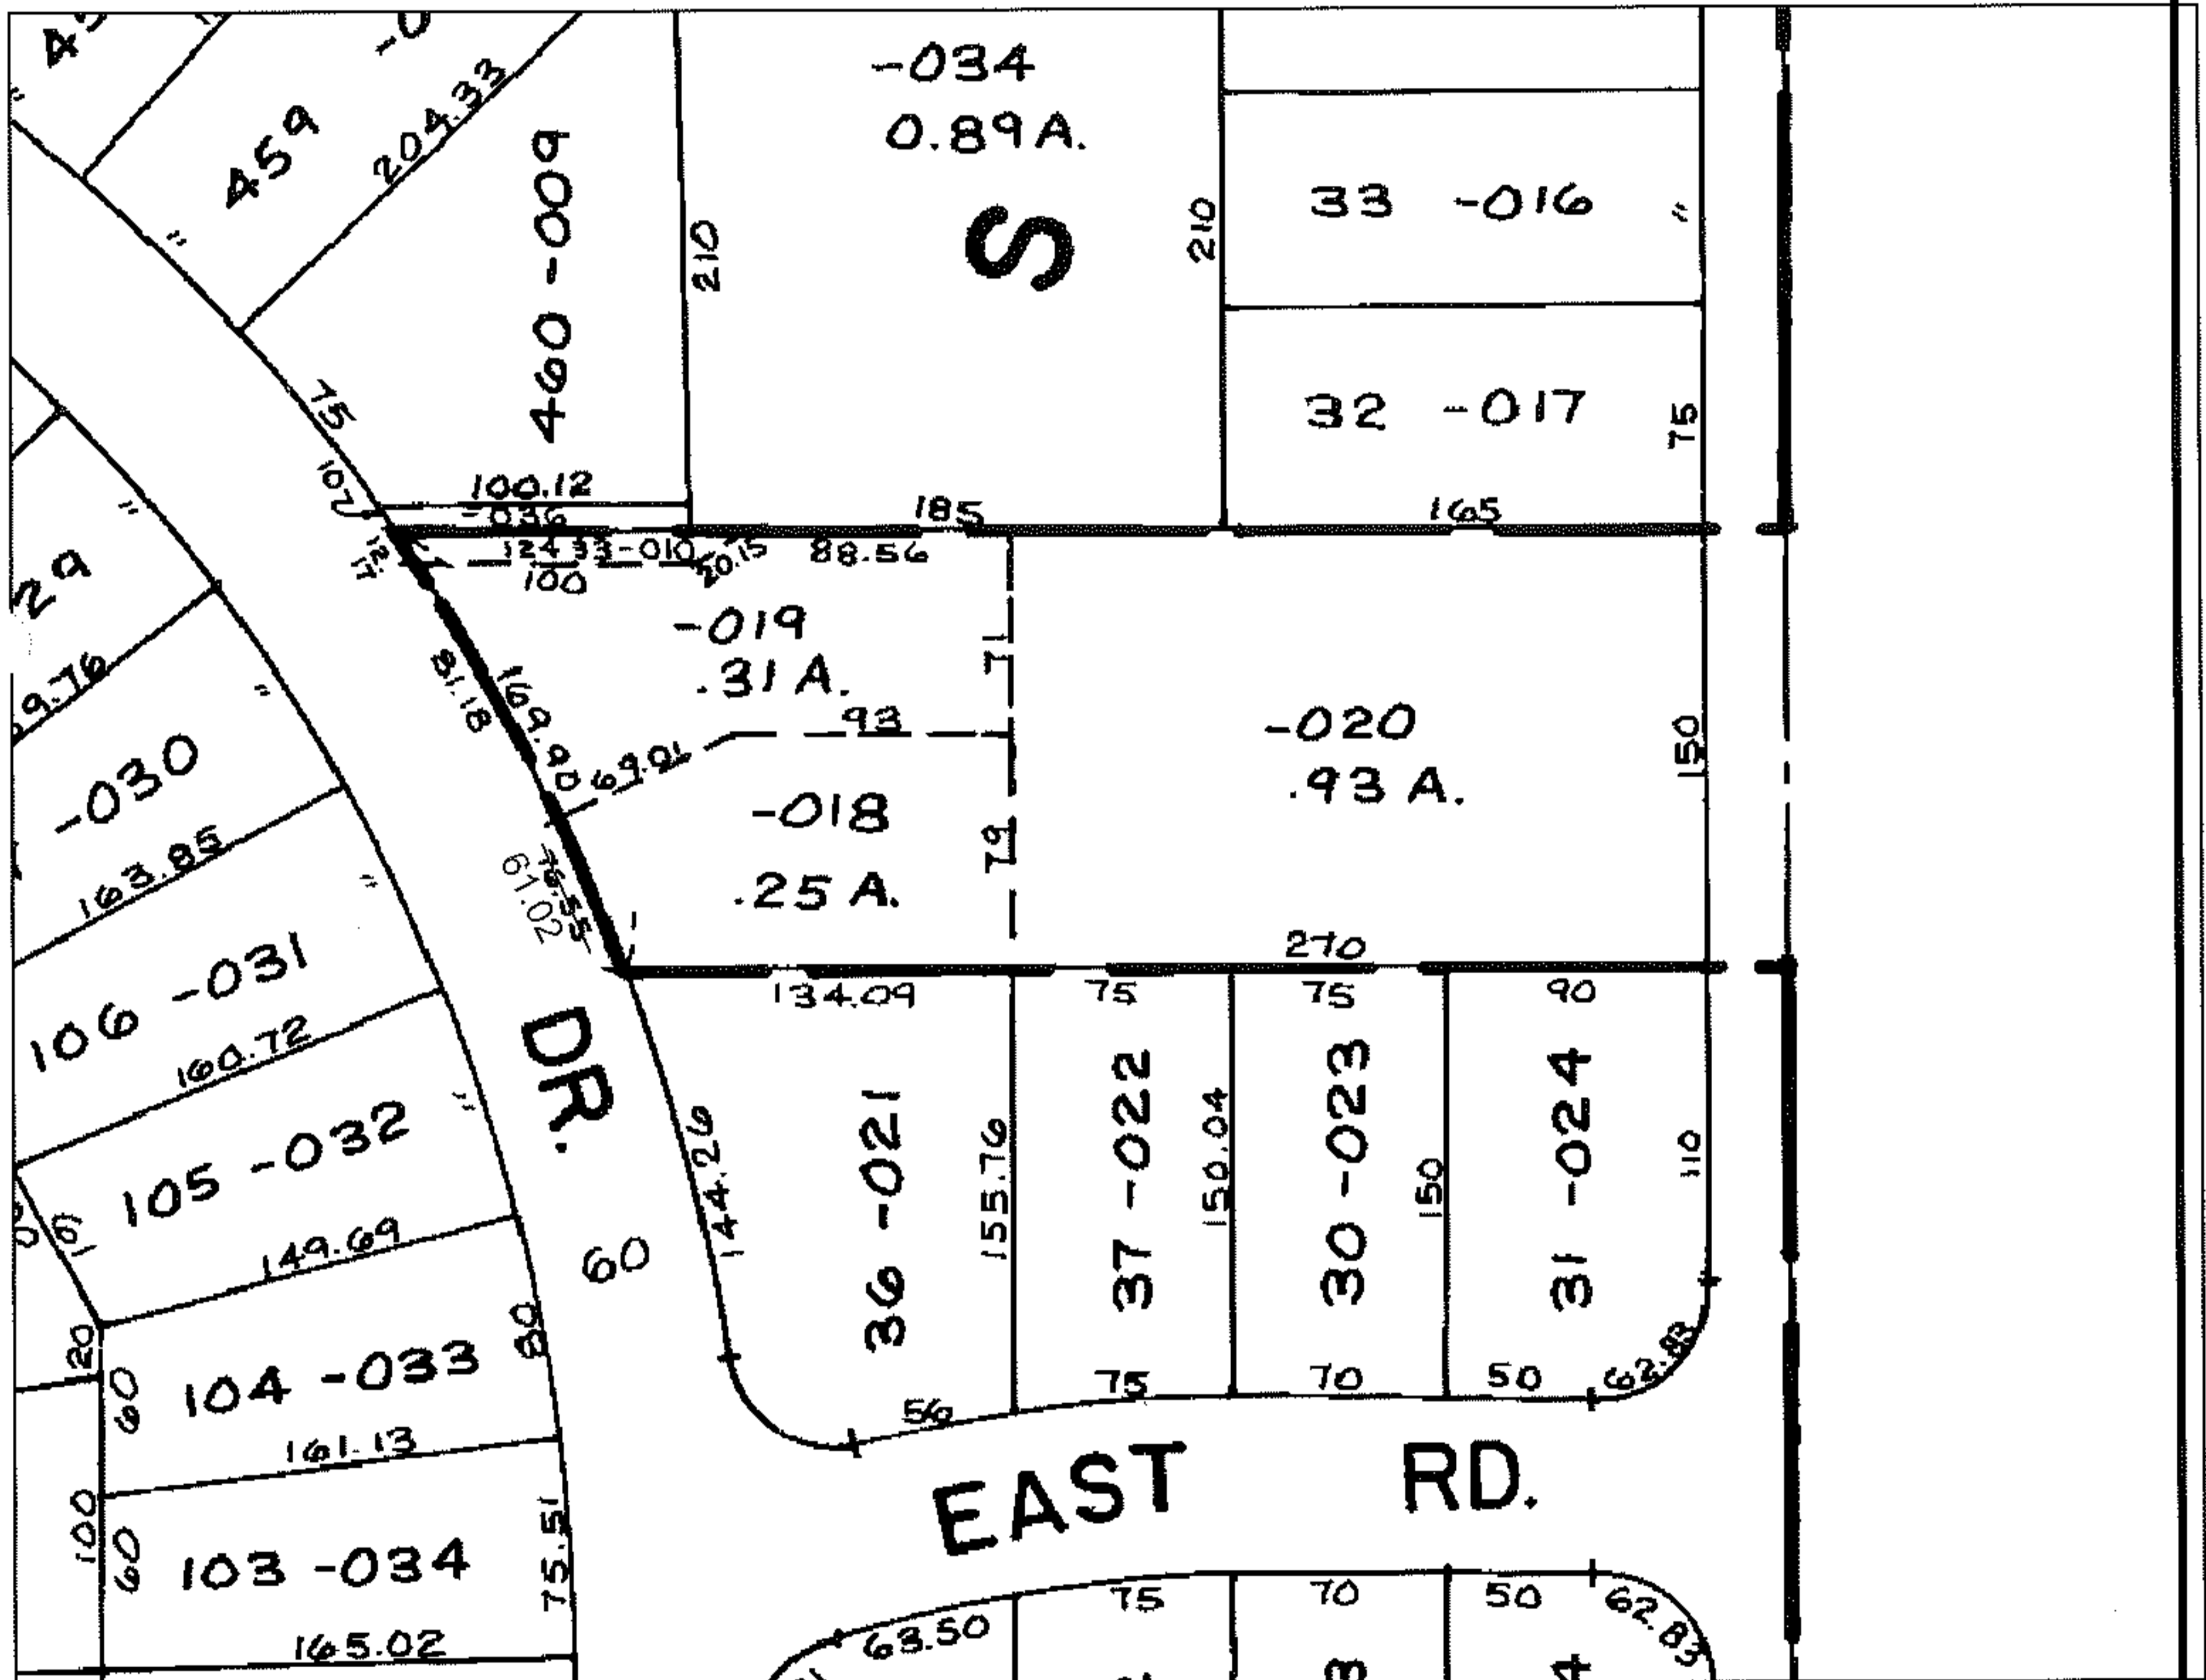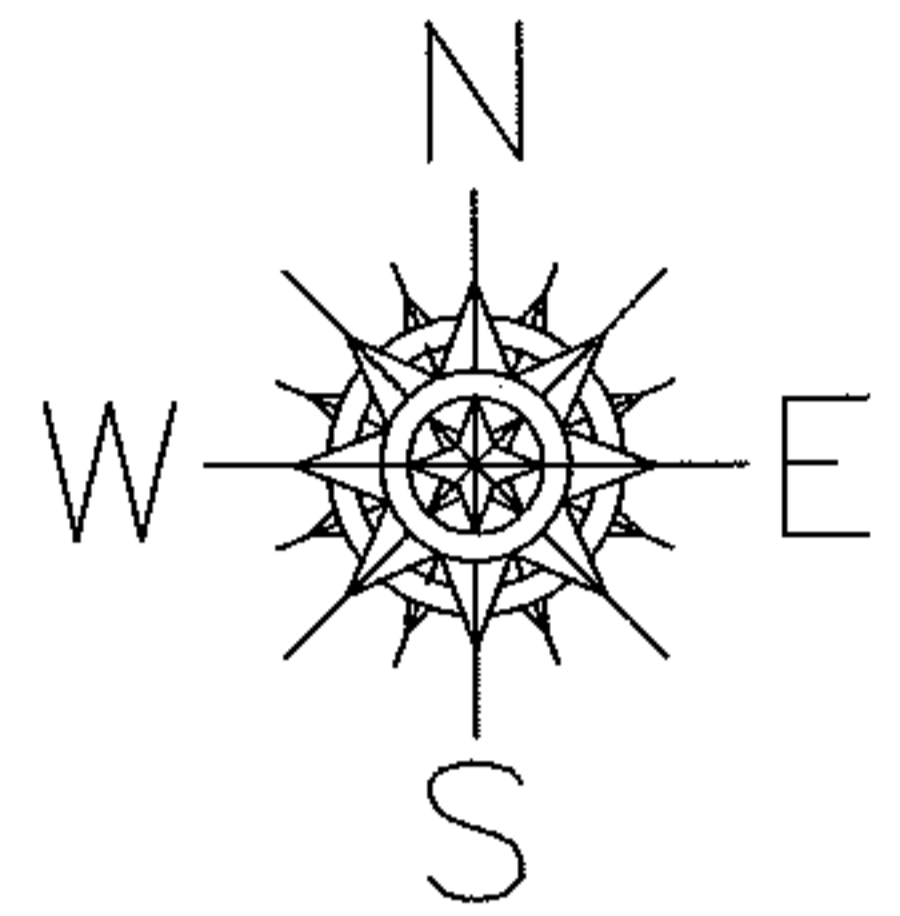

SPLITS/DEEDS PROCESSED

LORAIN COUNTY TAX MAP DEPARTMENT
226 MIDDLE AVE. ELYRIA, OHIO

SURVEYED BY: N/A
 CLOSURE: N/A
 MAP PAGE(S): 11-00-036-B
 APPROVED BY: DRH DATE: 10/20/2009
 SCALE: NOT TO SCALE PRIOR INST.: 523/822