


RASTER

PARENT PARCEL: 16-00-079-000-002

CHILD PARCEL: 16-00-079-000-048, -049

STARTING POINT: CENTERLINE OF LAW RD. & CHAMBERLAIN RD.

NO. 01905

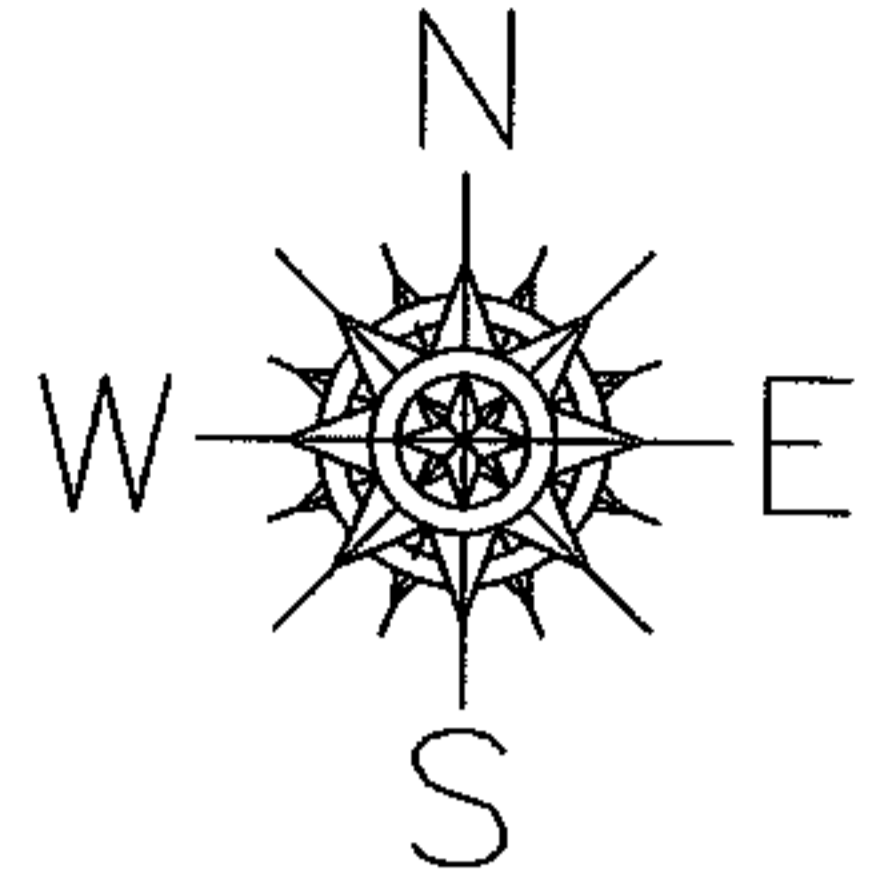

CHAMBERLAIN RD.

LAW

RD.

373.80

250.00

395.85

395.85

395.85

~~-002~~  
~~5.67 A.~~  
-049  
3.40 A.

-048  
2.27 A.

373.80

250.00

SPLITS/DEEDS PROCESSED

LORAIN COUNTY TAX MAP DEPARTMENT  
226 MIDDLE AVE. ELYRIA, OHIO

SURVEYED BY: THOMAS NEFF JR.

CLOSURE: 0.00 : 10.000

MAP PAGE(S): 16-00-079-A

APPROVED BY: JAH DATE: 5-3-05

SCALE: 1" = 100 PRIOR INSTRUMENT: DV 1402/892