


05-01906

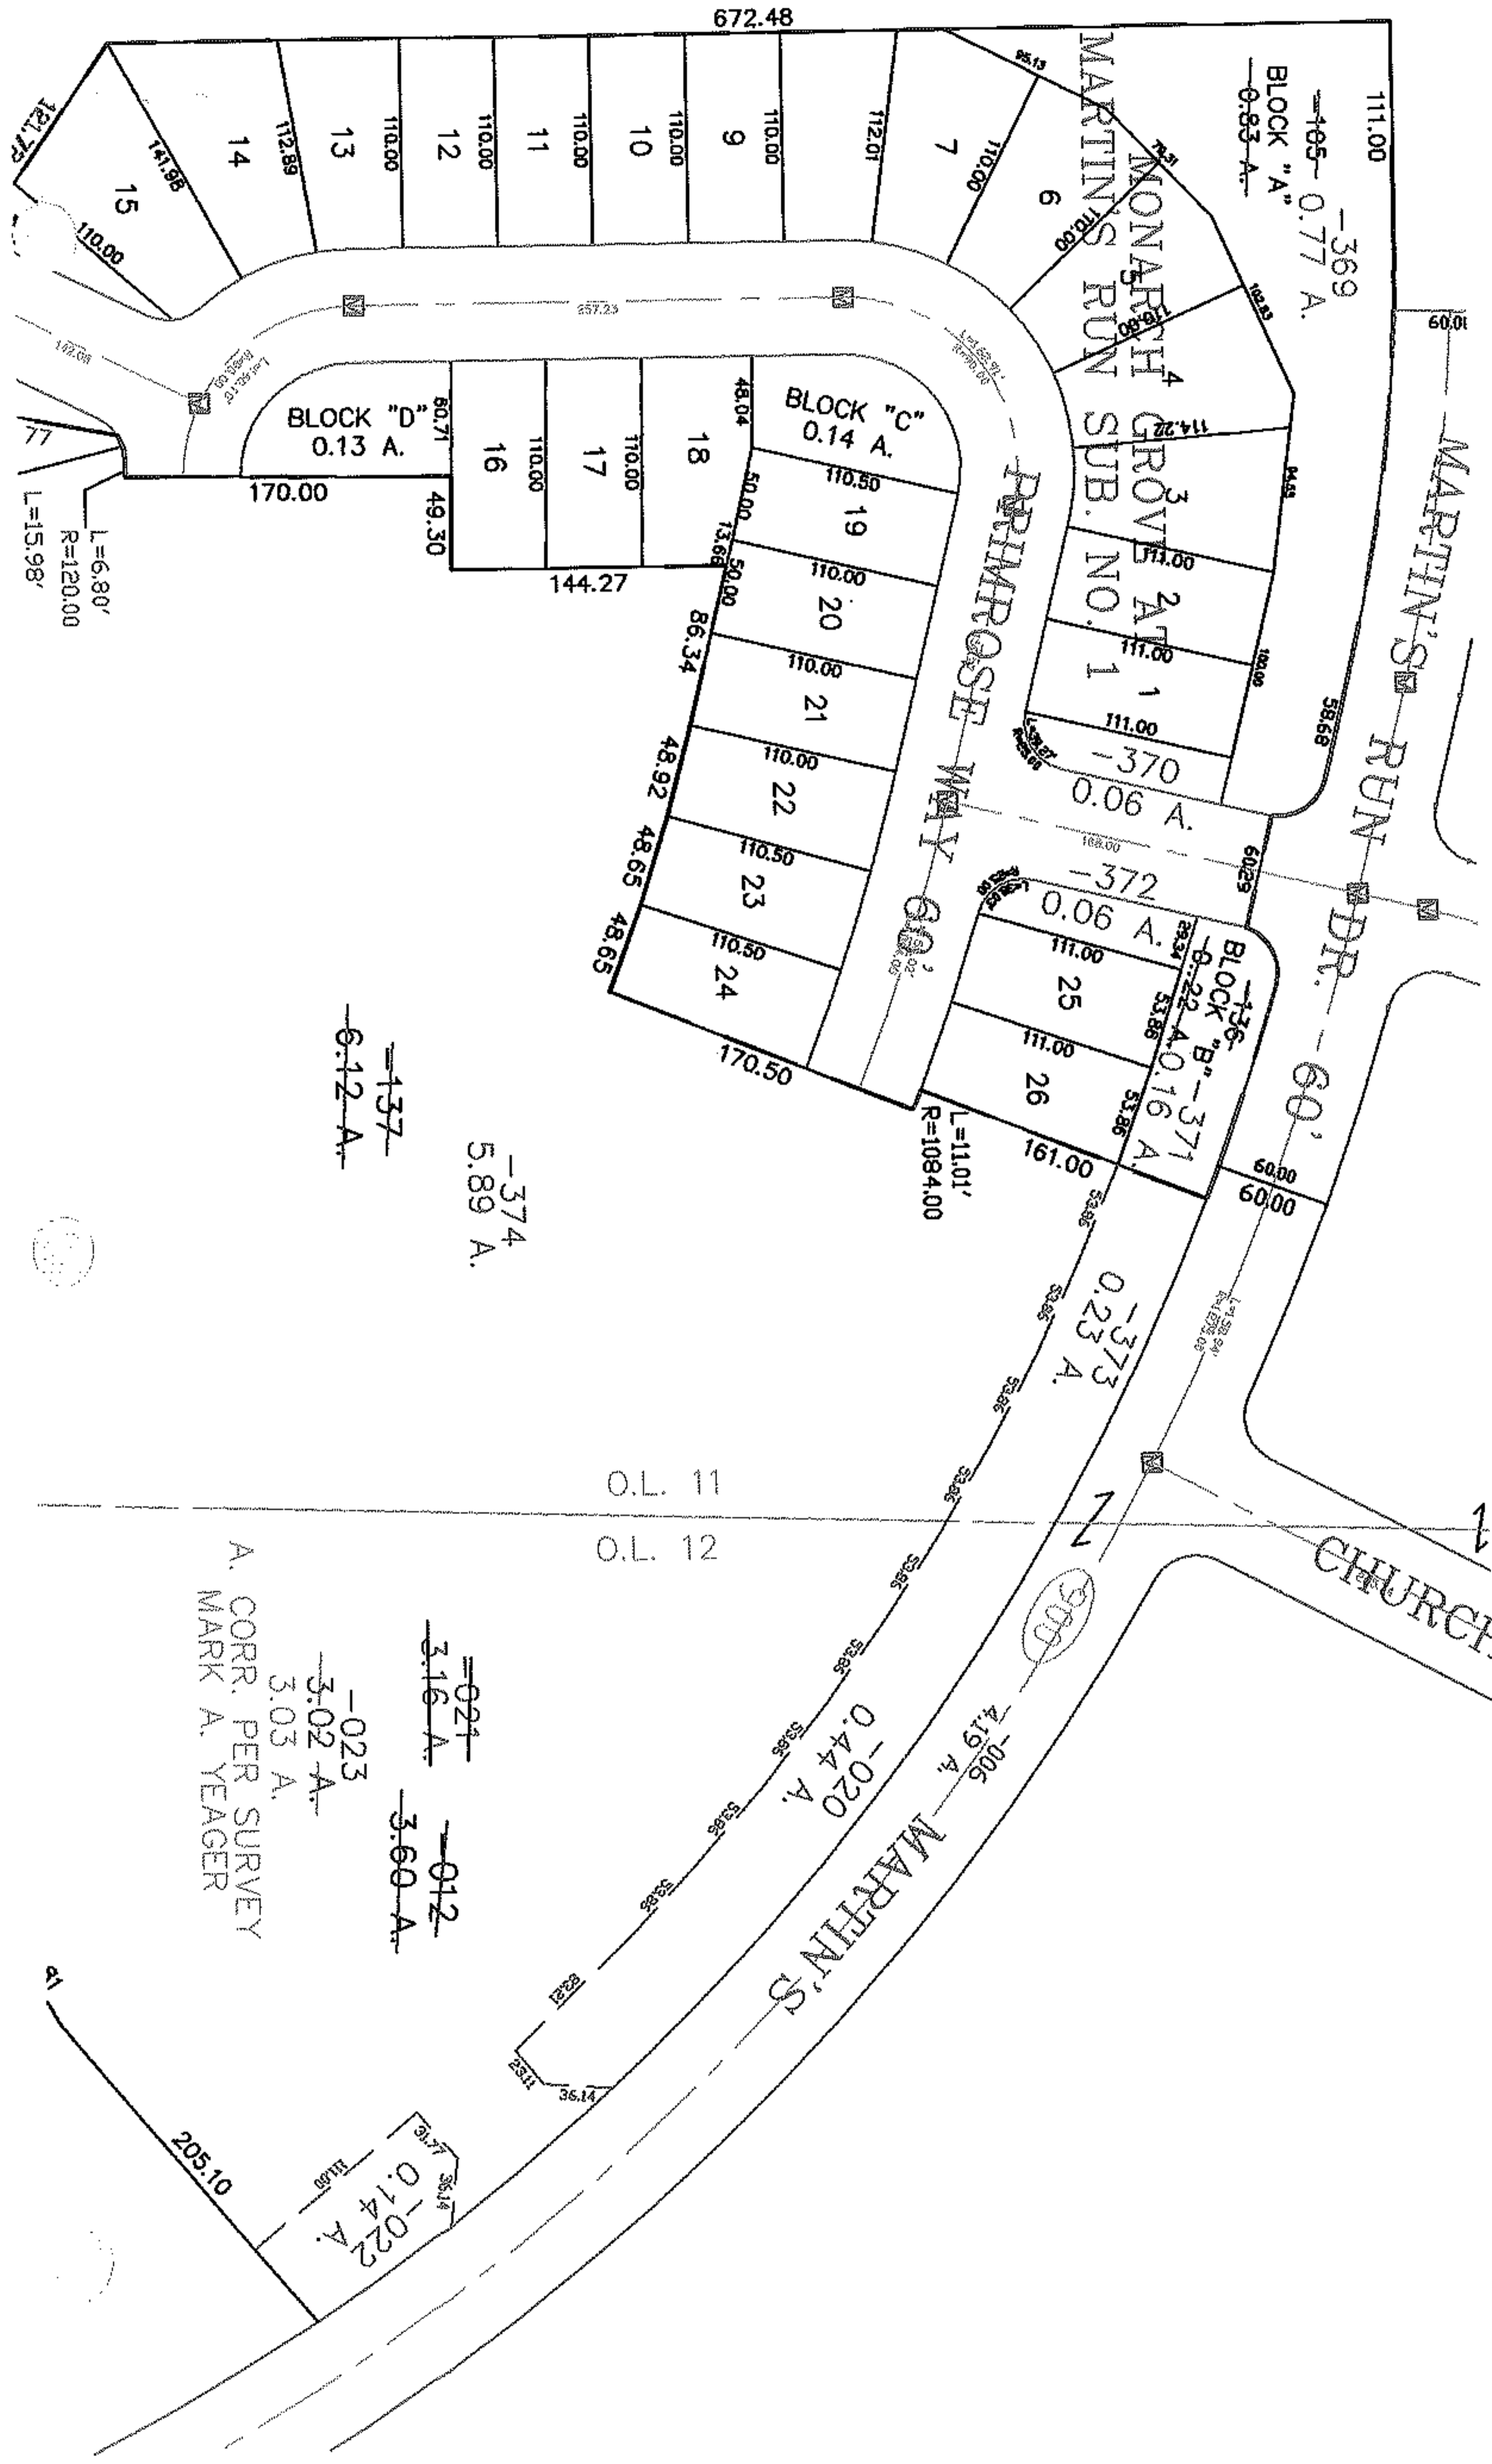

~~021~~ ~~012~~
~~3.16 A.~~ ~~3.60 A.~~
~~023~~ ~~012~~
~~3.02 A.~~ ~~3.03 A.~~
 A. CORR. PER SURVEY
 MARK A. YEAGER

O.L. 11
 O.L. 12

0.14 A.
 0.14 A.

~~137~~
~~6.12 A.~~
 -374
 5.89 A.

L=11.01'
 R=1084.00

L=6.80'
 R=120.00
 L=15.98'

672.48

111.00

~~105~~ - 0.77 A.
 BLOCK "A"
~~0.83 A.~~

MARTIN'S RUN DR. 60'

60.00

CHURCH

MONARCH GROVE
 SUB. NO. 1

PRIMROSE WAY 60'

MARTIN'S RUN

0.44 A.

4.19 A.

0.23 A.

BLOCK "B"
 0.16 A.

BLOCK "C"
 0.14 A.

BLOCK "D"
 0.13 A.

15
 14
 13
 12
 11
 10
 9
 7
 6

18
 19
 20
 21
 22
 23
 24

1
 2
 3
 4

77

14

205.10

0.14 A.

36.14

28.21

28.21

