




PARENT PARCEL: 03-00-058-101-042 & -043

CHILD PARCEL: --SAME--

STARTING POINT: CENTERLINE OF COLORADO AVE. & ROOT RD.

09-01906-C

AC. CORR PER SURVEY
TAKE SHOULD HAVE GONE
TO CENTERLINE OF ROAD

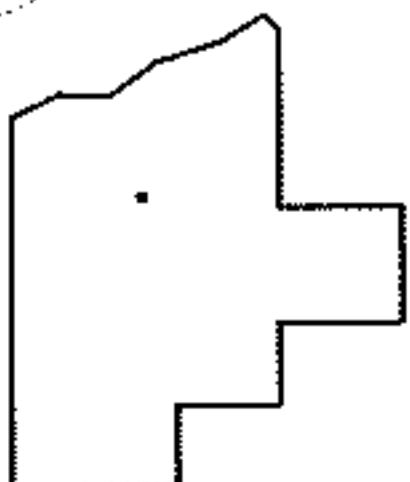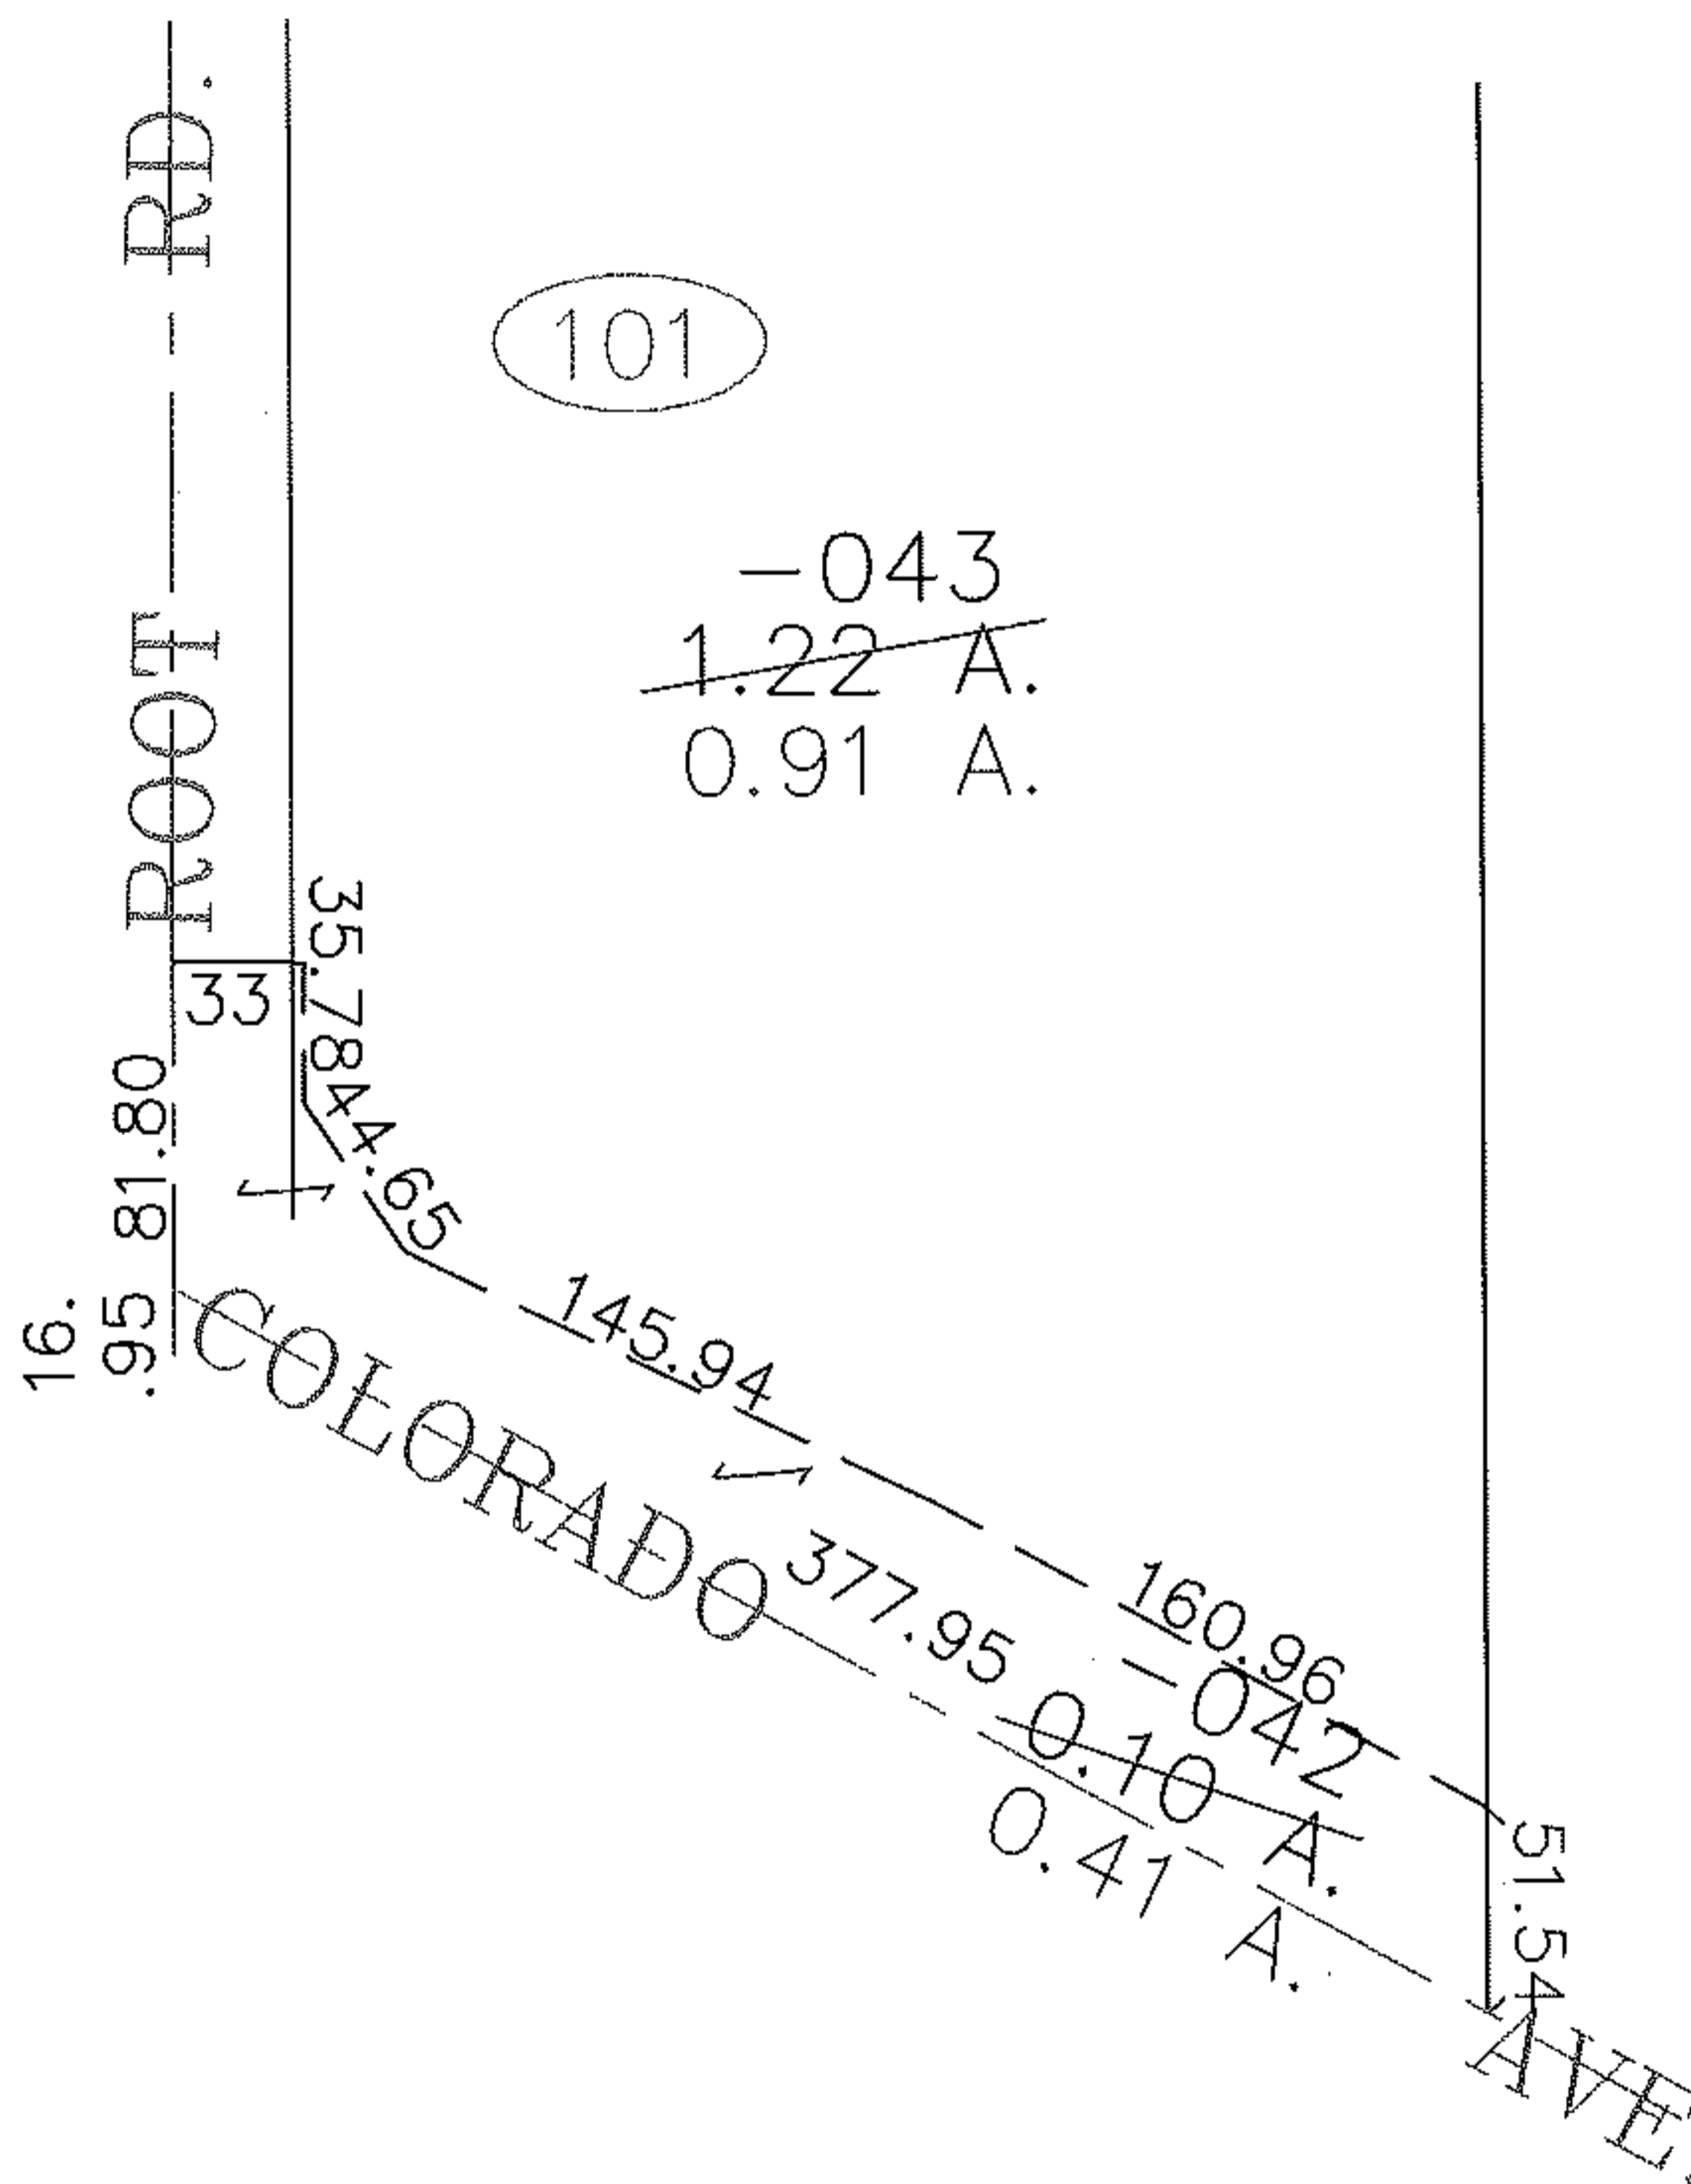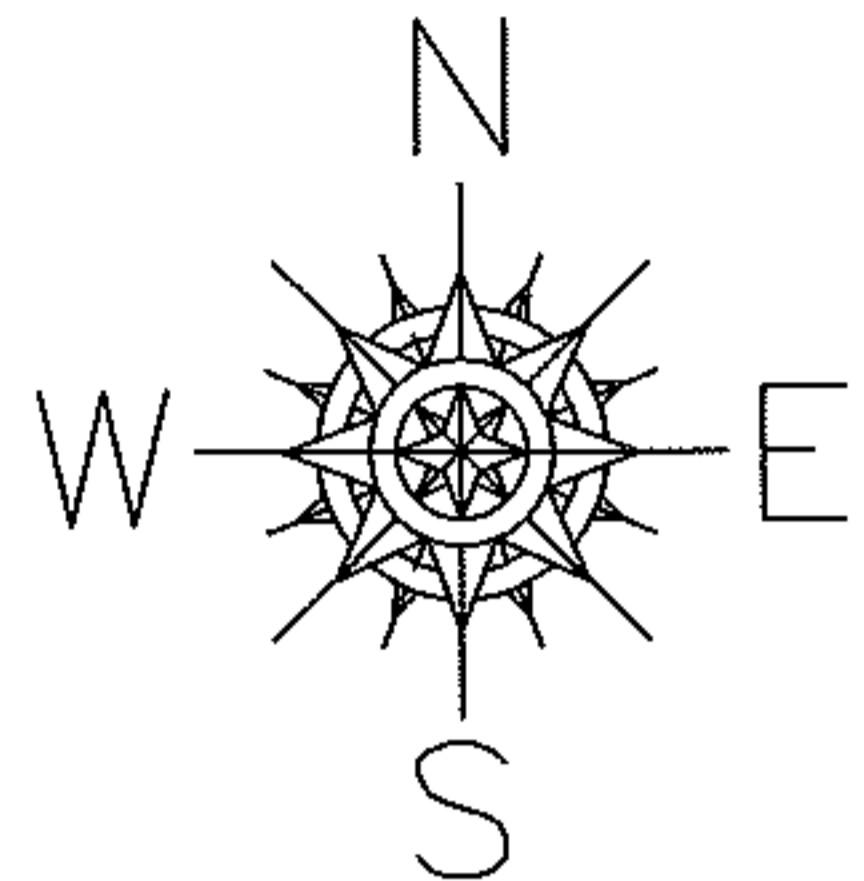

SPLITS/DEEDS PROCESSED

LORAIN COUNTY TAX MAP DEPARTMENT
226 MIDDLE AVE. ELYRIA, OHIO

SURVEYED BY: BRIAN P. MCCARTNEY
CLOSURE: 0.00 : 10,000
MAP PAGE(S): 3-00-058-A
APPROVED BY: DRH DATE: 10/20/2009
SCALE: 1" = 100 PRIOR INSTRUMENT: 20000673369