
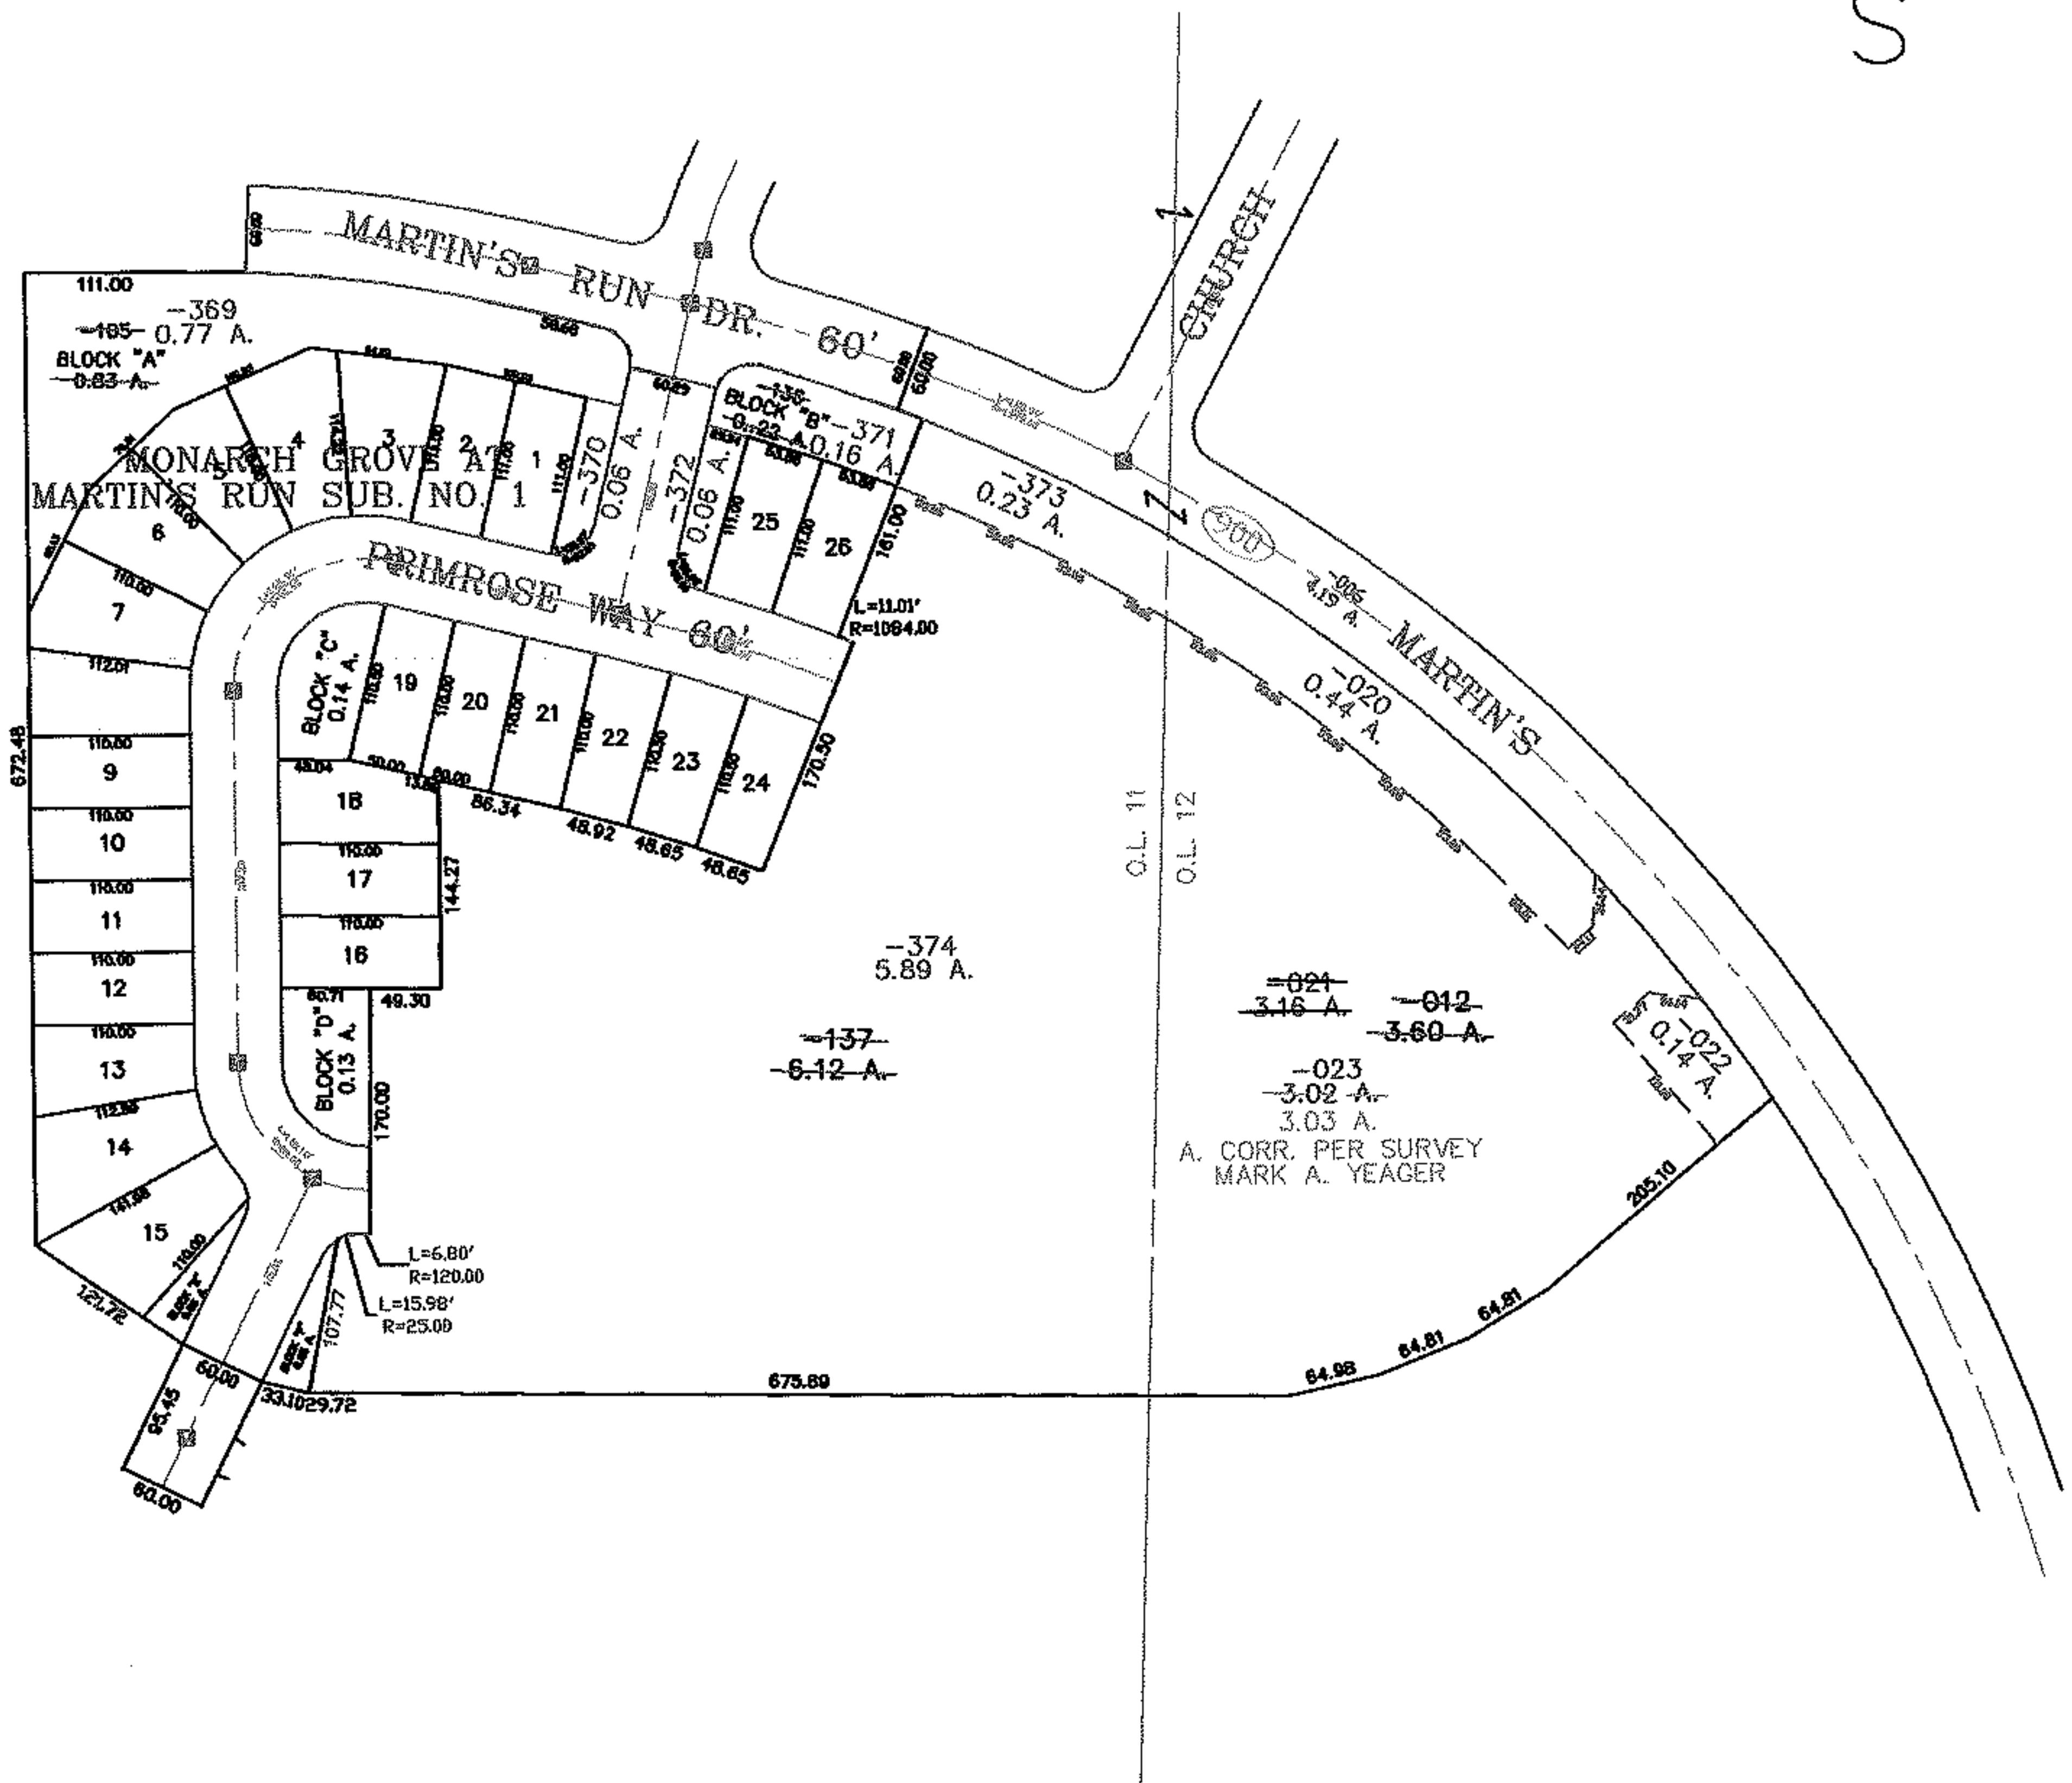



RASTER

PARENT PARCEL: 02-02-011-000-105, 136, -137 02-02-012-101-012  
CHILD PARCEL: 02-02-011-000-369 THRU -374 02-02-012-101-020 THRU -023  
STARTING POINT: CENTERLINE OF MARTIN'S RUN DR. & JONES DR.

NO. 01906

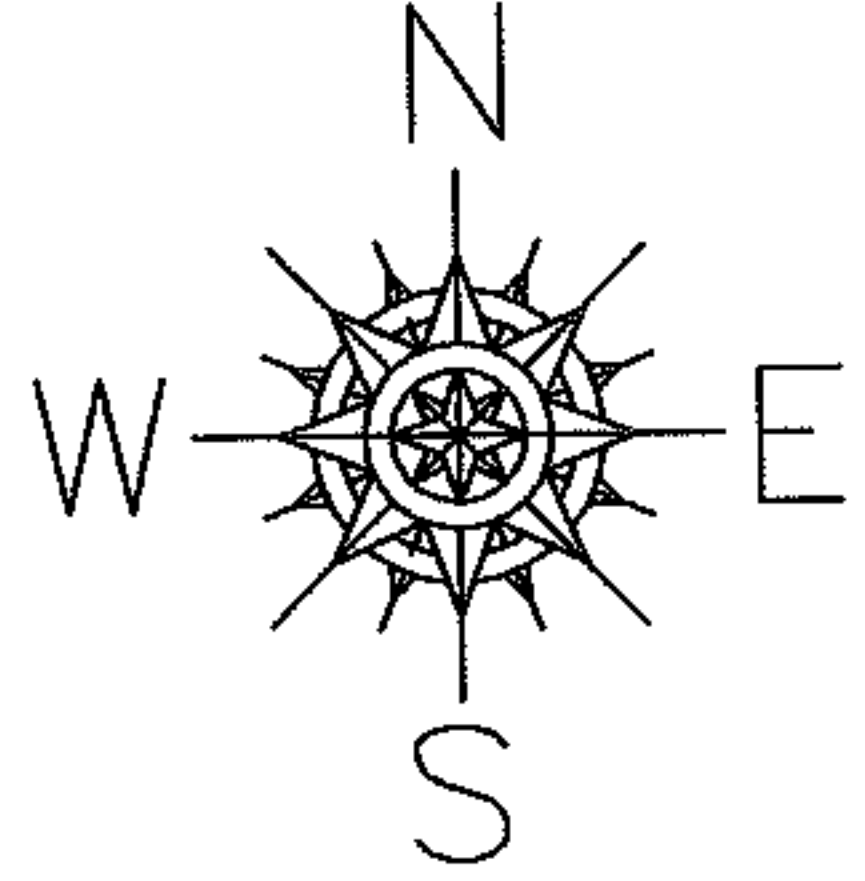

-021  
3.16 A.  
-012  
3.60 A.  
-023  
3.02 A.  
3.03 A.  
A. CORR. PER SURVEY  
MARK A. YEAGER

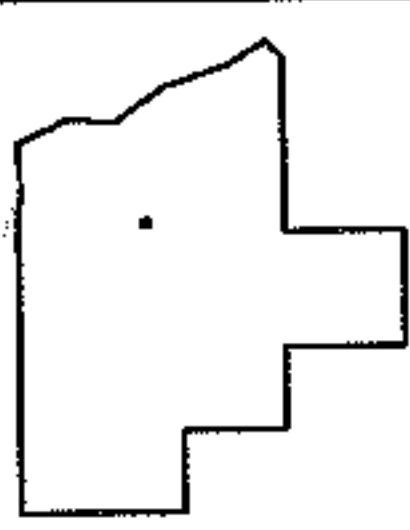

**SPLITS/DEEDS PROCESSED**  
LORAIN COUNTY TAX MAP DEPARTMENT  
226 MIDDLE AVE. ELYRIA, OHIO

SURVEYED BY: MARK A. YEAGER  
CLOSURE: 0.00 : 10.000  
MAP PAGE(S): 02-02-011-A  
APPROVED BY: JAH DATE: 5-4-05  
SCALE: 1" = 200 PRIOR INSTRUMENT: 20020871246