



PARENT PARCEL: 06-25-001-000-076

CHILD PARCEL: --SAME--


STARTING POINT: S/L 1 SUGARLANE INDUSTRIAL PARK V 36 P 15

09-01908-C

FRONTAGE CORRECTION PER DEEDS

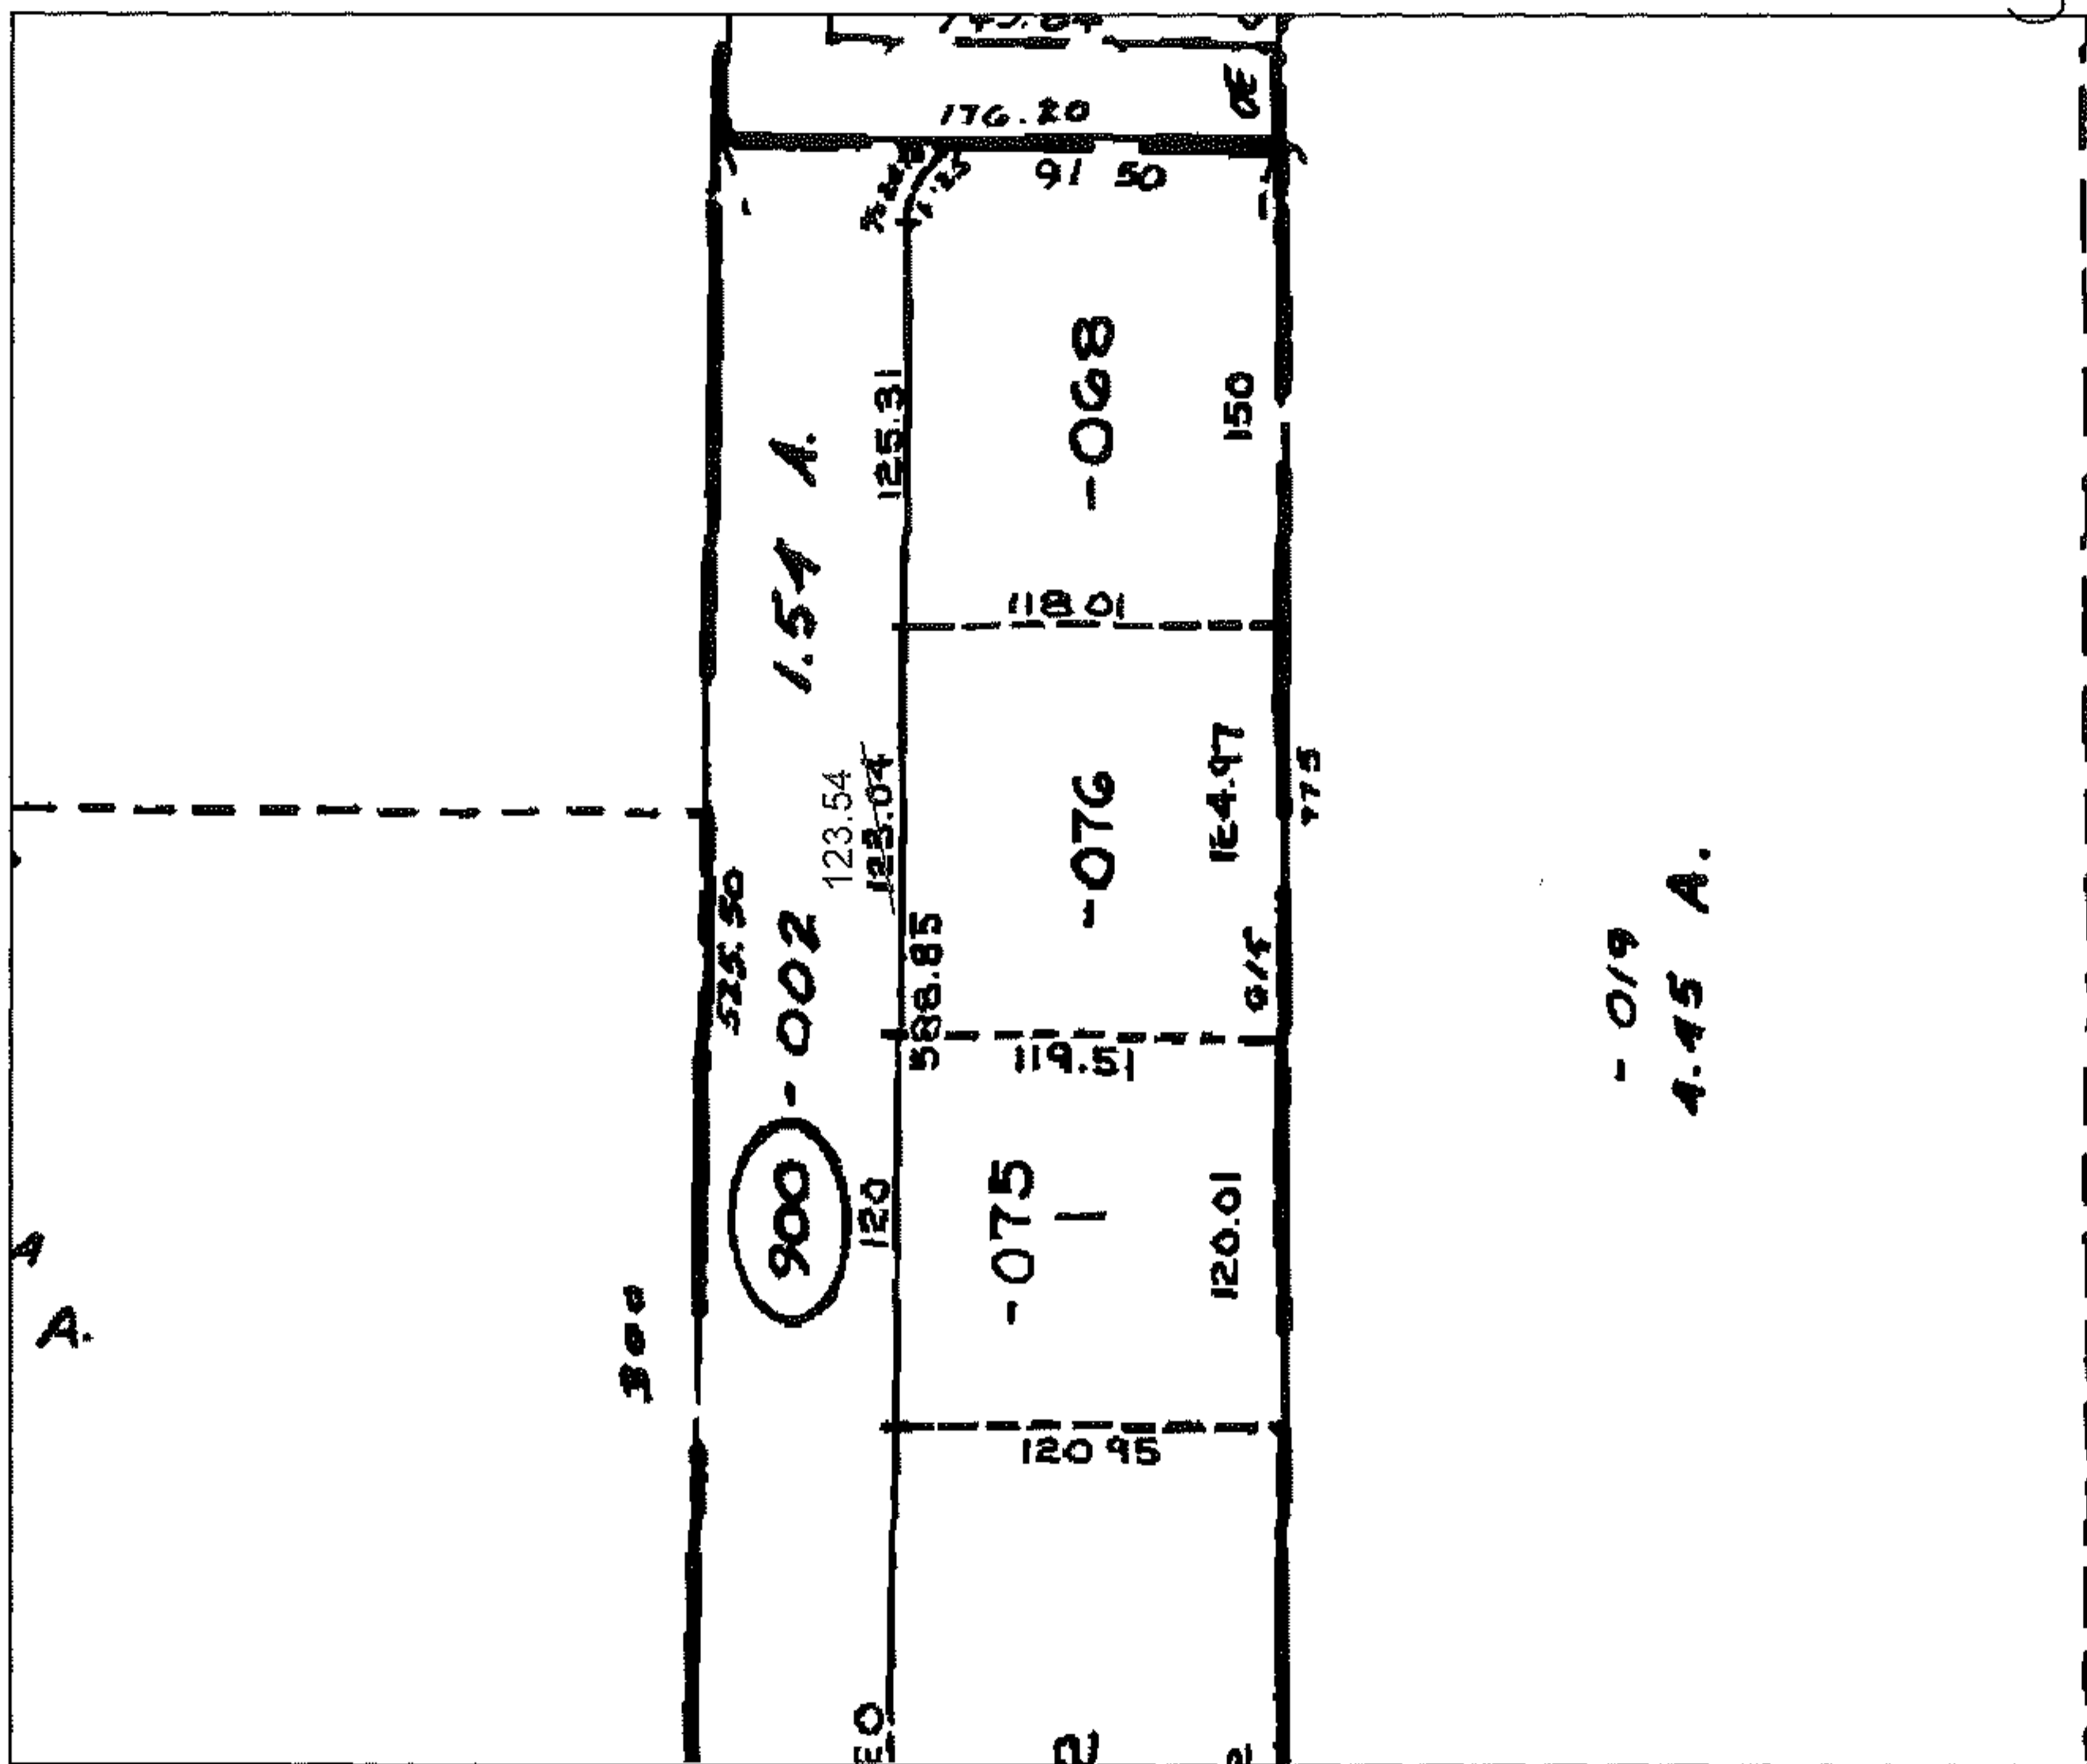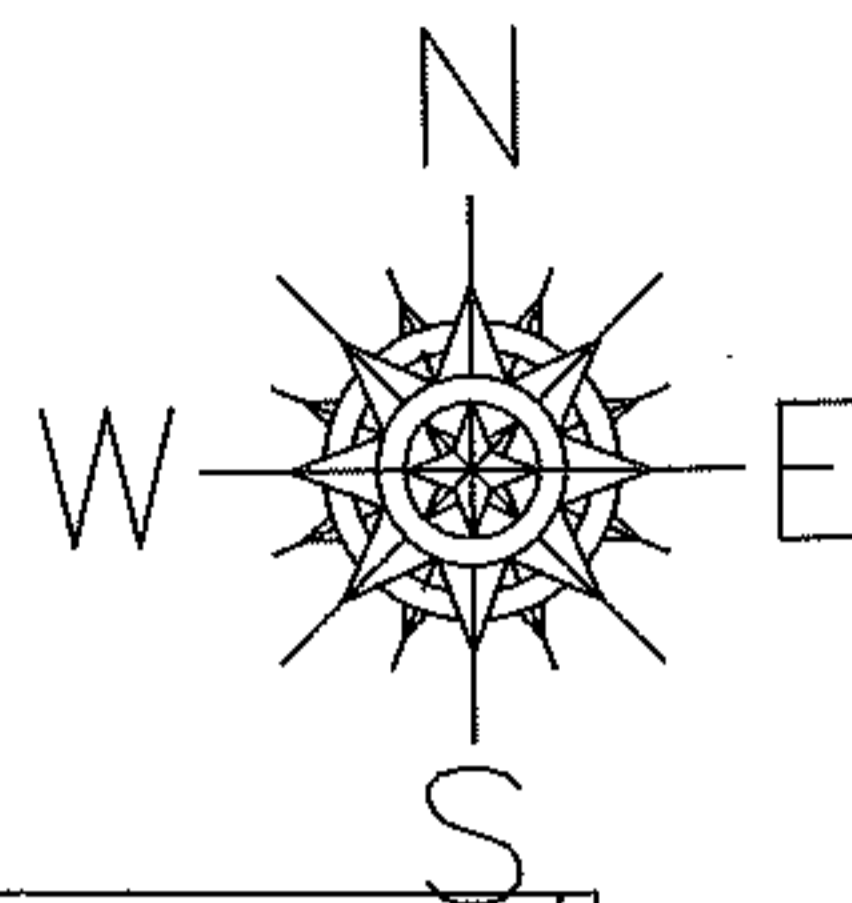

- 019
4.45 A.

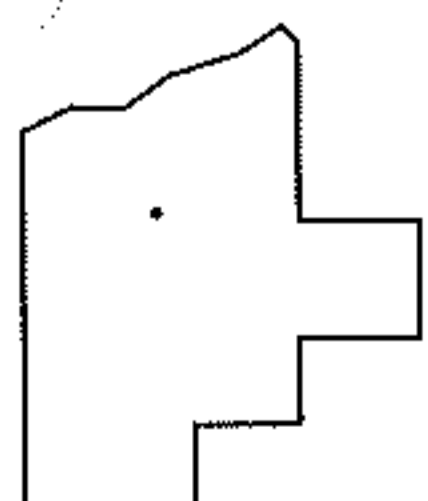

SPLITS/DEEDS PROCESSED

LORAIN COUNTY TAX MAP DEPARTMENT
226 MIDDLE AVE. ELYRIA, OHIO

SURVEYED BY: N/A

CLOSURE: N/A

MAP PAGE(S): 06-144

APPROVED BY: DRH DATE: 10/23/2009

SCALE: NOT TO SCALE PRIOR INST.: 20040044879