




FASTER

PARENT PARCEL: 05-00-017-000-163, 05-00-024-116-018, -019

CHILD PARCEL: 05-00-017-000-242 THRU -244 05-00-024-116-030, -031

STARTING POINT: CENTERLINE OF S. MAIN ST. & ELYRIA RD.

NO. 01908

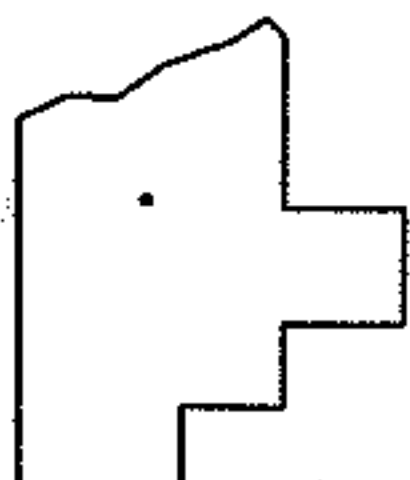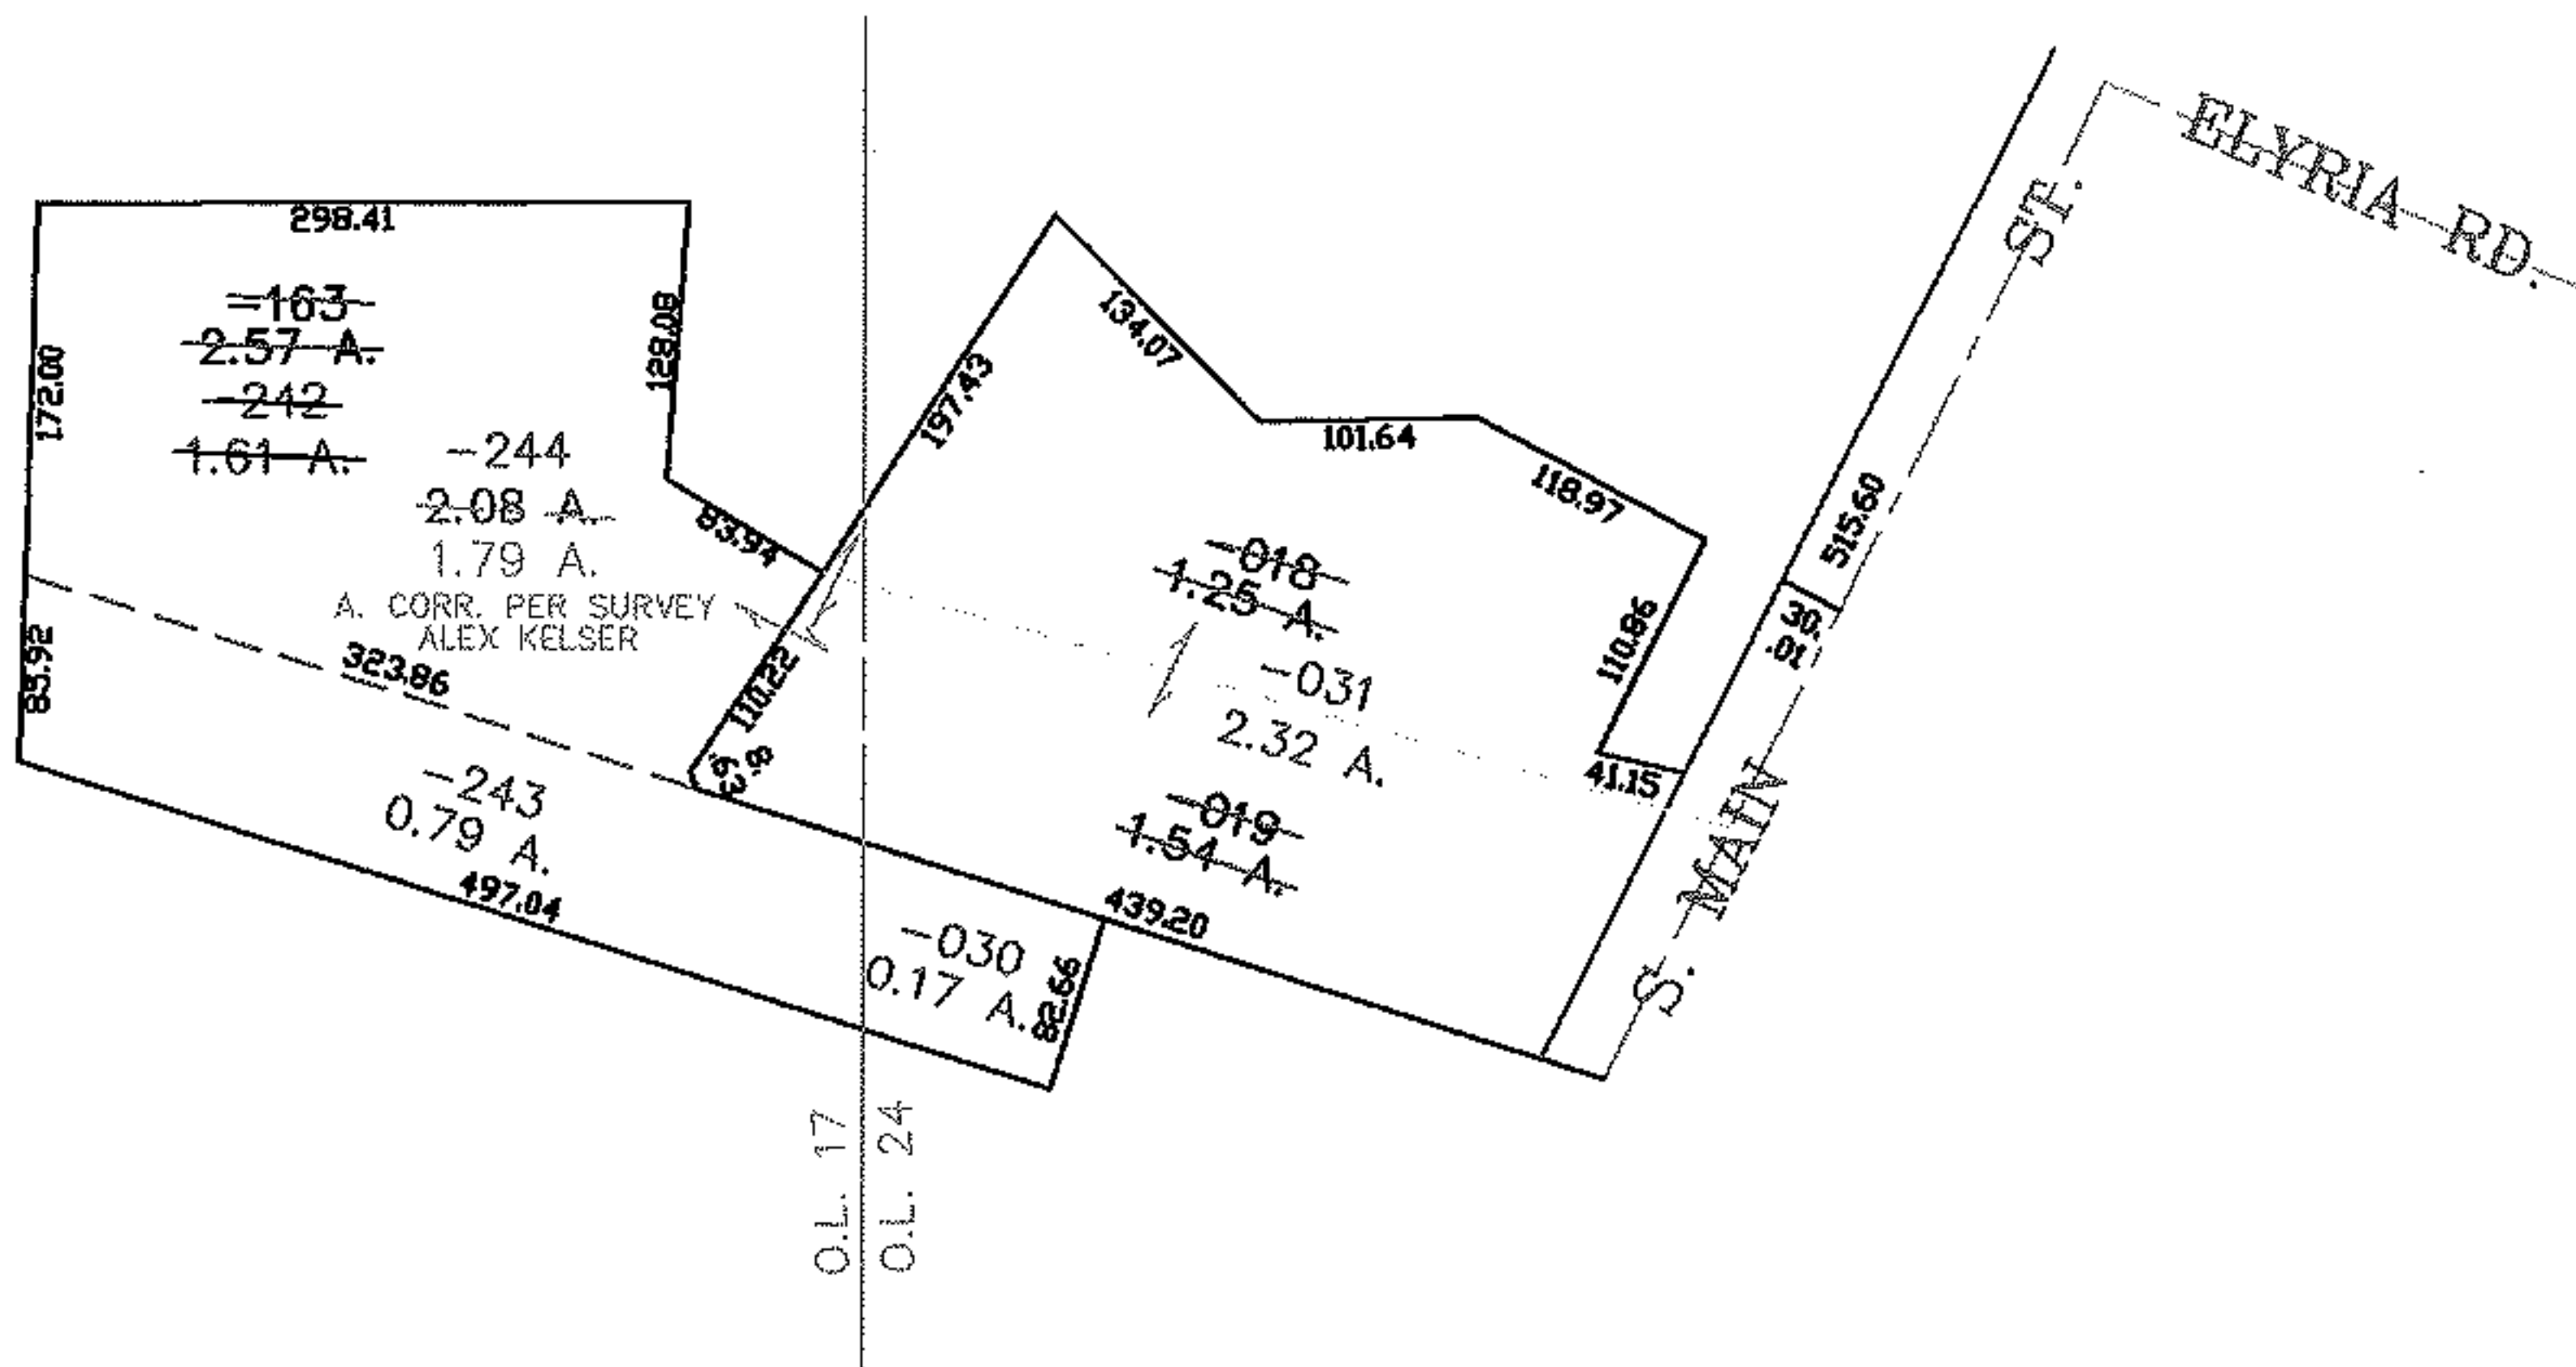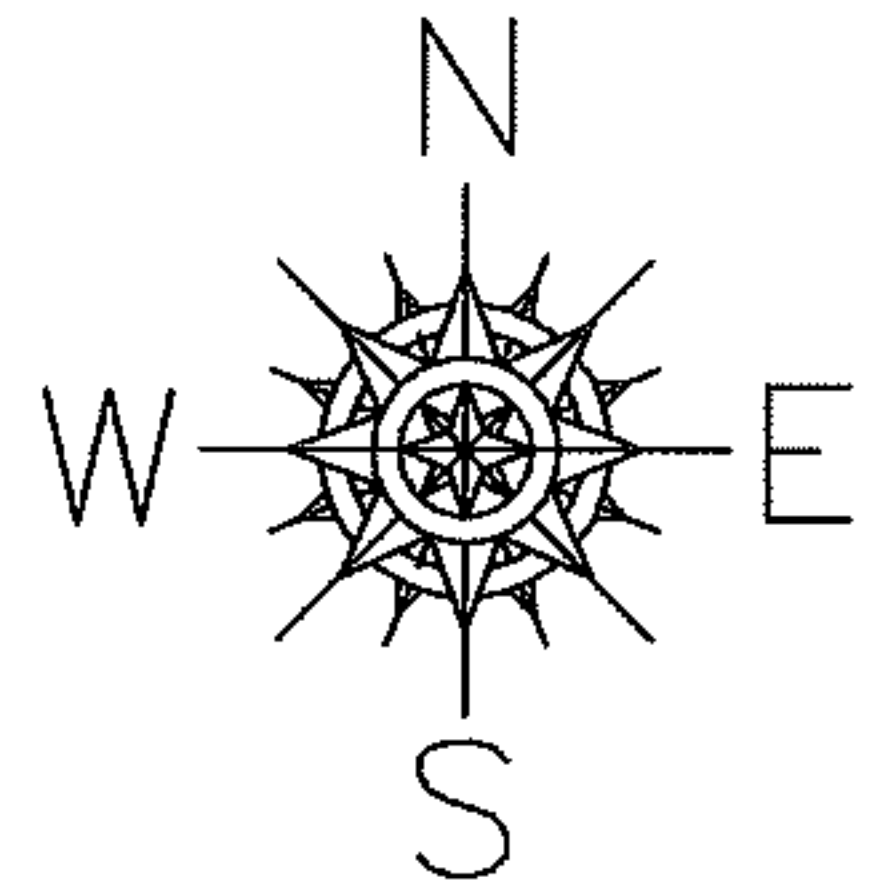

SPLITS/DEEDS PROCESSED

LORAIN COUNTY TAX MAP DEPARTMENT
226 MIDDLE AVE. ELYRIA, OHIO

SURVEYED BY: ALEX KELSER

CLOSURE: 0.00 : 10,000

MAP PAGE(S): 05-00-024-A, 05-00-017-B

APPROVED BY: JAH DATE: 5-9-05

SCALE: 1" = 200 PRIOR INSTRUMENT: 19980580959