



MASTER

PARENT PARCEL: 03-00-012-000-165


CHILD PARCEL: 03-00-012-000-180 & -181

STARTING POINT: INT CL ABBE RD AND CL NORTH RIDGE RD

NO. 01910

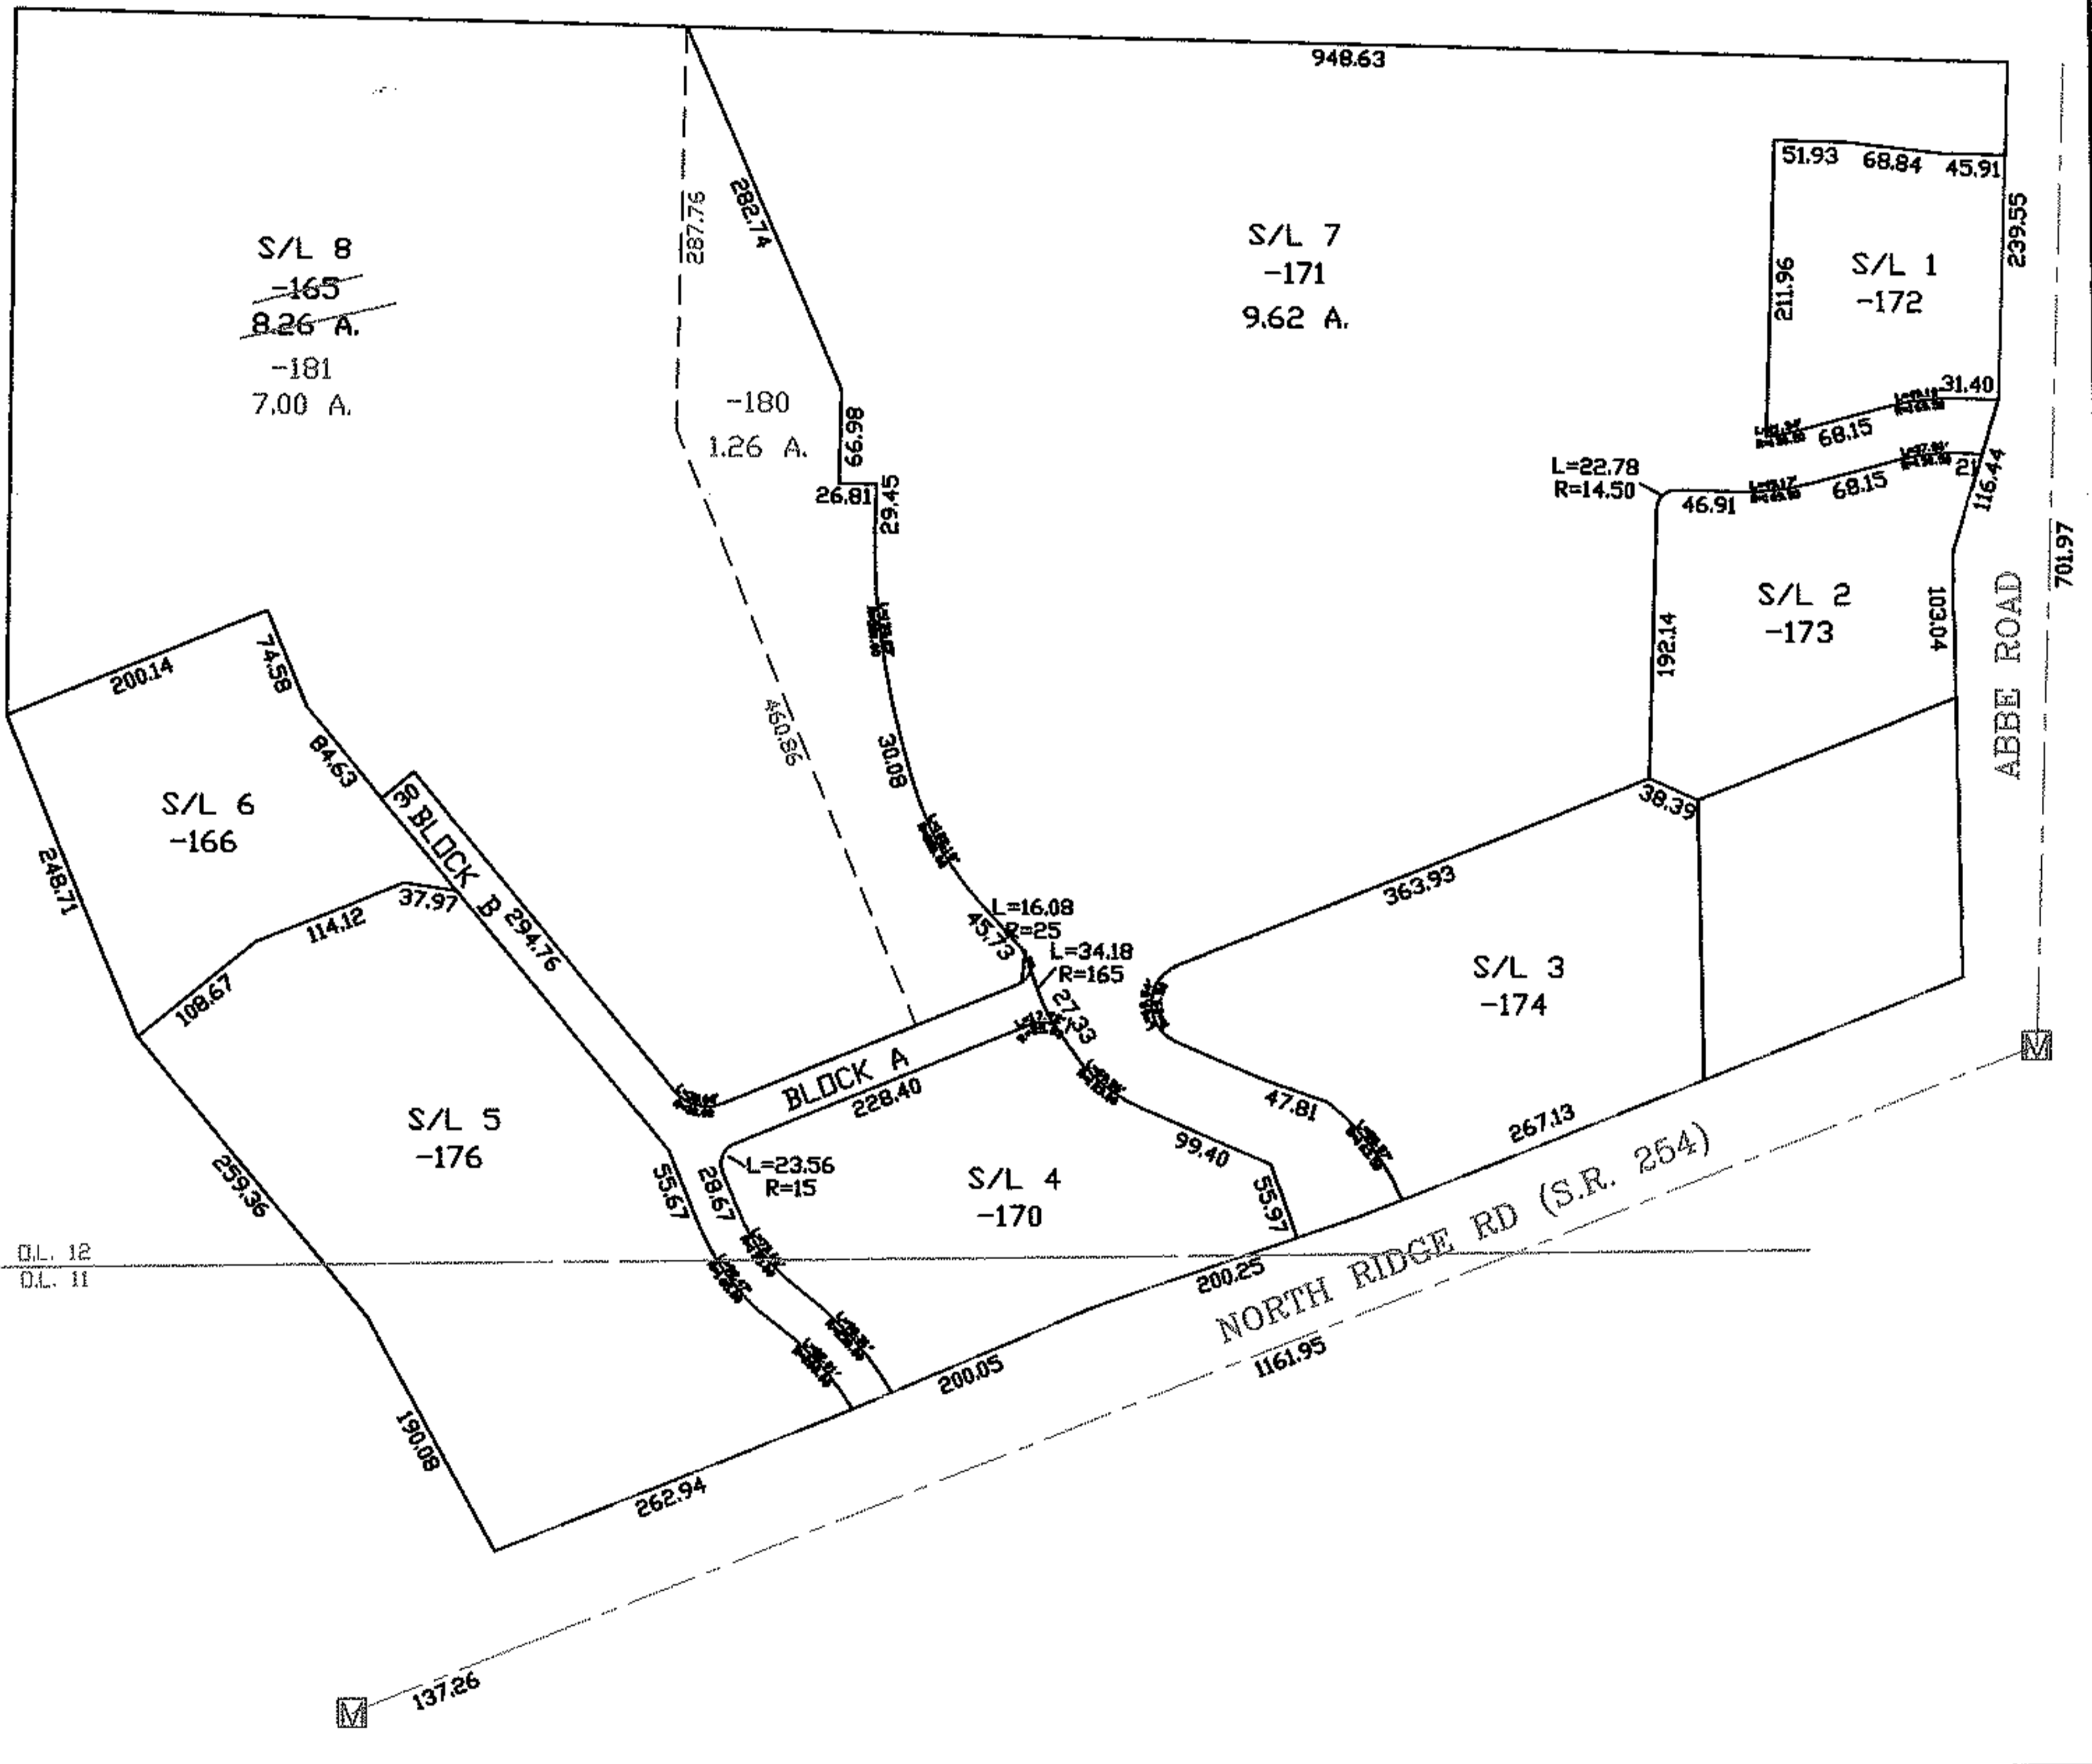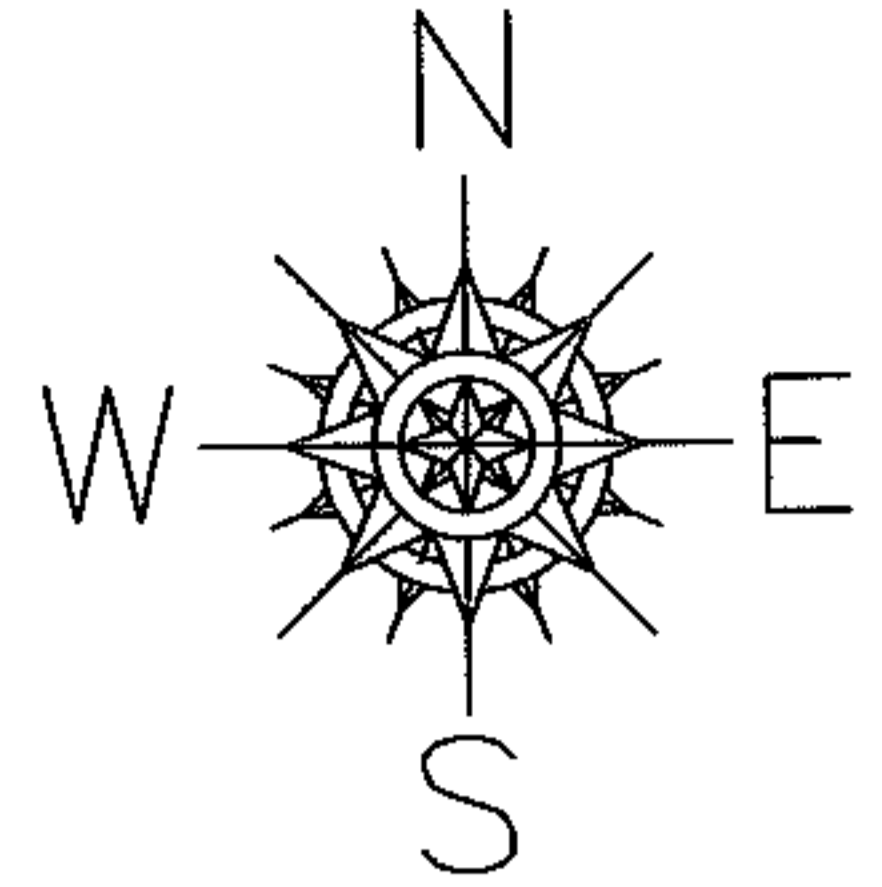

O.L. 12  
O.L. 11

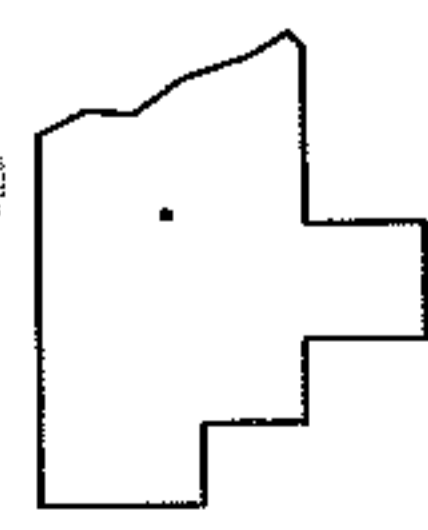

**SPLITS/DEEDS PROCESSED**  
LORAIN COUNTY TAX MAP DEPARTMENT  
226 MIDDLE AVE. ELYRIA, OHIO

SURVEYED BY: CHRISTOPHER HIRZEL  
CLOSURE: 1:10,000  
MAP PAGE(S): 03-00-012-B  
APPROVED BY: DRH DATE: 5/3/2005  
SCALE: 1" = 200' PRIOR INSTRUMENT: OR 1310/887