



RASTER

PARENT PARCEL: 04-00-003-101-081

CHILD PARCEL: 04-00-003-101-369, -370

STARTING POINT: CENTERLINE OF FRENCH CREEK RD. & SW CORNER OF FRENCH CREEK EST. SUBD.

NO. 01913

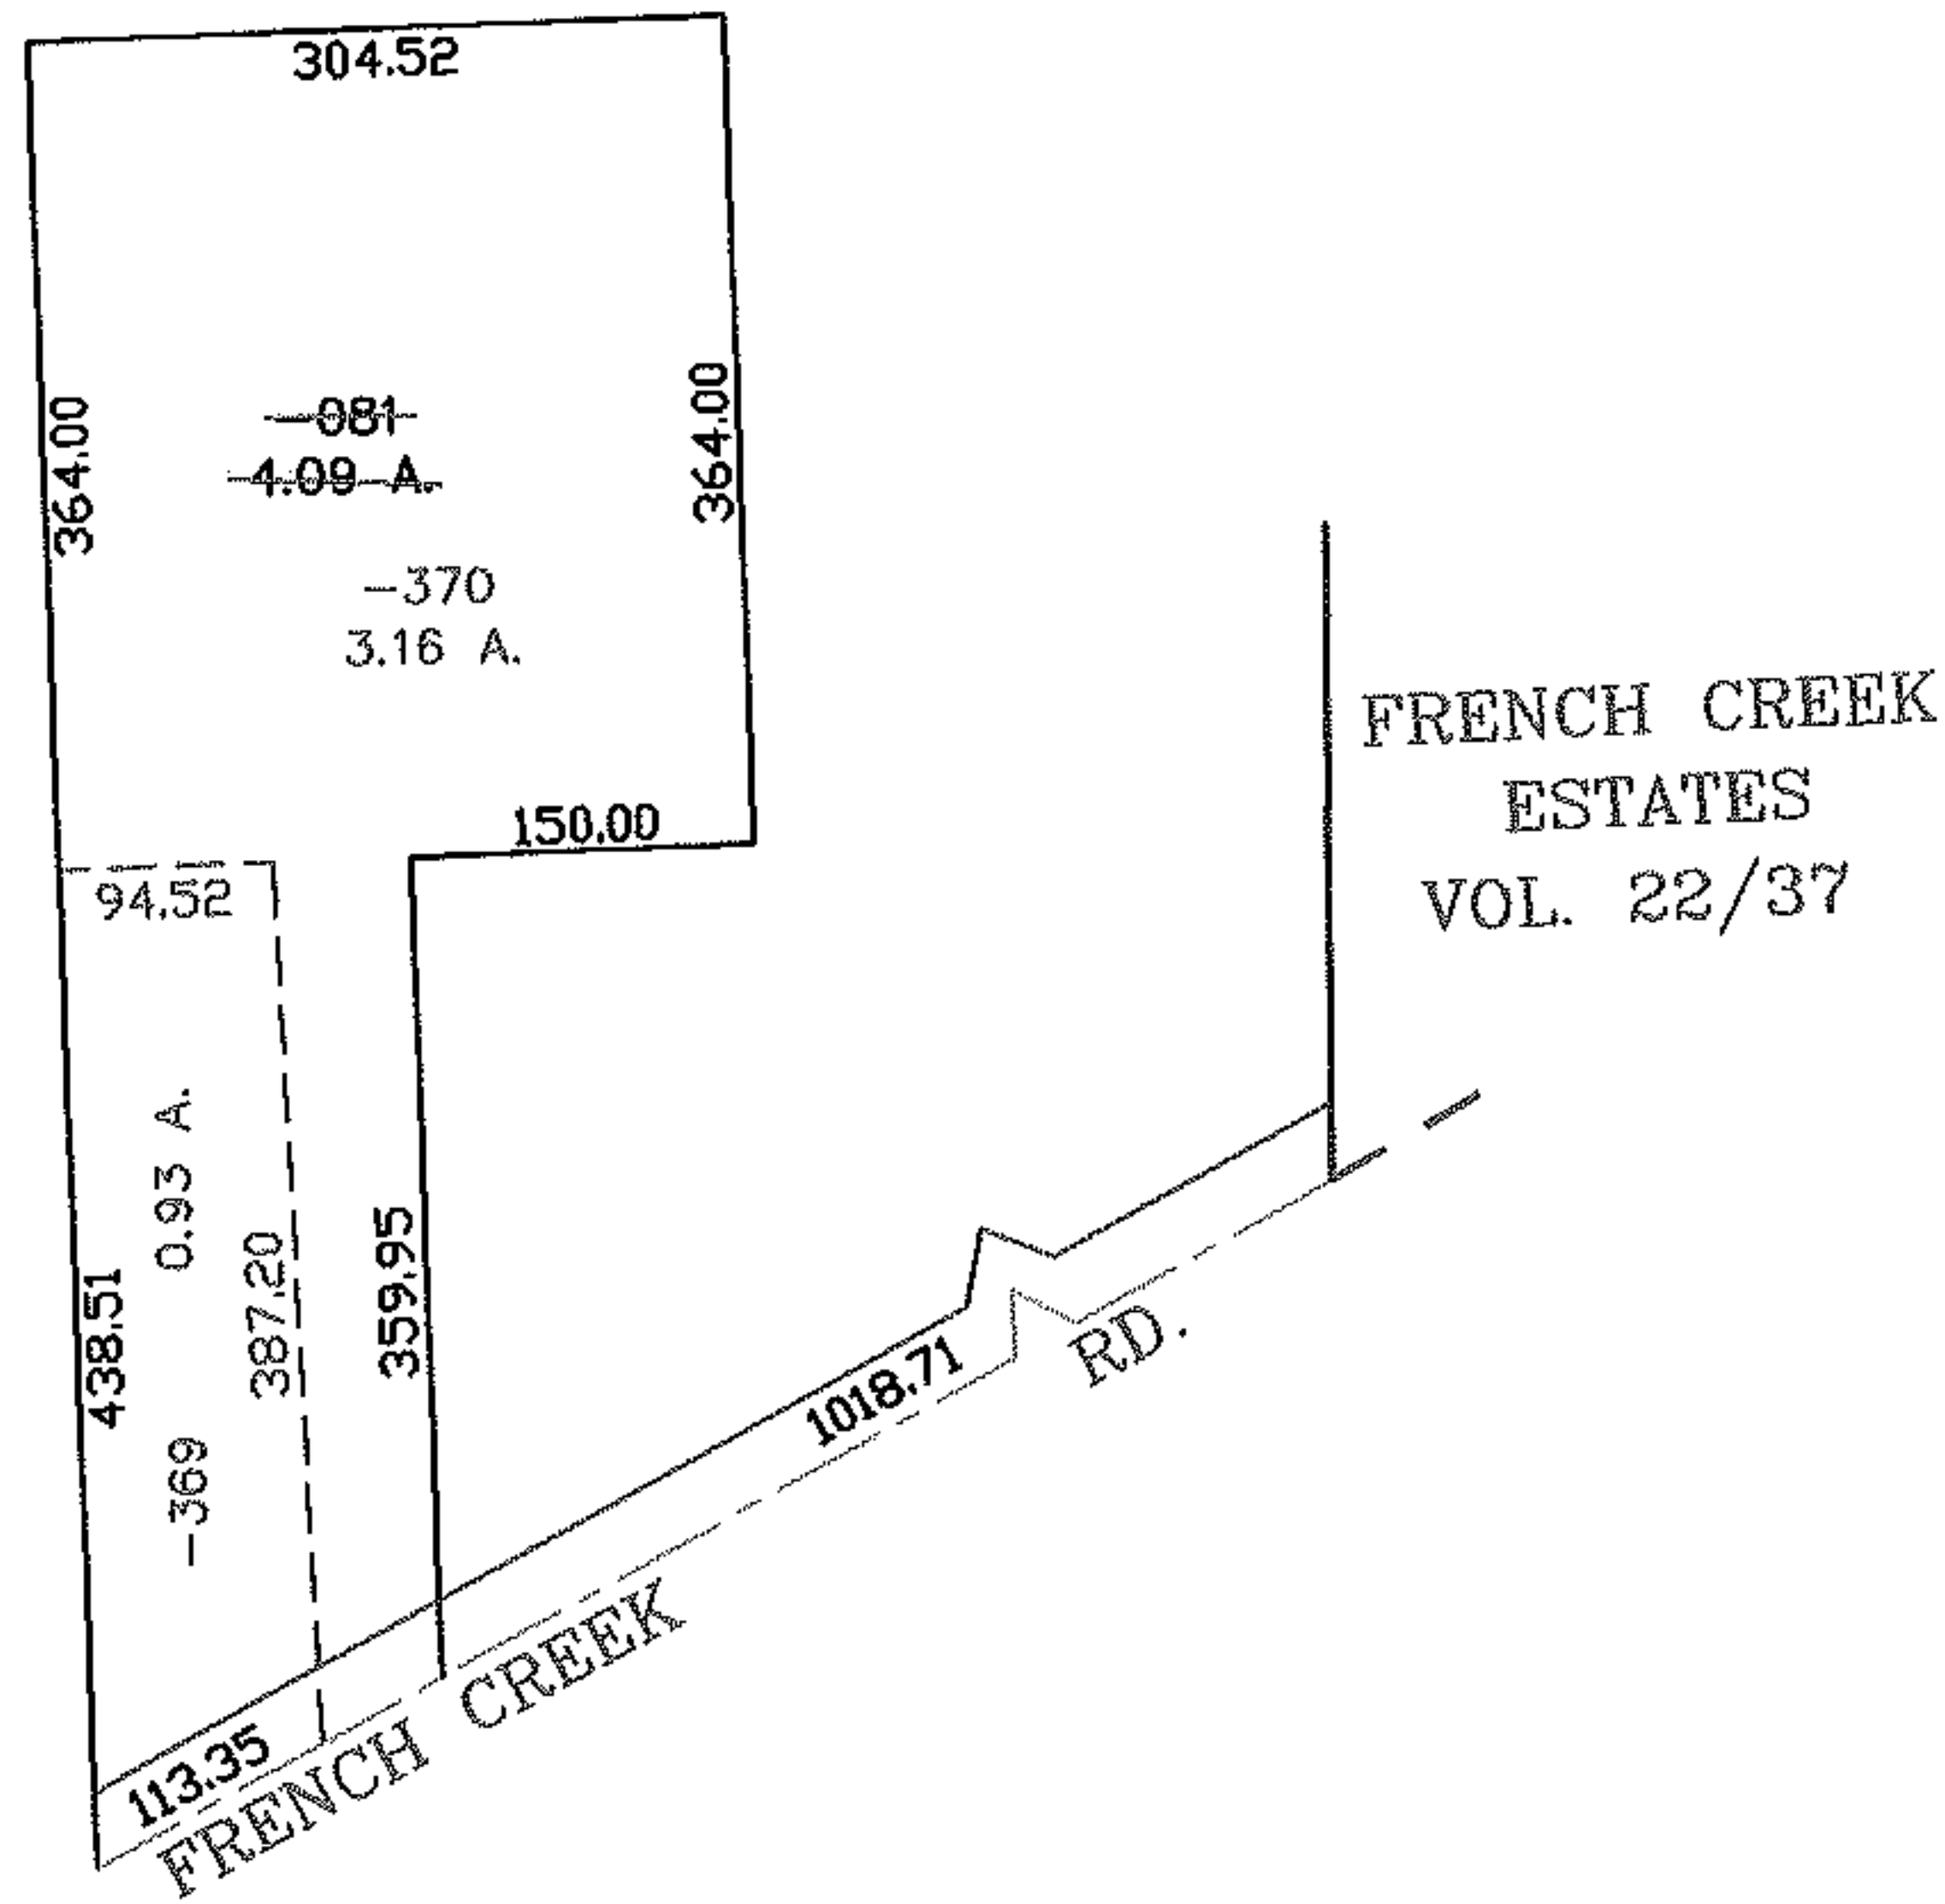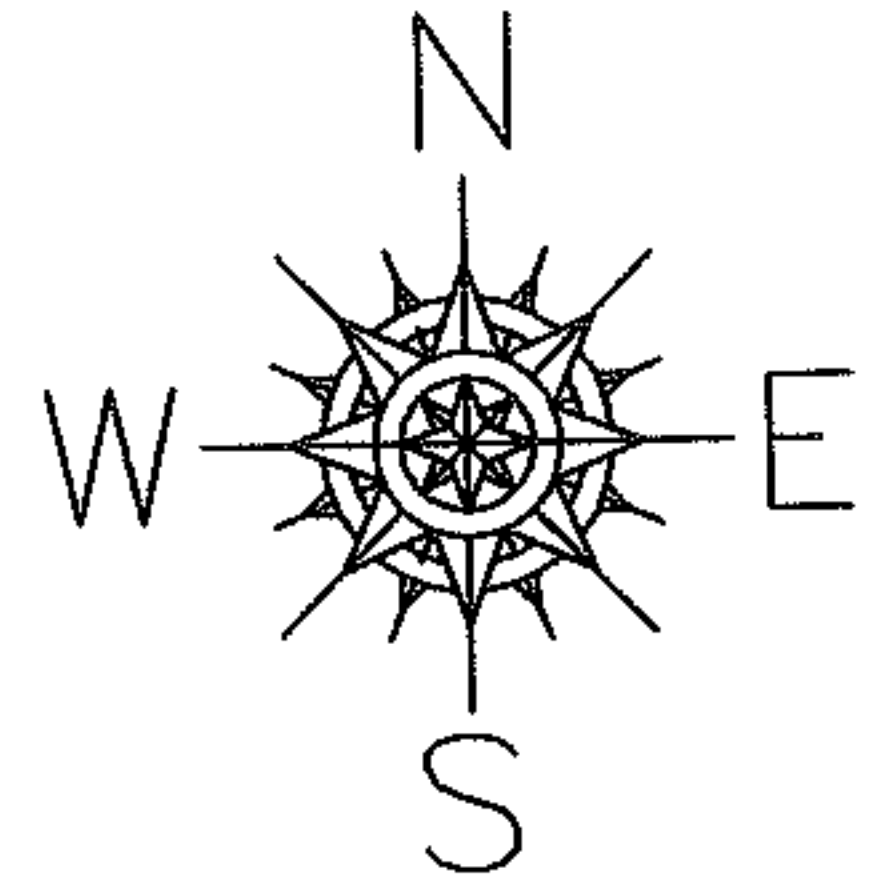

FRENCH CREEK  
ESTATES  
VOL. 22/37



**SPLITS/DEEDS PROCESSED**  
LORAIN COUNTY TAX MAP DEPARTMENT  
226 MIDDLE AVE. ELYRIA, OHIO

SURVEYED BY:	DOUG MOSLEY
CLOSURE:	0.00 : 10.000
MAP PAGE(S):	04-00-003-G
APPROVED BY:	JAH
DATE:	5-11-05
SCALE:	1" = 200
PRIOR INSTRUMENT:	2004033446